

MOKLER
Architects

Peter J. Mokler & Associates, Inc.
P.O. Box 14 San Pedro, CA 90733
818.317.2337 www.mokarc.com

Consultants

Client
COHN RESIDENCE
57 VIA DEL CIELO
RANCHO PALOS VERDES, CA
90275-2511
(310) 505-7001 PHONE
hproperties@yahoo.com EMAIL

Project
COHN RESIDENCE
57 VIA DEL CIELO
RANCHO PALOS VERDES, CA
90275-2511
APN 7582-022-045
LEGAL - TRACT 46628 LOT 23

00.00.22	1ST SUBMITTAL
00.00.00	DELTA 1 REVISIONS



	Drawn	PJM
	Reviewed	
	Date	00.00.00
	Scale	

Copyright Notice
Copyright © 2022 by Peter J. Mokler & Associates, Inc.
All Rights Reserved.
THE ARCHITECT, PETER J. MOKLER AND ASSOCIATES, INC. (PJA) MOKLER ARCHITECTS RESERVES ITS COMMON LAW COPYRIGHT AND OTHER PROPERTY RIGHTS IN THESE PLANS, IDEAS AND DESIGNS WHICH ARE NOT TO BE REPRODUCED, CHANGED, OR COPIED IN ANY FORM OR MANNER WHATSOEVER, NOR ARE THEY TO BE ASSIGNED TO ANY THIRD PARTY WITHOUT FIRST OBTAINING EXPRESS WRITTEN PERMISSION FROM PJA.
THESE DRAWINGS ARE FOR THE SPECIFIC PROJECT EXCLUSIVELY AND ARE NOT FINAL, NOR TO BE USED FOR CONSTRUCTION UNLESS BONDED BY THE ARCHITECT OF RECORD.


Sheet Name
**AS-BUILT
UPPER
FLOOR PLAN**

Project No.
2022-003 COHN VIA CIELO

	Drawing No.	A-101

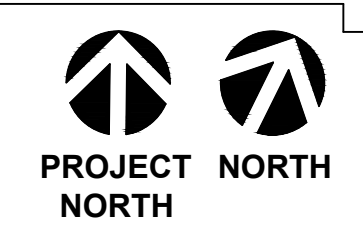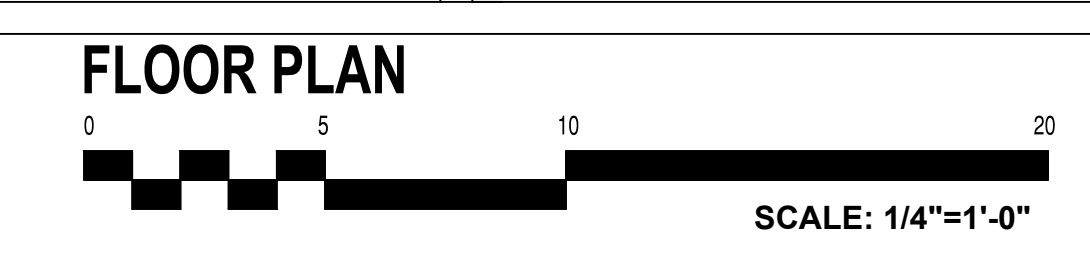

Consultants

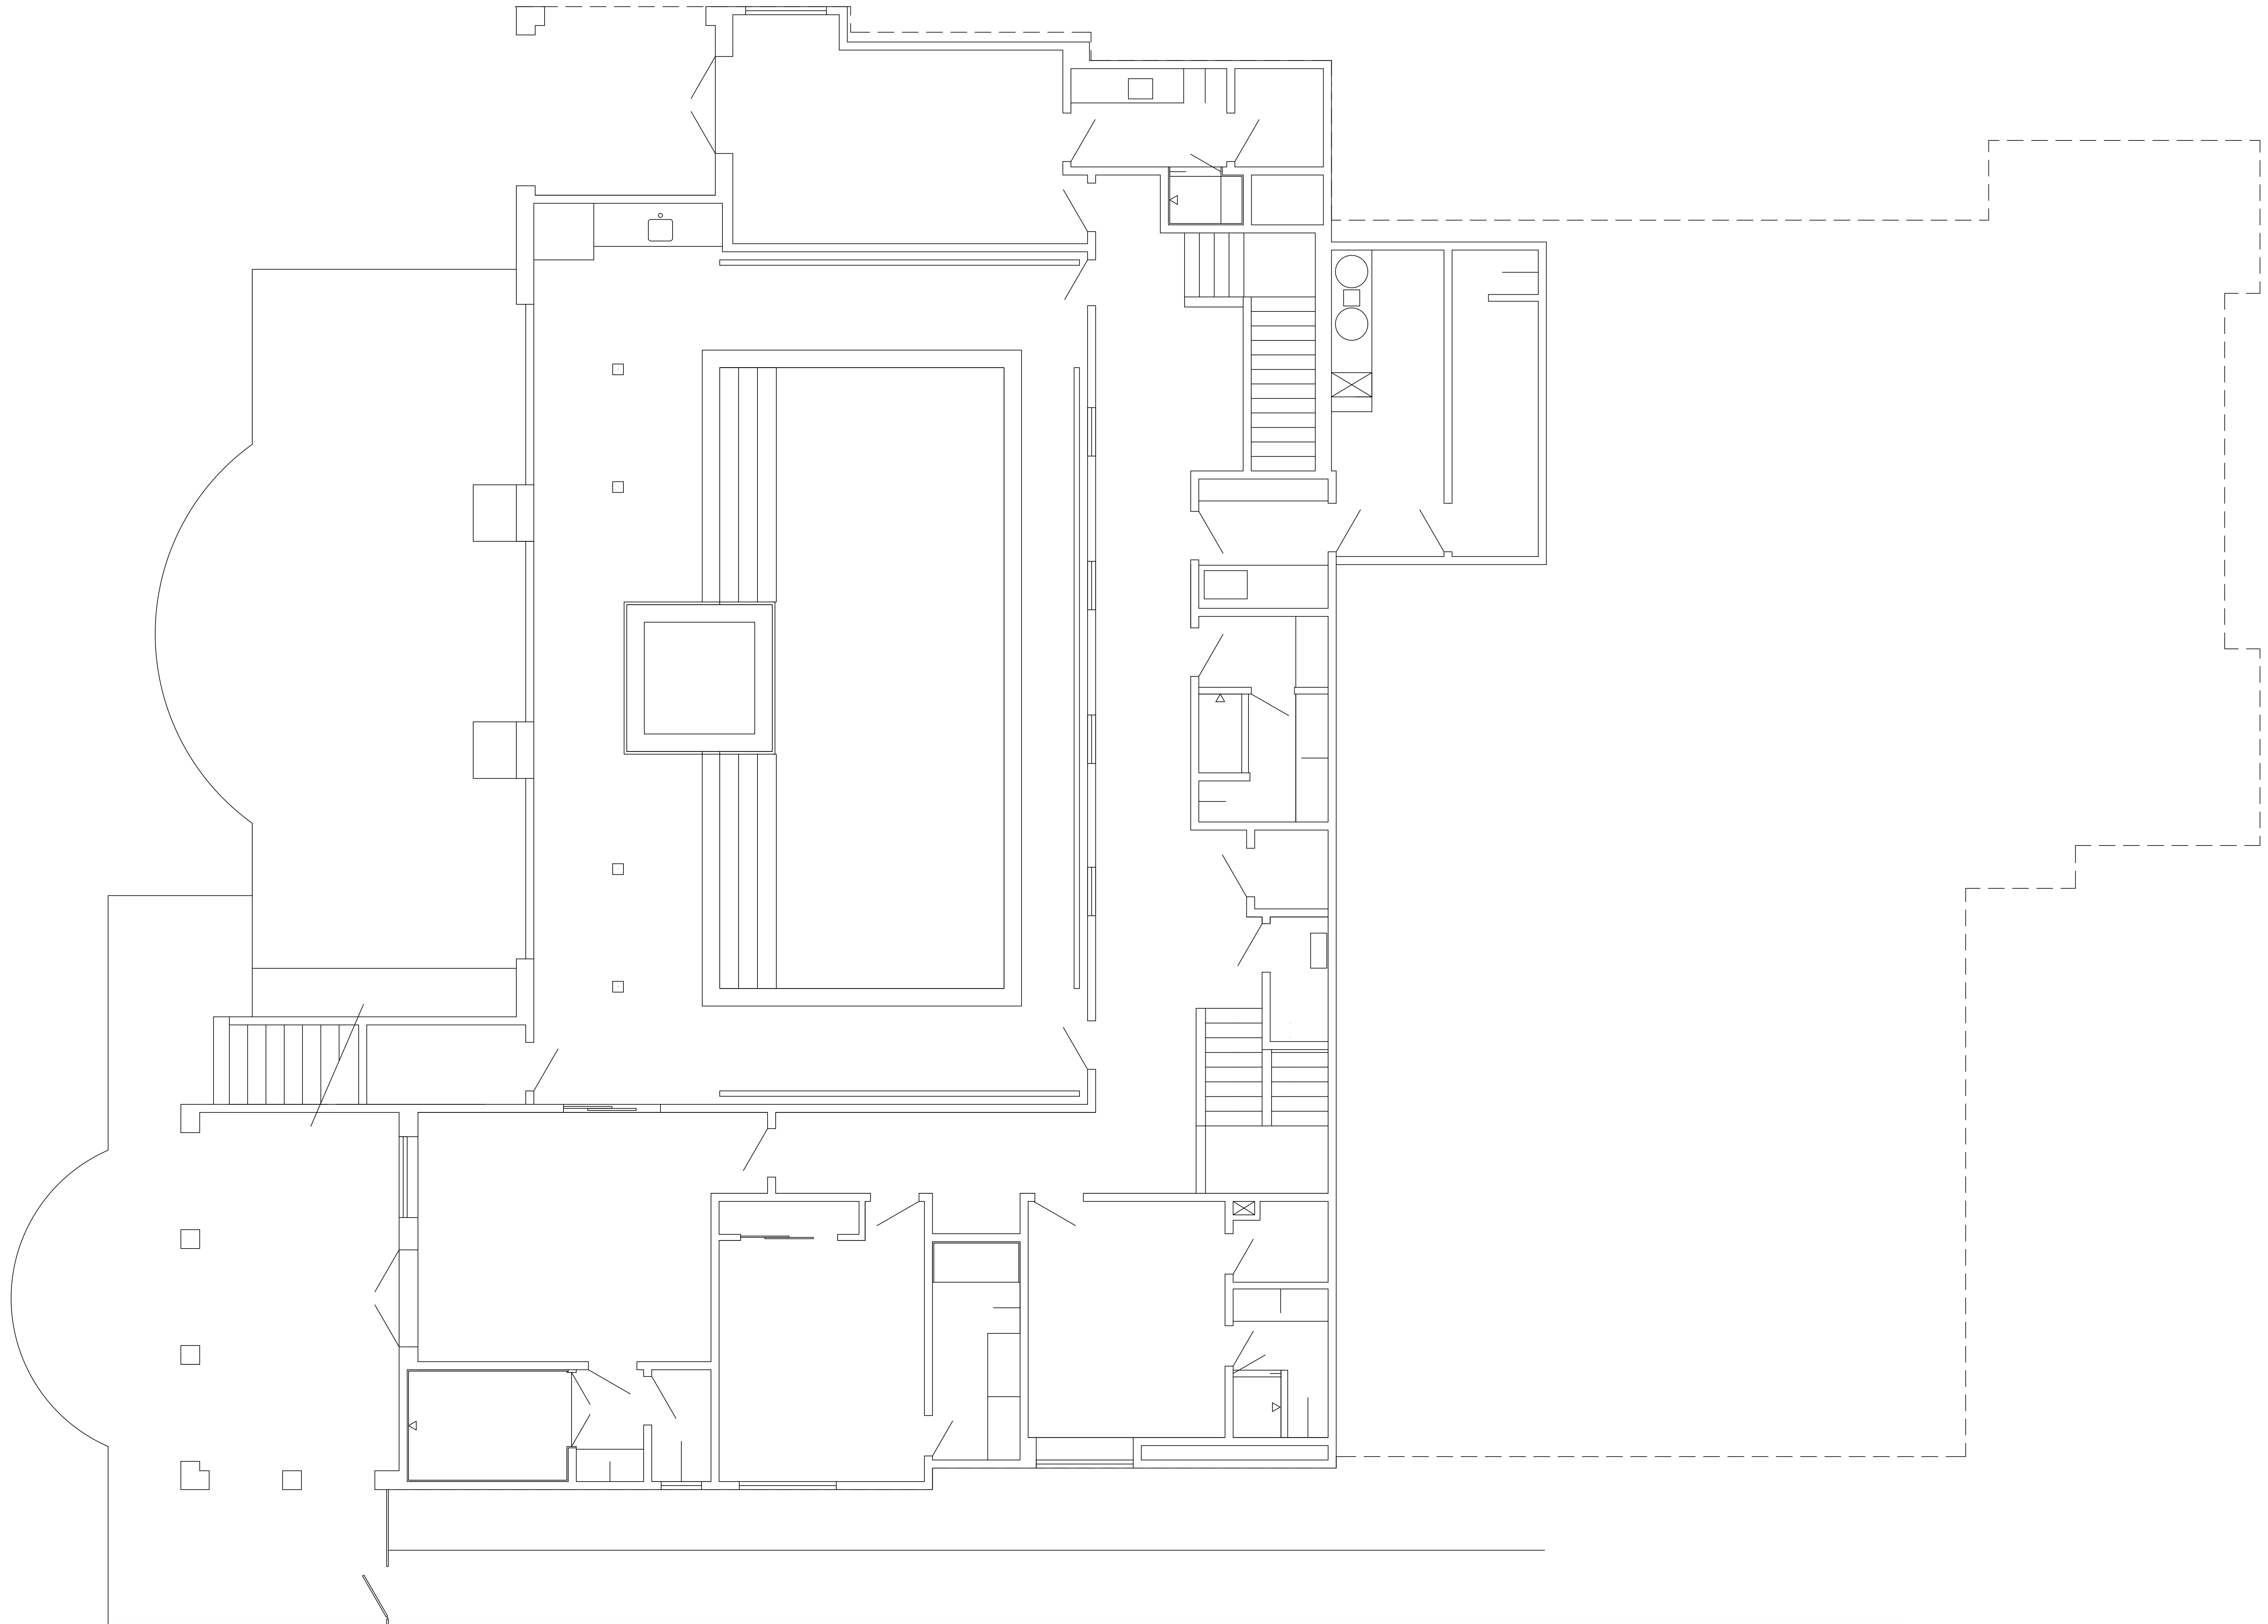

Client
COHN RESIDENCE
57 VIA DEL CIELO
RANCHO PALOS VERDES, CA
90275-2511
(310) 505-7001 PHONE
hproperties@yahoo.com EMAIL

Project
COHN RESIDENCE
57 VIA DEL CIELO
RANCHO PALOS VERDES, CA
90275-2511
APN 7582-022-045
LEGAL - TRACT 46628 LOT 23

00.00.22	1ST SUBMITTAL
00.00.00	DELTA 1 REVISIONS

	Drawn	PJM
	Reviewed	
	Date	00.00.00
	Scale	

Copyright Notice
Copyright © 2022 by Peter J. Mokler & Associates, Inc.
All Rights Reserved.
THE ARCHITECT, PETER J. MOKLER AND ASSOCIATES, INC. (DBA MOKLER ARCHITECTS) HEREBY RESERVES ITS COMMON LAW COPYRIGHT AND OTHER PROPERTY RIGHTS IN THESE PLANS, IDEAS AND DESIGNS WHICH ARE NOT TO BE REPRODUCED, CHANGED, OR COPIED IN ANY FORM OR MANNER WHATSOEVER, NOR ARE THEY TO BE ASSIGNED TO ANY THIRD PARTY WITHOUT FIRST OBTAINING EXPRESS WRITTEN PERMISSION FROM P.J.M.
THESE DRAWINGS ARE FOR THE SPECIFIC PROJECT EXCLUSIVELY AND ARE NOT FINAL, NOR TO BE USED FOR CONSTRUCTION UNLESS BONDED BY THE ARCHITECT OF RECORD.

**AS-BUILT
LOWER
FLOOR PLAN**

Project No.
2022-003 COHN VIA CIELO

	Drawing No.	A-102

