


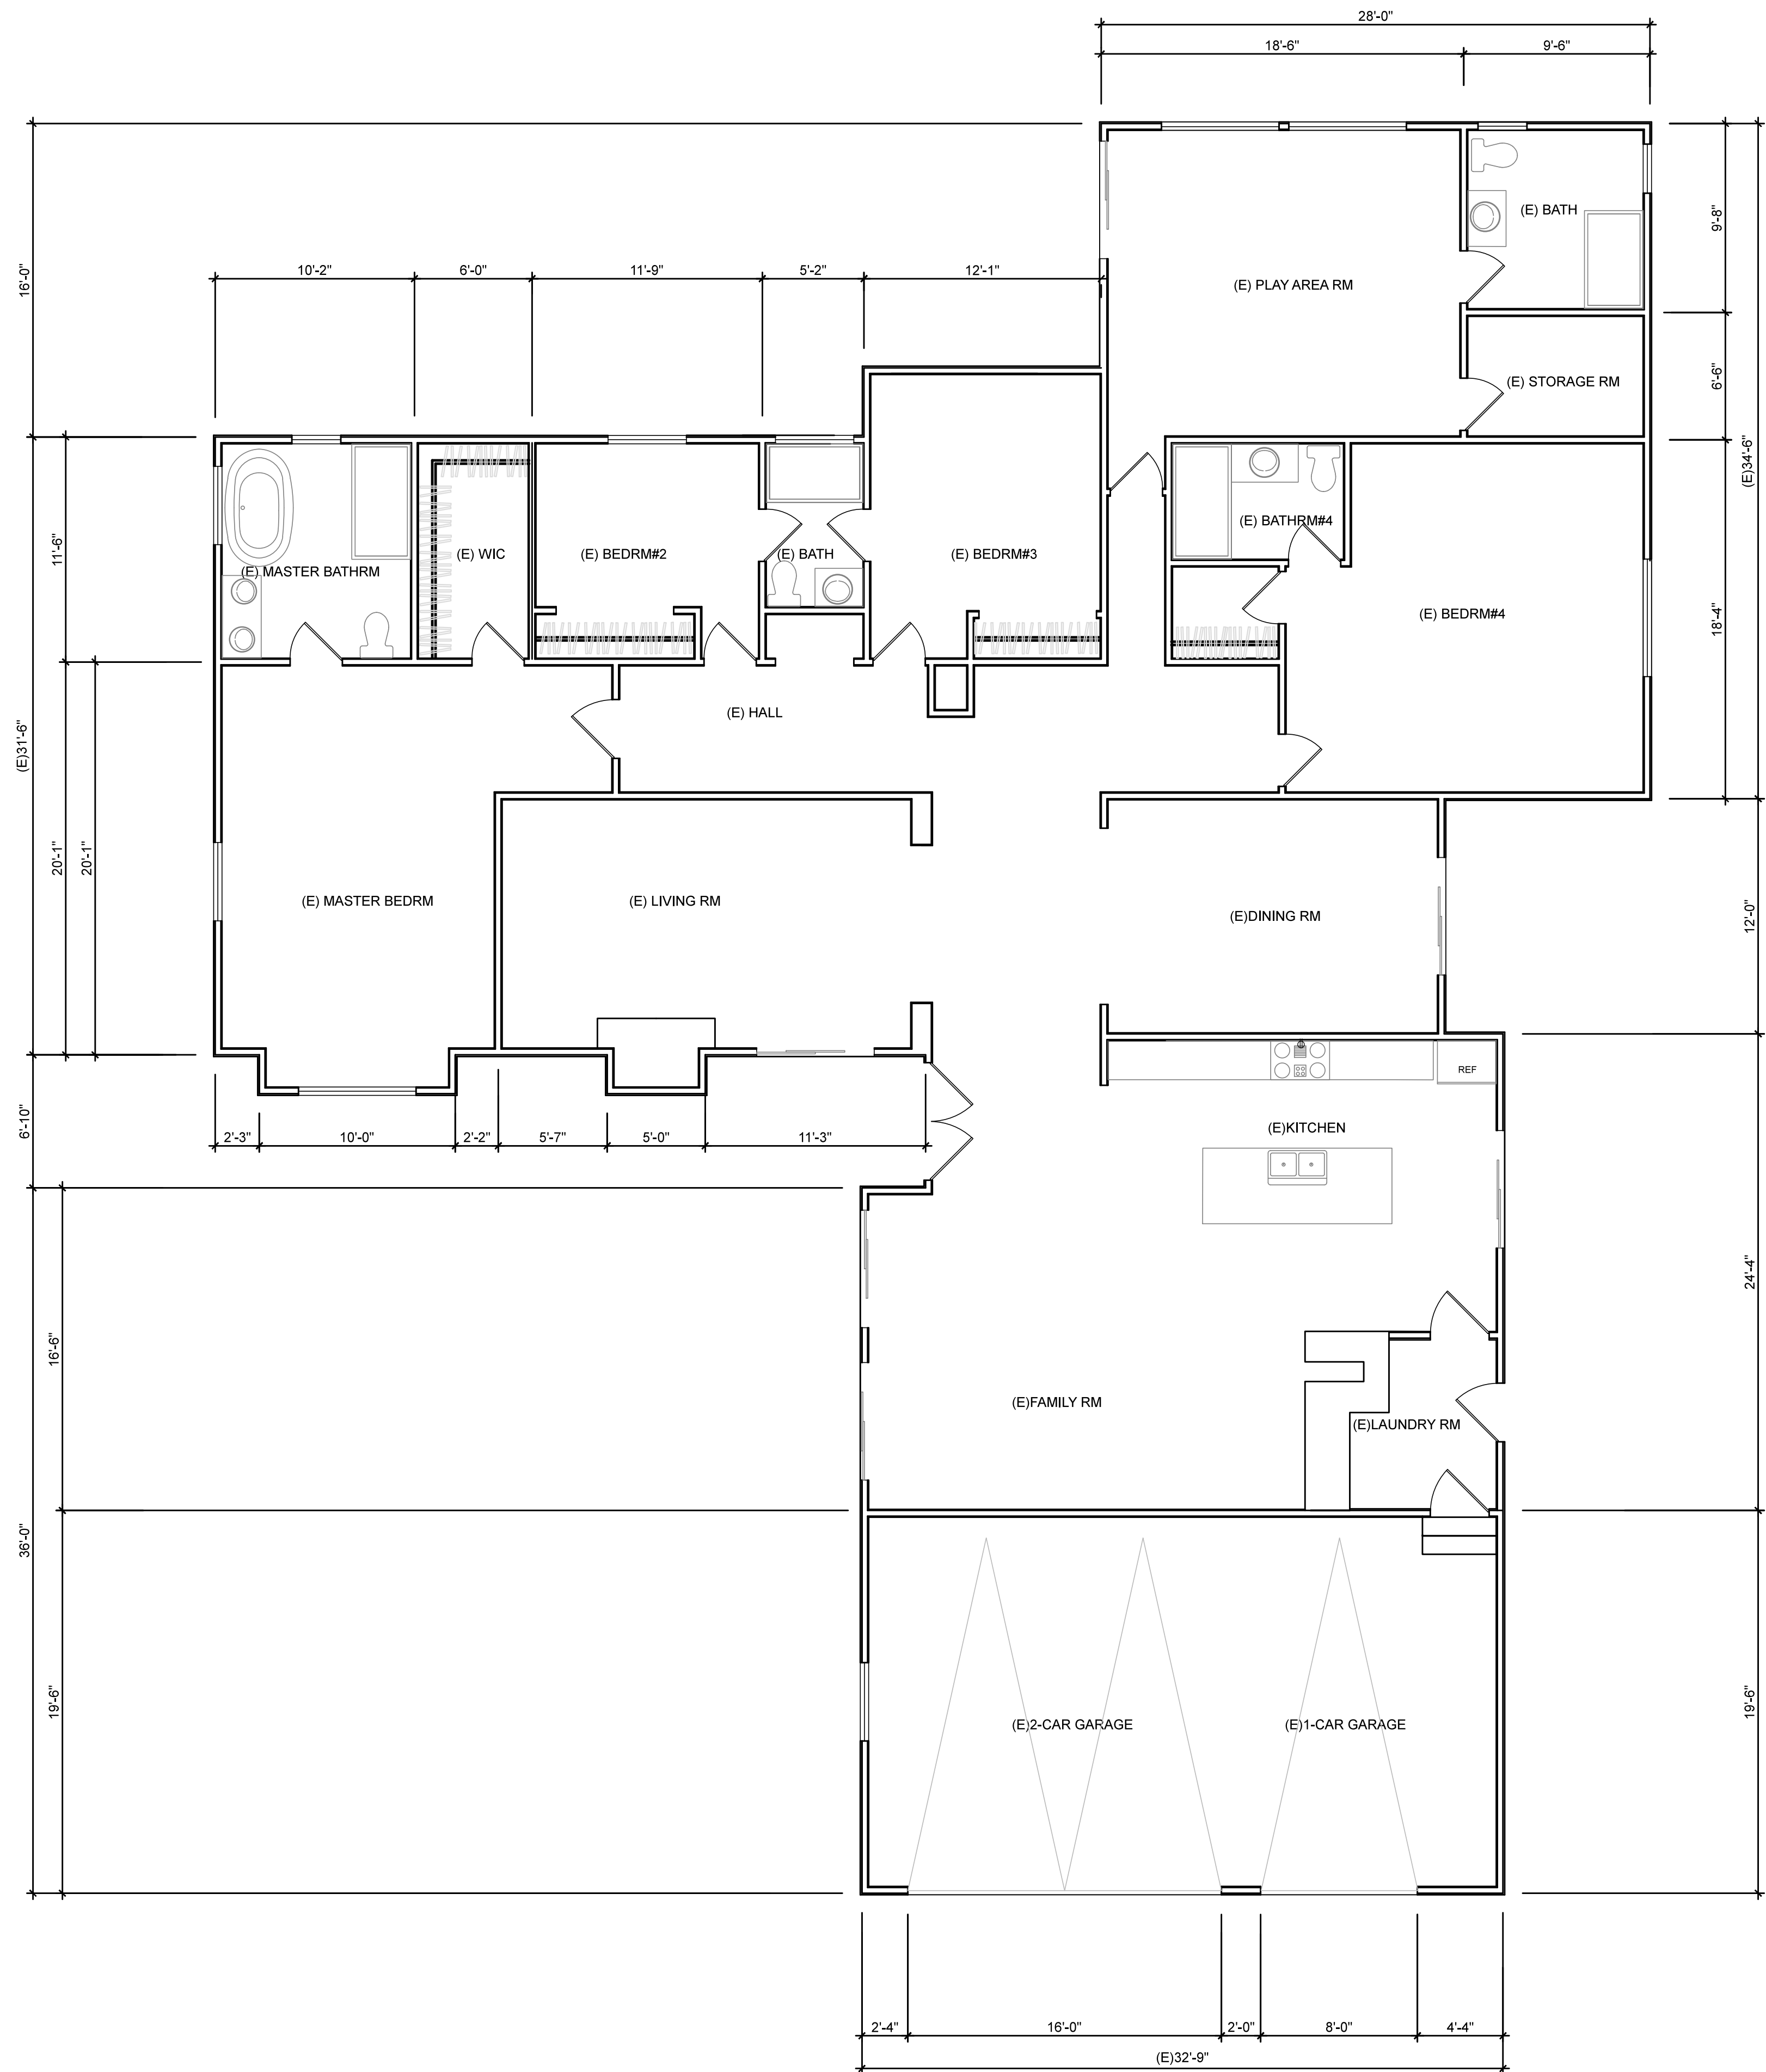

EXISTING AS-BUILT FLOOR PLAN
SCALE: 3/16"=1'-0"



DESIGNER:
SERGIO LOPEZ JR
ASSOC, A.I.A.

DESIGN & BUILDING
RESIDENTIAL / COMMERCIAL

CELL: (310) 701-8484
E-MAIL: sirjoe14@gmail.com

Seals/Signatures

Approvals
Revisions

No:	Description	Date
△		
△		
(E) AS-BUILT PLAN:

SUZANNE DYER
TEL: 310.544.5129
15 MISTY ACRES RD
ROLLING HILLS ESTATES, CA. 90274

Sheet Title
FLOOR PLAN

Scale: AS NOTED

Drawn By
S.LOPEZ

Job No.

Print Date
02/23/2020

Sheet Number

Of

Sheets

A-2.0