


DEPARTMENT OF ENVIRONMENTAL HEALTH
SEWAGE DISPOSAL SYSTEM
"AS-BUILT"

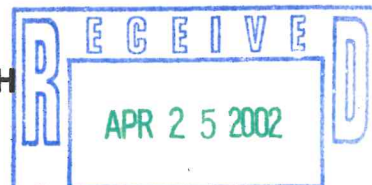

APR 25 2002

TEHAMA COUNTY

DEPARTMENT OF ENVIRONMENTAL HEALTH

Approval Issued to:

Keith Meentr 8245992
Corning Methodist Church

Installer's Name

Corinna Kentals - Loure Davies

Mailing Address: 703 Selma St.

Application Number 55404

AP Number 710-30-10

Corning Ca 96021

Property Address 1545 Blackburn Ave Corning A

Total Number:

Living units 1 bedrooms 3

Water Supply:

Public System _____ Individual X

Septic Tank:

Distance from well 600 feet Total Liquid Capacity 1200 gal.

Drainfield:

Total Linear Feet 100 ft.

Width of Trench or Bed 36" ft.

Distance Between Drain Lines NA ft. (edge to edge)

Depth Rock Over Drain Line NA - Chambered Infiltrator in.


Depth Rock Beneath Drain Line NA in.

Distance of well from closest portion of sewage system 600' + ft.

Sewage Pit:

Depth NA Diameter NA Number 1

SKETCH OF ACTUAL SYSTEM AS CONSTRUCTED

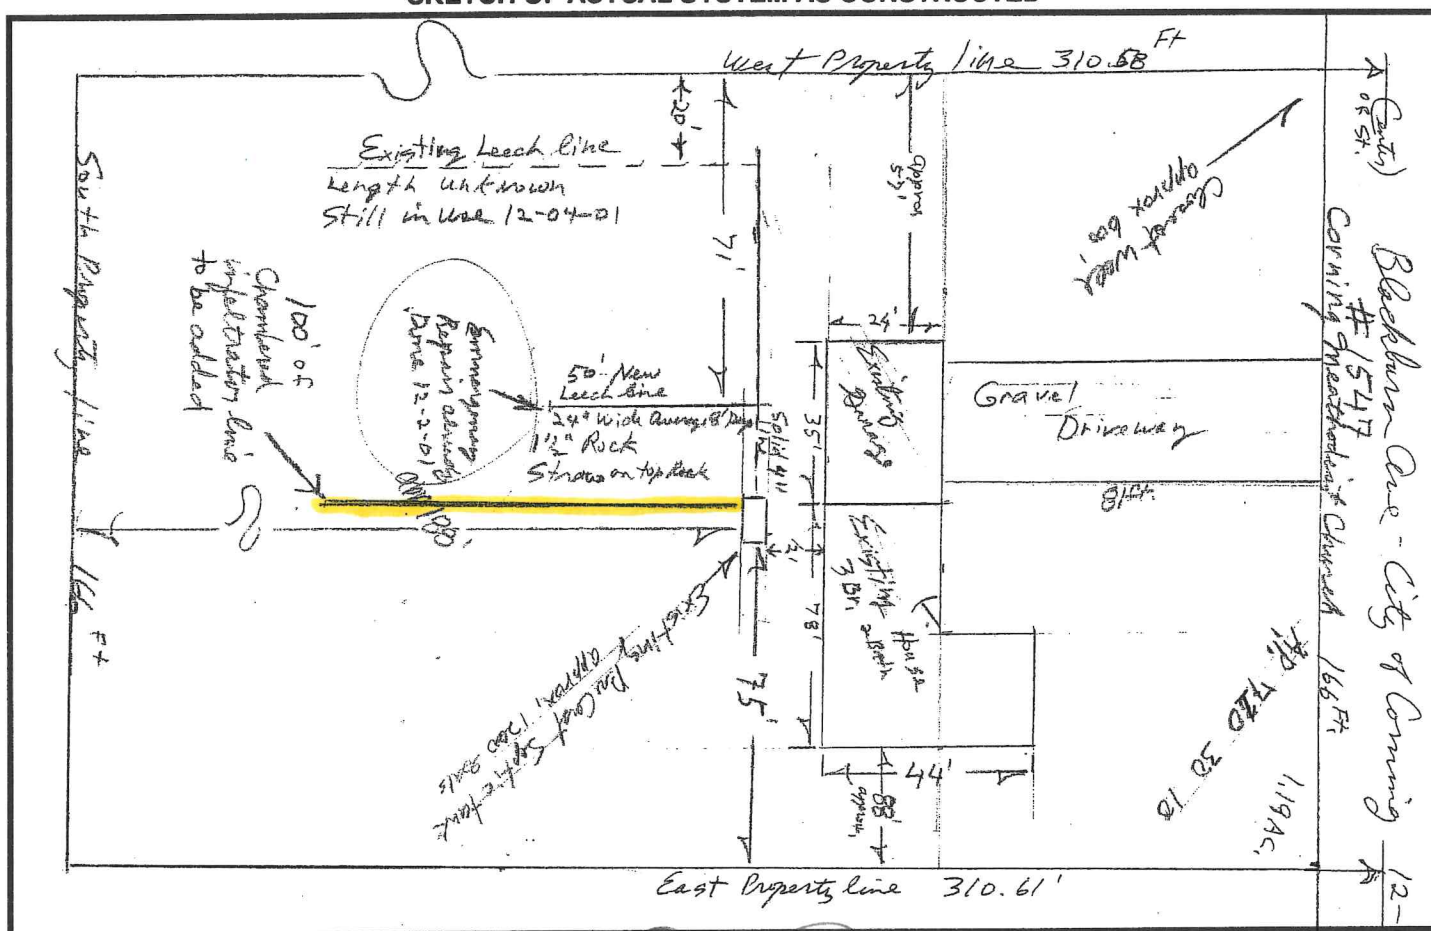

Louis J. Larus
SIGNATURE OF IN

SIGNATURE OF INSTALLER

DATE 04-22-02

DATE _____

System meets all codes and is therefore **APPROVED**

for use. **DISAPPROVED**

Date 4-25-02

E.H. Specialist

Famil Browe