

TOWN OF PARADISE
ONSITE WASTEWATER MANAGEMENT ZONE
5555 SKYWAY PARADISE CA

Date of Issue: 06/24/2009

ONSITE WASTEWATER DISPOSAL SYSTEM OPERATING PERMIT

Permit Number: OS09-02219

Expiration Date: 02/20/2015

AP Number: 055-130-059-000

Property Address: 560 RUSTIC LN

Owner: GOBLE DONALD G & VALYNDA K
560 RUSTIC LN
PARADISE, CA 95969

FILE COPY

Structure(s) served by this onsite wastewater disposal system: TWO (2) BEDROOMS
Onsite wastewater disposal system daily design flow: 225.00 gallons per day.
Drainage Basin: PEARS5A
Evaluation/Construction inspection was performed on: 02/20/2007

EXISTING SYSTEM COMPONENTS

STANDARD SEPTIC SYSTEM

SEPTIC TANK

Installation Date: 01/13/2005
Construction: CONCRETE
Liquid Capacity: 1500 Gallons

Operating Permit Notes:

Evaluator:
TOWN OF PARADISE
BOB LARSON
872-6291


ABSORPTION FIELD

Installation Date: 02/20/2007
Total Length: 120 Feet
Trench Width: 24 Inches
Total Rock Depth: 24 Inches

Certificate/License Number:
S-101

Additional onsite wastewater disposal system evaluations are required if there are any changes in the onsite system operating parameters. This permit is valid until 02/20/2015. The owner is responsible for having an evaluation performed within two months before this date in order to have this operating permit renewed.

Date: 06/24/2009

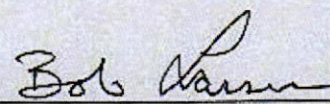Signature: 

OS# 1007-00
APPROVED

By: B. L.

Date: 2/21/07

Onsite Divisions

McGREGOR CONSTRUCTION

GENERAL ENGINEERING CONTRACTOR

699-B Pearson Road - Paradise, California 95969

CONTRACT PROPOSAL

Phone: 530-864-8186


License No. A-276095

PROPOSAL SUBMITTED TO 055-130-059	PHONE	DATE
STREET 560 Rustic Lane	JOB NAME	
CITY, STATE AND ZIP CODE	JOB LOCATION	
LENDER:	ADDRESS:	

WE HEREBY SUBMIT SPECIFICATIONS AND ESTIMATES FOR:

1"=20' SCALE AS-BUILT TO BE
PROVIDED AT TIME OF INSPECTION

U.S.A. TO BE MARKED PRIOR TO EXCAVATION

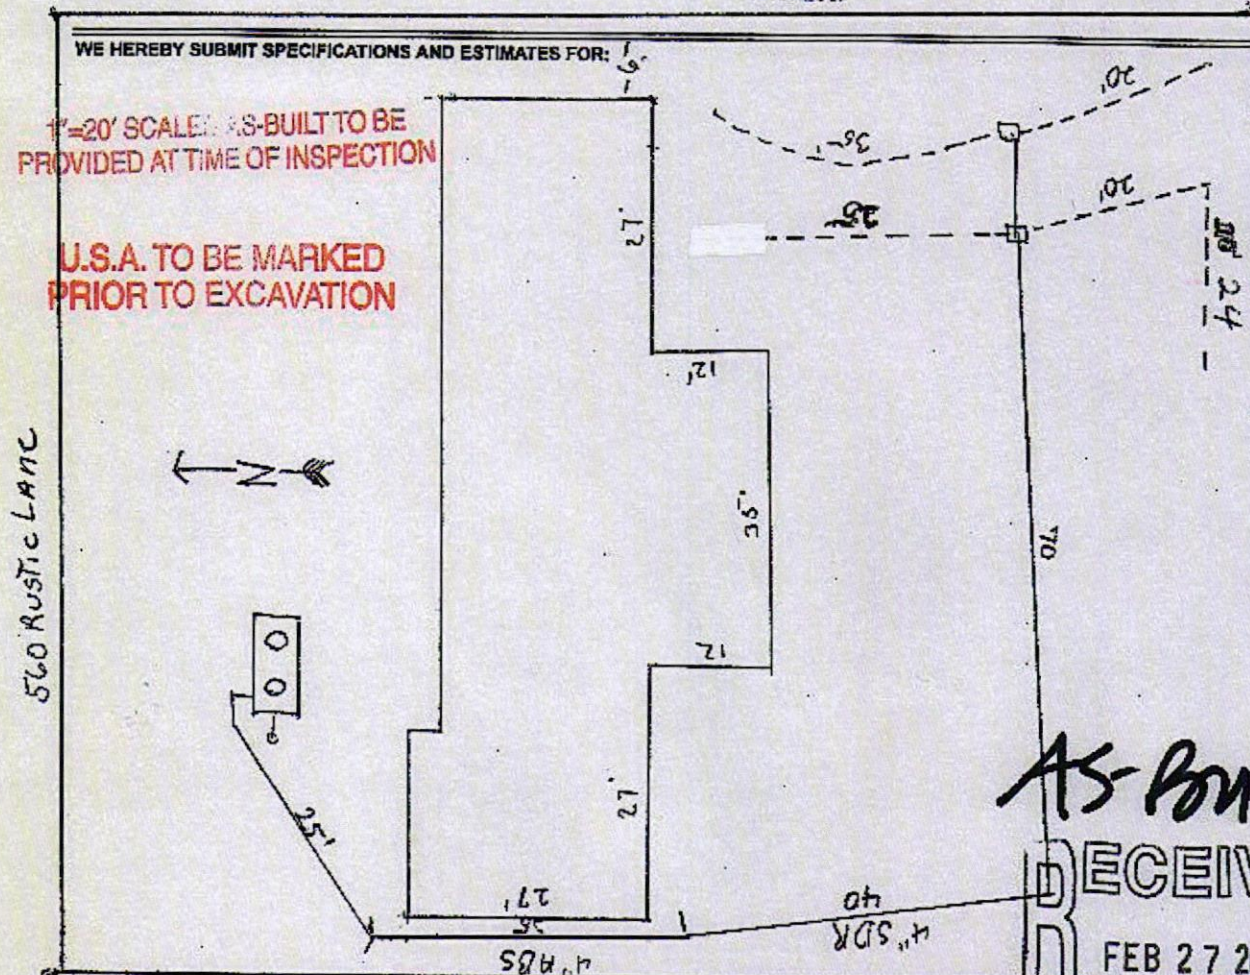

APN 055-130-059-000
SITE 560 Rustic Ln
MAX # BDRMS 2
MAX SQ FT 2200

AS-BUILT
RECEIVED
FEB 27 2007

WE PROPOSE hereby to furnish material and labor - complete in accordance with above specifications for the sum of \$_____ TOWN OF PARADISE
COMMUNITY DEVELOPMENT DEPT

TERMS: Progress payments are due and payable 10 days after billing. Final payment is due and payable on completion of work. Overdue accounts will incur a FINANCE CHARGE of 1 1/2% on balances of \$1,000 or less and 1% on amounts in excess of \$1,000 (or minimum charge of \$1.00 for balances under \$67), which are ANNUAL PERCENTAGE RATES of 18% and 12% respectively. Prompt payment will avoid such finance charges.

IN THE EVENT LEGAL ACTION is instituted by either party hereto, the prevailing party shall be entitled to reasonable attorney's fees and costs.

R. S. McGREGOR

By _____

NOTE: THIS PROPOSAL MAY BE WITHDRAWN BY US IF NOT ACCEPTED WITHIN _____ DAYS.

ACCEPTANCE OF PROPOSAL: The above prices, specifications and conditions are satisfactory and are hereby accepted. You are authorized to do the work as specified. Payment will be made as outlined above.

DATED _____
Return original to: R.S. McGREGOR

SIGNATURE: _____
(See Mechanic's Lien Law and General Conditions on Reverse Side)