



Scale: 1-40

PROJECT SCOPE


7.194 KW DC 7.022 KW AC
 240VAC GRID INTERACTIVE
 SYSTEM CONSISTING OF
 22 SPR-E20-327-D-AC
 MODULES MOUNTED ON
 PROFESSIONAL SOLAR PRODUCTS
 PRO SOLAR RAILS.
 SOLAR SYSTEM IS GROUND MOUNTED
 AND SUPPORTED BY PRO SOLAR
 FOR GROUND MOUNT,
 SEE INSTALLATION SHEET FOR
 ENGINEERING DETAILS.

CODE & REGULATION

1. ALL WORK TO COMPLY WITH THE CALIFORNIA FIRE CODE SECTION 605.1, R331 OF THE CALIFORNIA RESIDENTIAL CODE, AND THE 2016 C.B.C, C.M.C, C.E.C, N.E.C, CALIFORNIA TITLE 24 AMENDMENTS AND AUTHORITY HAVING JURISDICTION IN SAN DIEGO COUNTY, CALIFORNIA
2. SOLAR PHOTOVOLTAIC POWER SYSTEMS SHALL BE INSTALLED IN ACCORDANCE WITH CA FIRE CODE SECTIONS 605.11.1 THROUGH 605.11.4, THE CA BUILDING CODE, THE CA RESIDENTIAL CODE, AND THE CA ELECTRICAL CODE.
3. PV INSTALLATION SHALL NOT OBSTRUCT ANY PLUMBING, MECHANICAL, OR BUILDING ROOF VENTS.
4. SMOKE ALARMS AND CARBON MONOXIDE DETECTORS REQUIRED WHEN A PERMIT, ADDITIONS \$1,000.00 OF CONSTRUCTION

Matthew Rehr
 MATTHEW REHR

ELECTRICAL
 BY *ssh* DATE *11/9/2017*

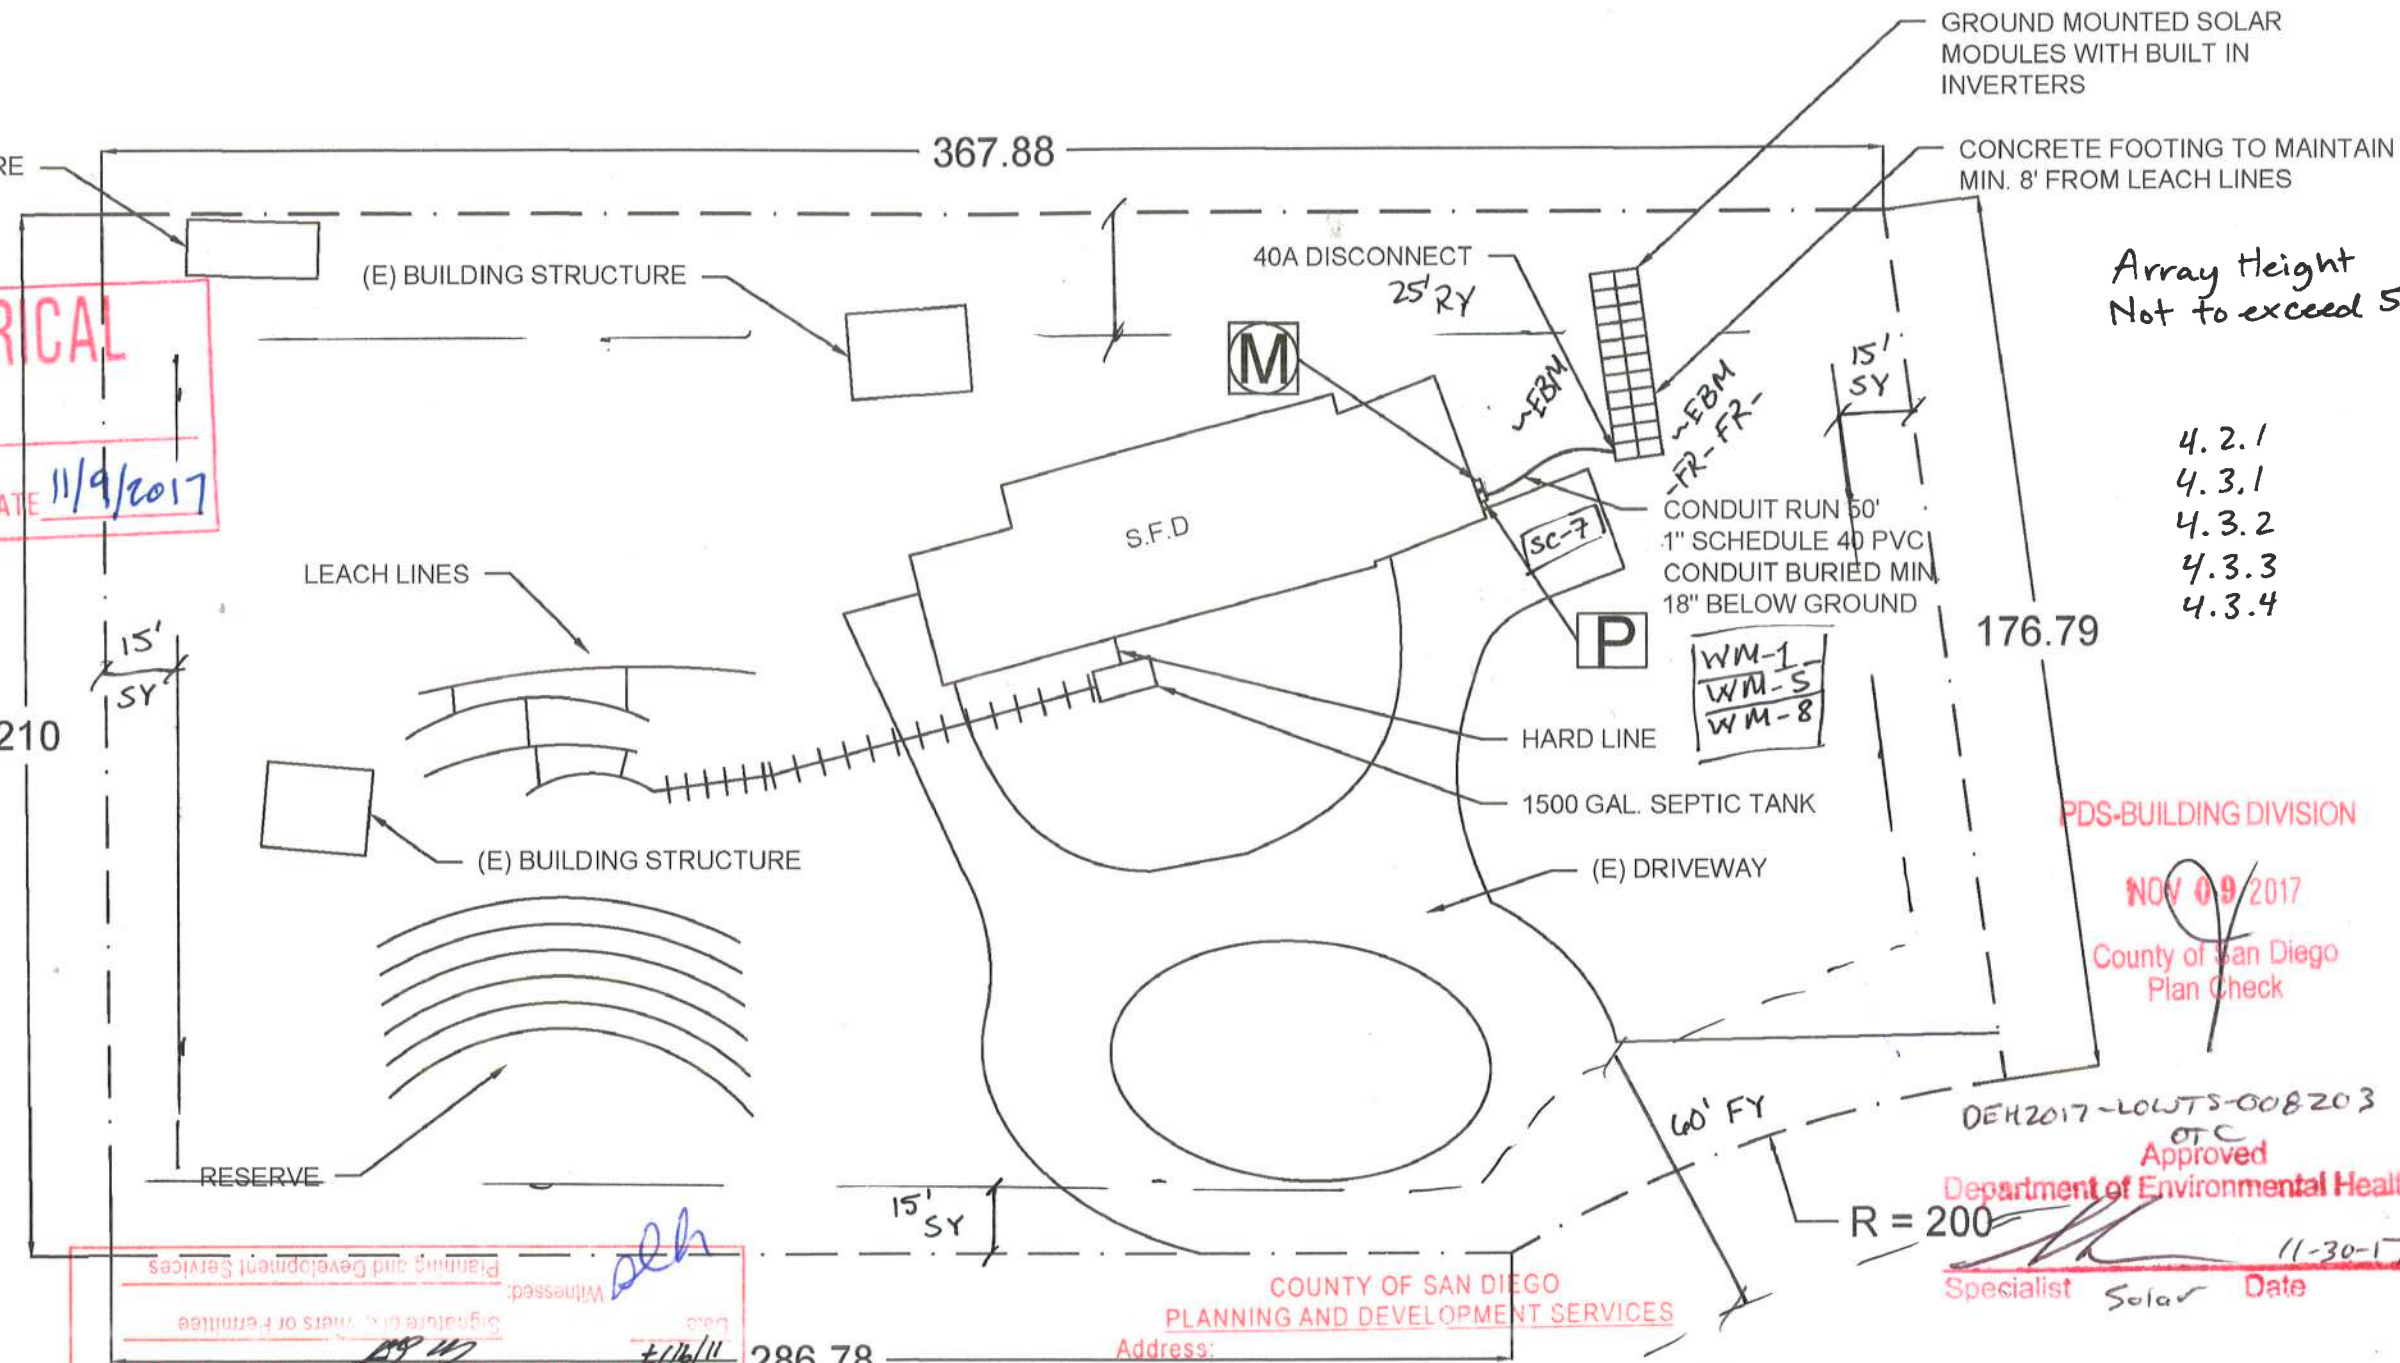

This plot plan shows the buildings and structures existing and previously proposed. It shows the correct dimensions of the property, the buildings, their setbacks from property lines and distances from one another. The proposed use of each building shown is true and correct. To my knowledge all easements, front yards and encroachments in development have been accurately shown and the setbacks are true and correct. The applicant is responsible for providing an accurate boundary description on the plot plan. County approval does not constitute an endorsement or confirmation of the accuracy of the description. Applicant will defend, indemnify and hold harmless the County for any liability arising from an inaccurate description.

Witnessed: *delh*
 Date: *11/9/17*
 Signature of Planner or Permittee: *delh*
 Signature of Planner or Permittee: *delh*

COUNTY OF SAN DIEGO
 PLANNING AND DEVELOPMENT SERVICES
 Address: _____
 AFN#: *401-110-15-00*
 Use: *Ground Mount Solar PV*
 Discretionary Permit# _____
 Counter Tech _____
 Planner: *delh* *11/30/17*

P PERFORMANCE METER
C LOAD CENTER
M METER # 06300992 WITH (E) 200A LC

PDS-BUILDING DIVISION
 NOV 09 2017
 County of San Diego
 Plan Check

DEH2017-LOWTS-008203
 Approved
 Department of Environmental Health
 Specialist *Solar* Date *11-30-17*

814 Via La Cresta, El Cajon, CA 92021

SITE PLAN
 JAY BURDEN, LIC # 1019515
 BURMAX LLC. & PACIFIC DESIGN BUILD
 619-372-5287 INFO@BURMAXENERGY.COM

Burmax Energy

SUNPOWER

PROJECT NUMBER:	1243848
DRAWN BY:	Matthew Rehr
UTILITY ACCOUNT:	---
DATE:	11/09/2017
SCALE:	1" = 40' - 0"

Haverly
 814 Via La Cresta
 El Cajon, CA, 92021
 PHONE #: (619) 672-0932
 EMAIL: georgehaverly@sbcglobal.net

PV-1.1