



1st Floor As-Built Plan

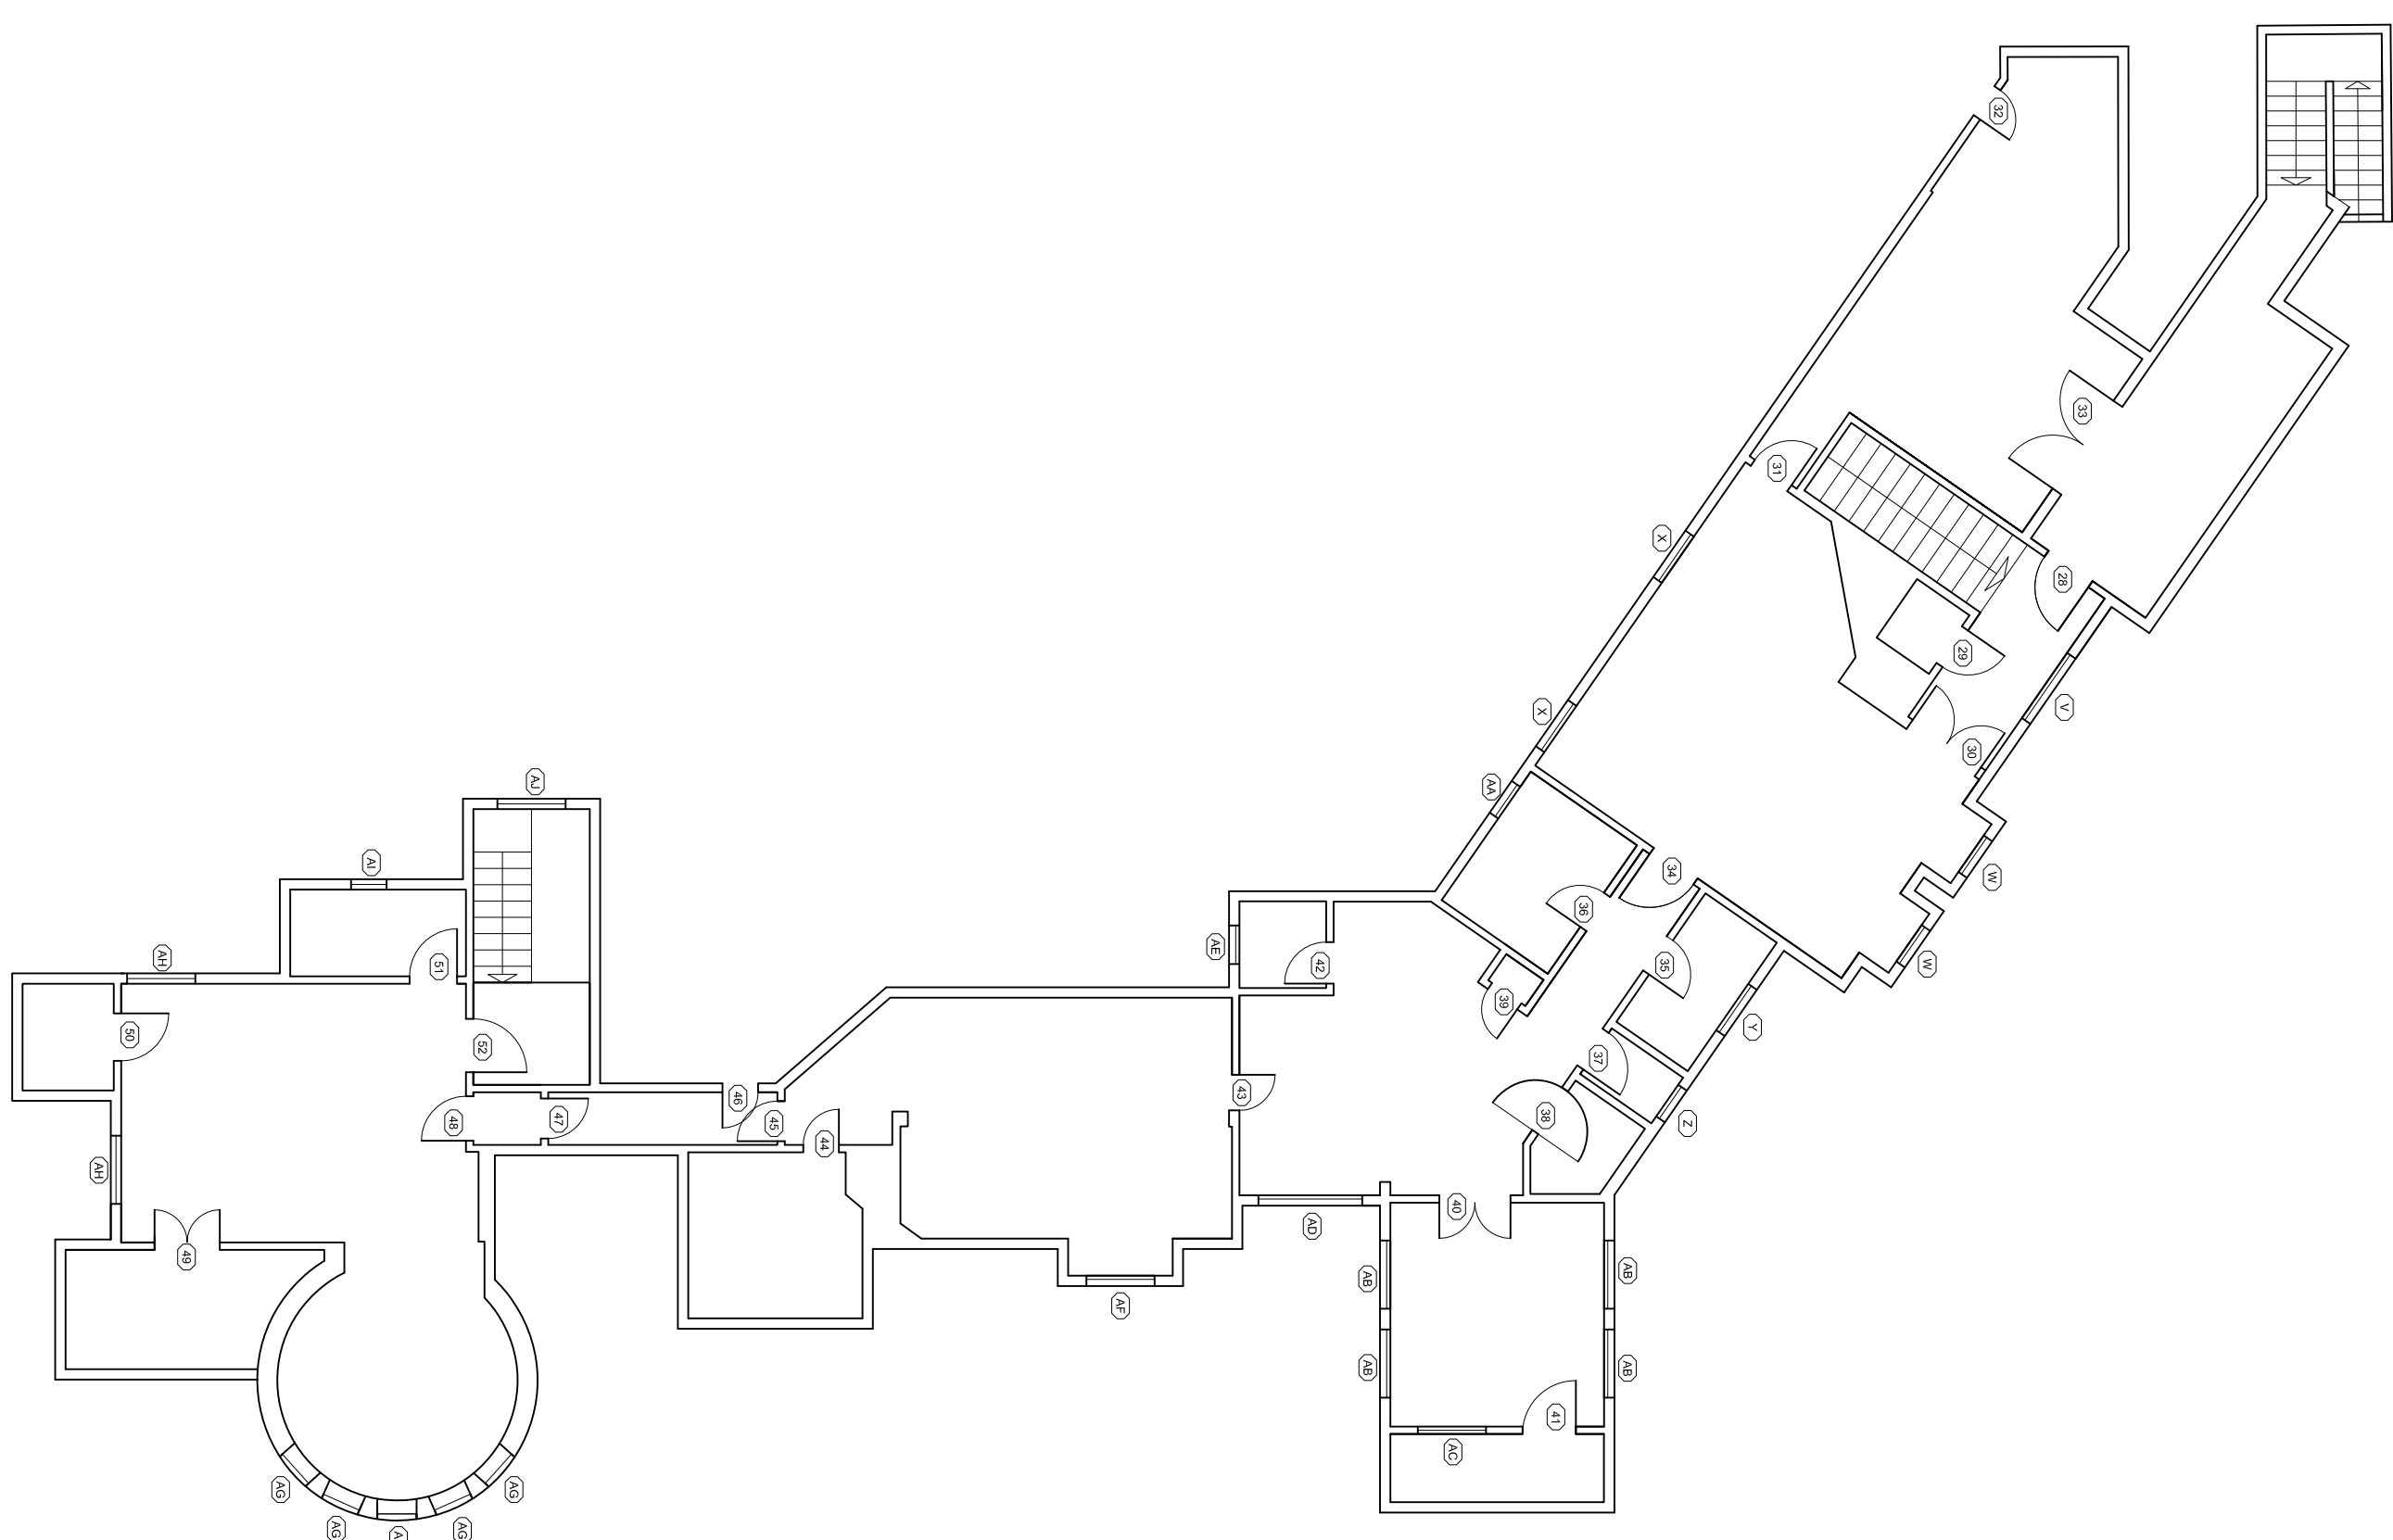

2nd Floor As-Built Plan

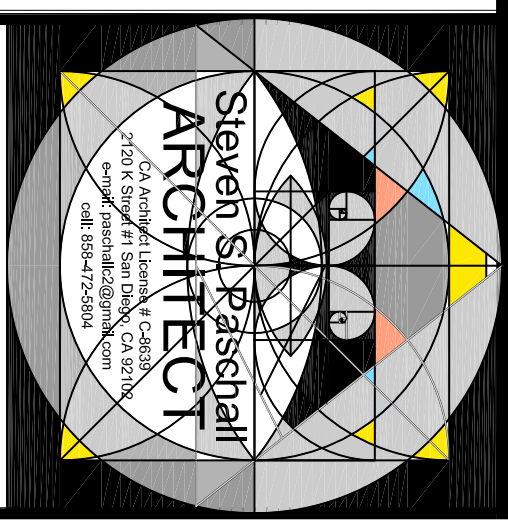

Project Title:
D'Amour Residence Remodel
 17432 Calle Mayor
 Rancho Santa Fe, CA 92067.


Sheet Title:
FLOOR PLANS

MARK	DATE	DESCRIPTION
1	8/8/20	Progress set
0	8/2/20	As-Built

PROJECT NO.: 20205
MODEL FILE: D'Amour Residence
DRAWN BY: ssp/jlp
CHK'D BY: SSP
COPYRIGHT

A1.0

GRAPHIC SCALE
 IF SHEET IS DIFFERENT THAN 24" X 36"
 ADJUST SCALE ACCORDINGLY.

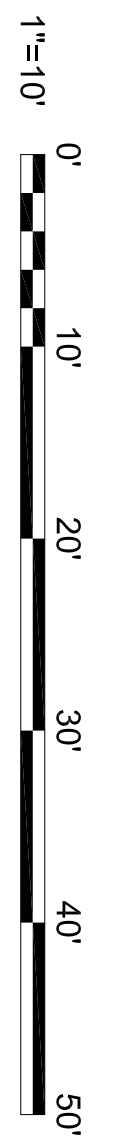

Architectural drawing grid with vertical labels A, B, C, D and horizontal labels 1, 2, 3, 4, 5.