




DETAIL # 8

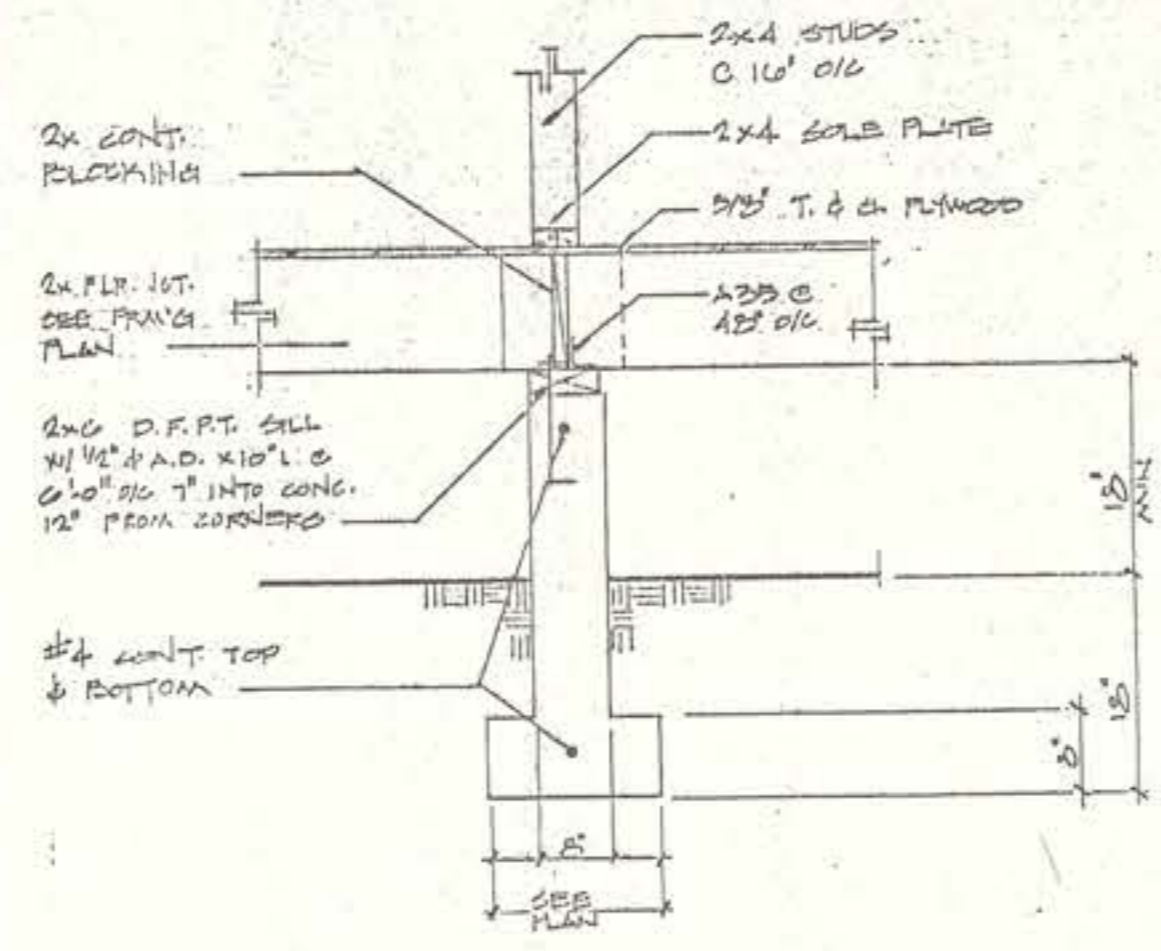


DETAIL # 4

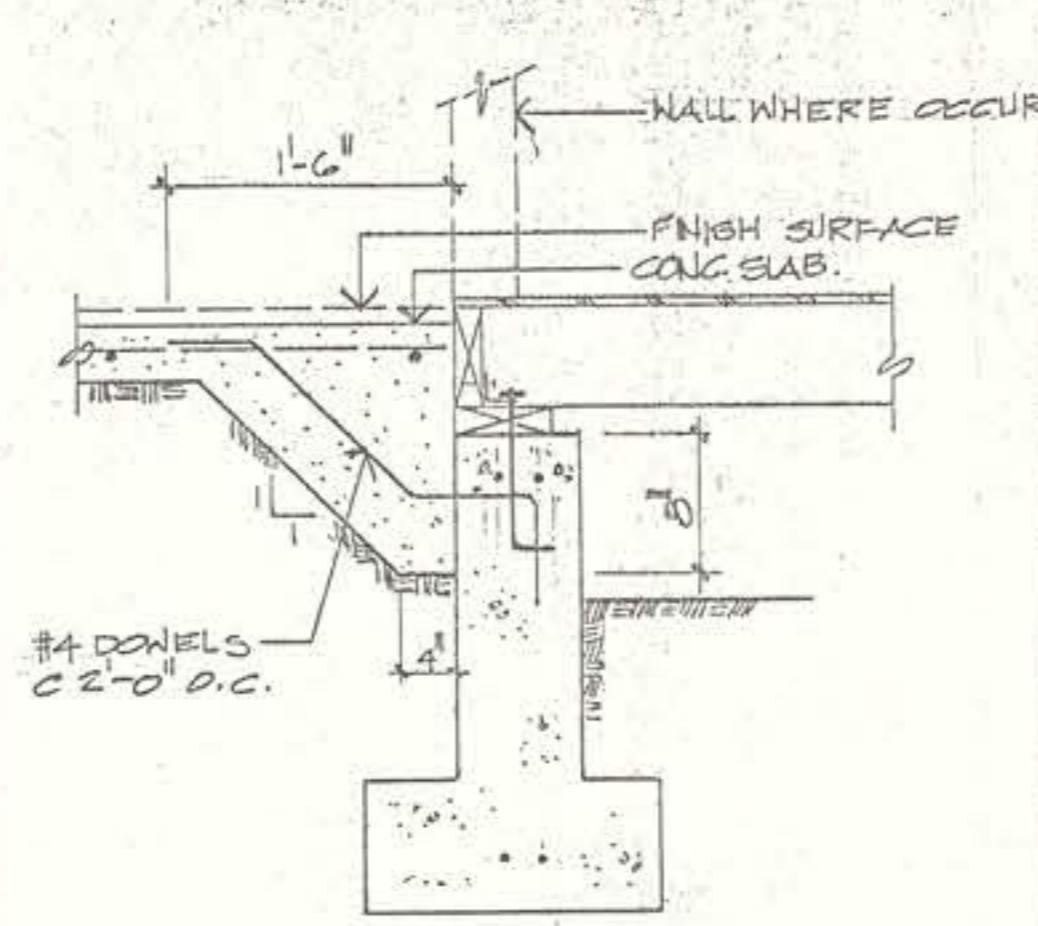


DETAIL # 3

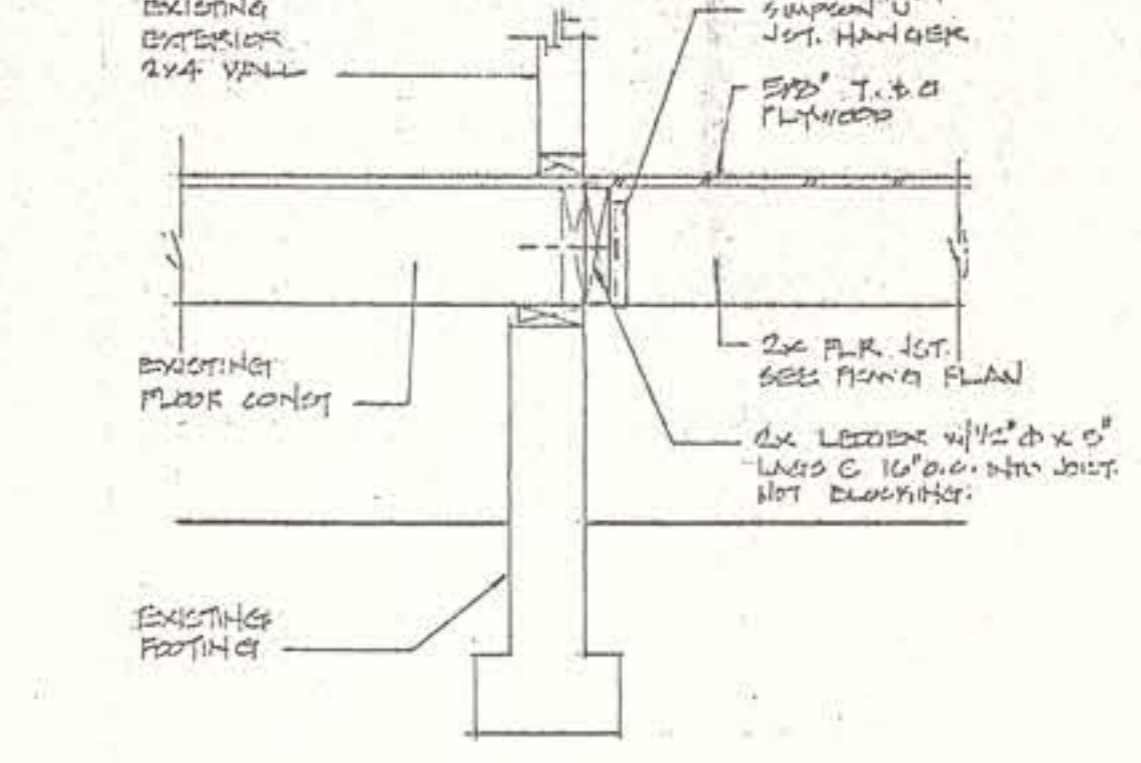


DETAIL # 2

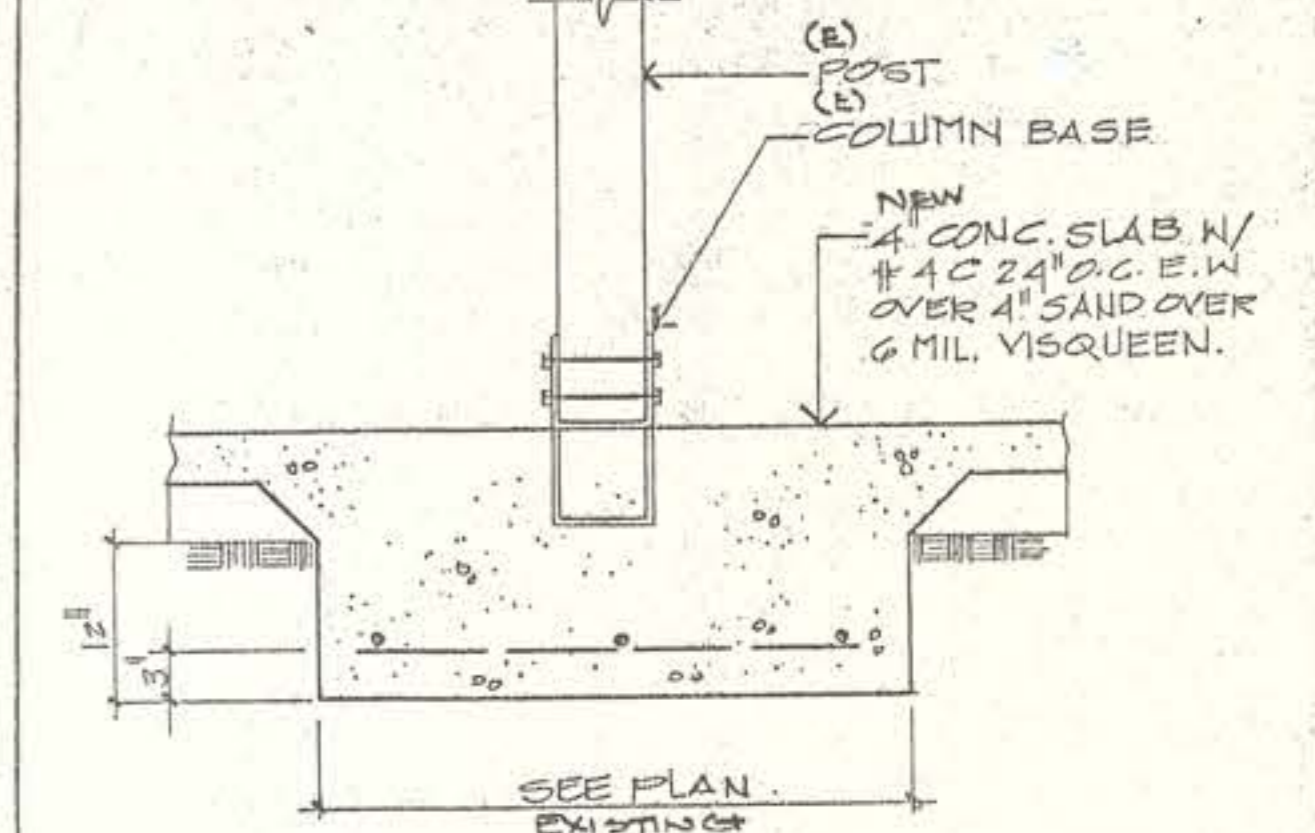


DETAIL # 1

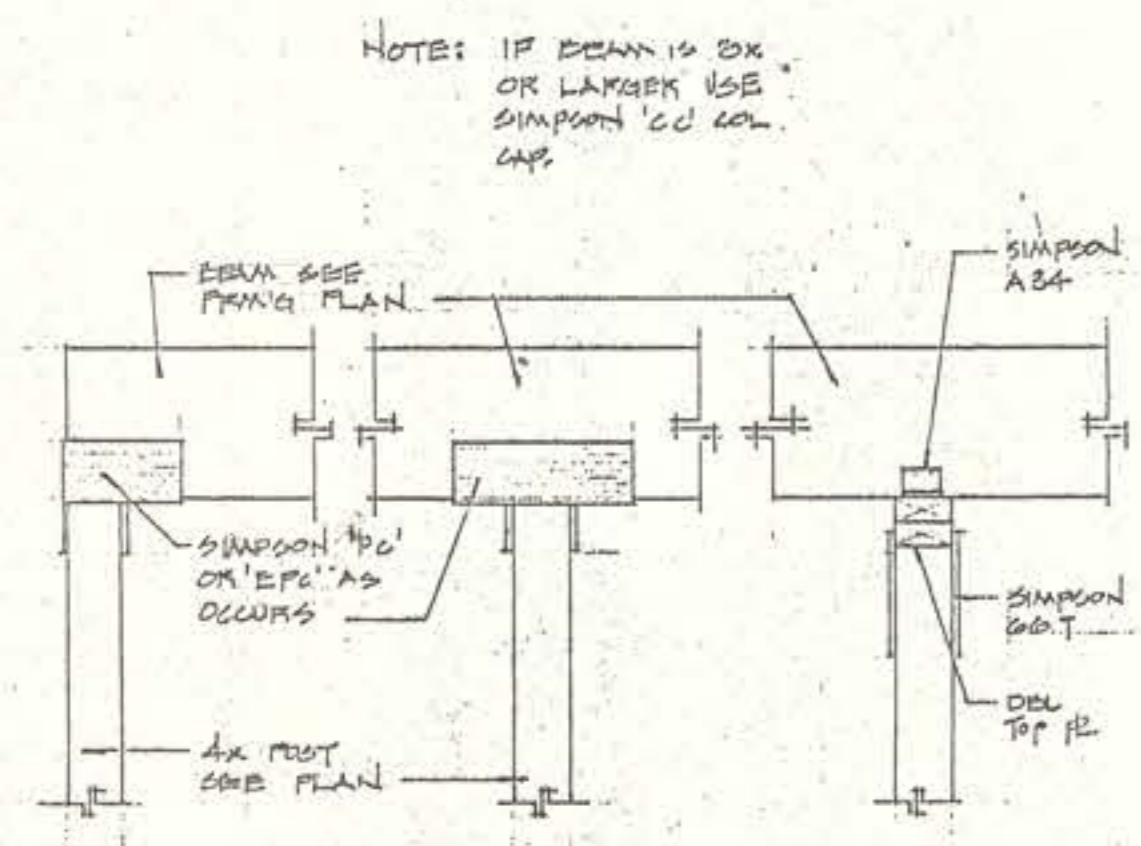


DETAIL # 9

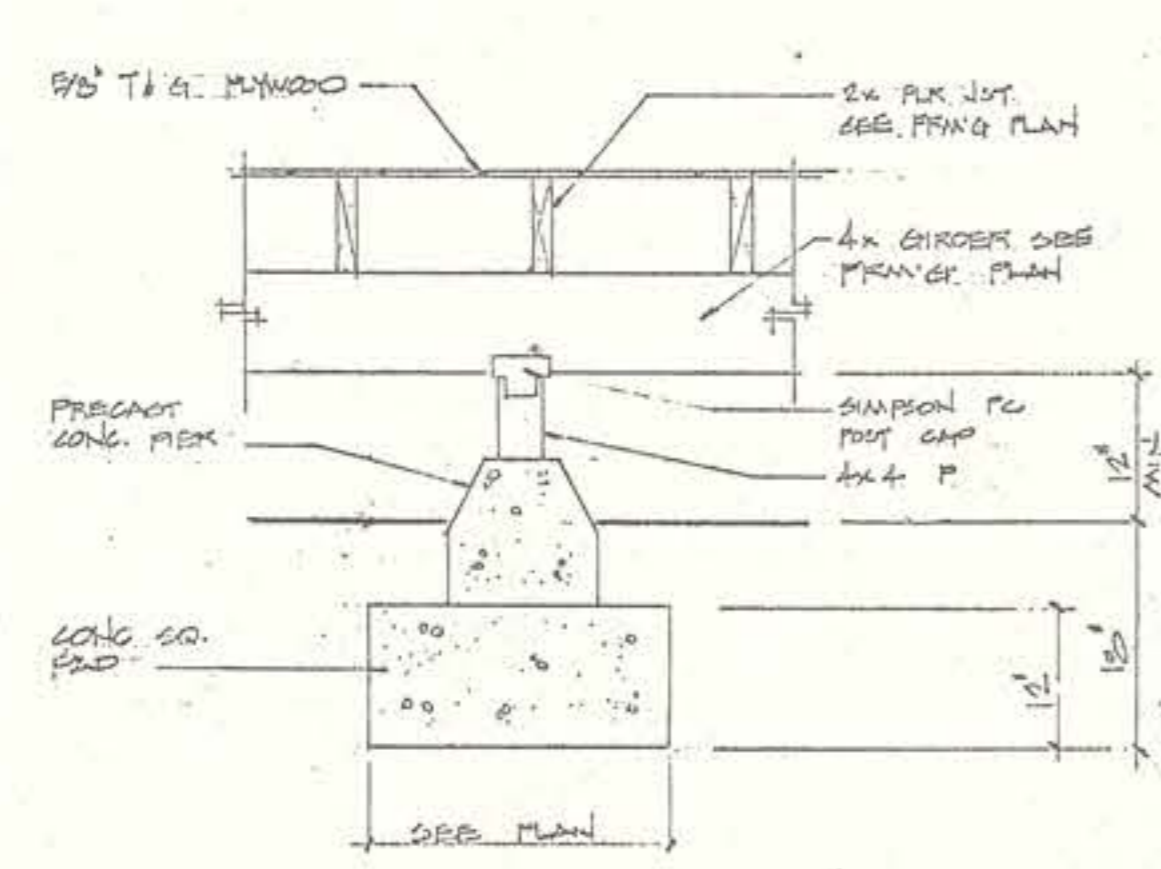


DETAIL # 5

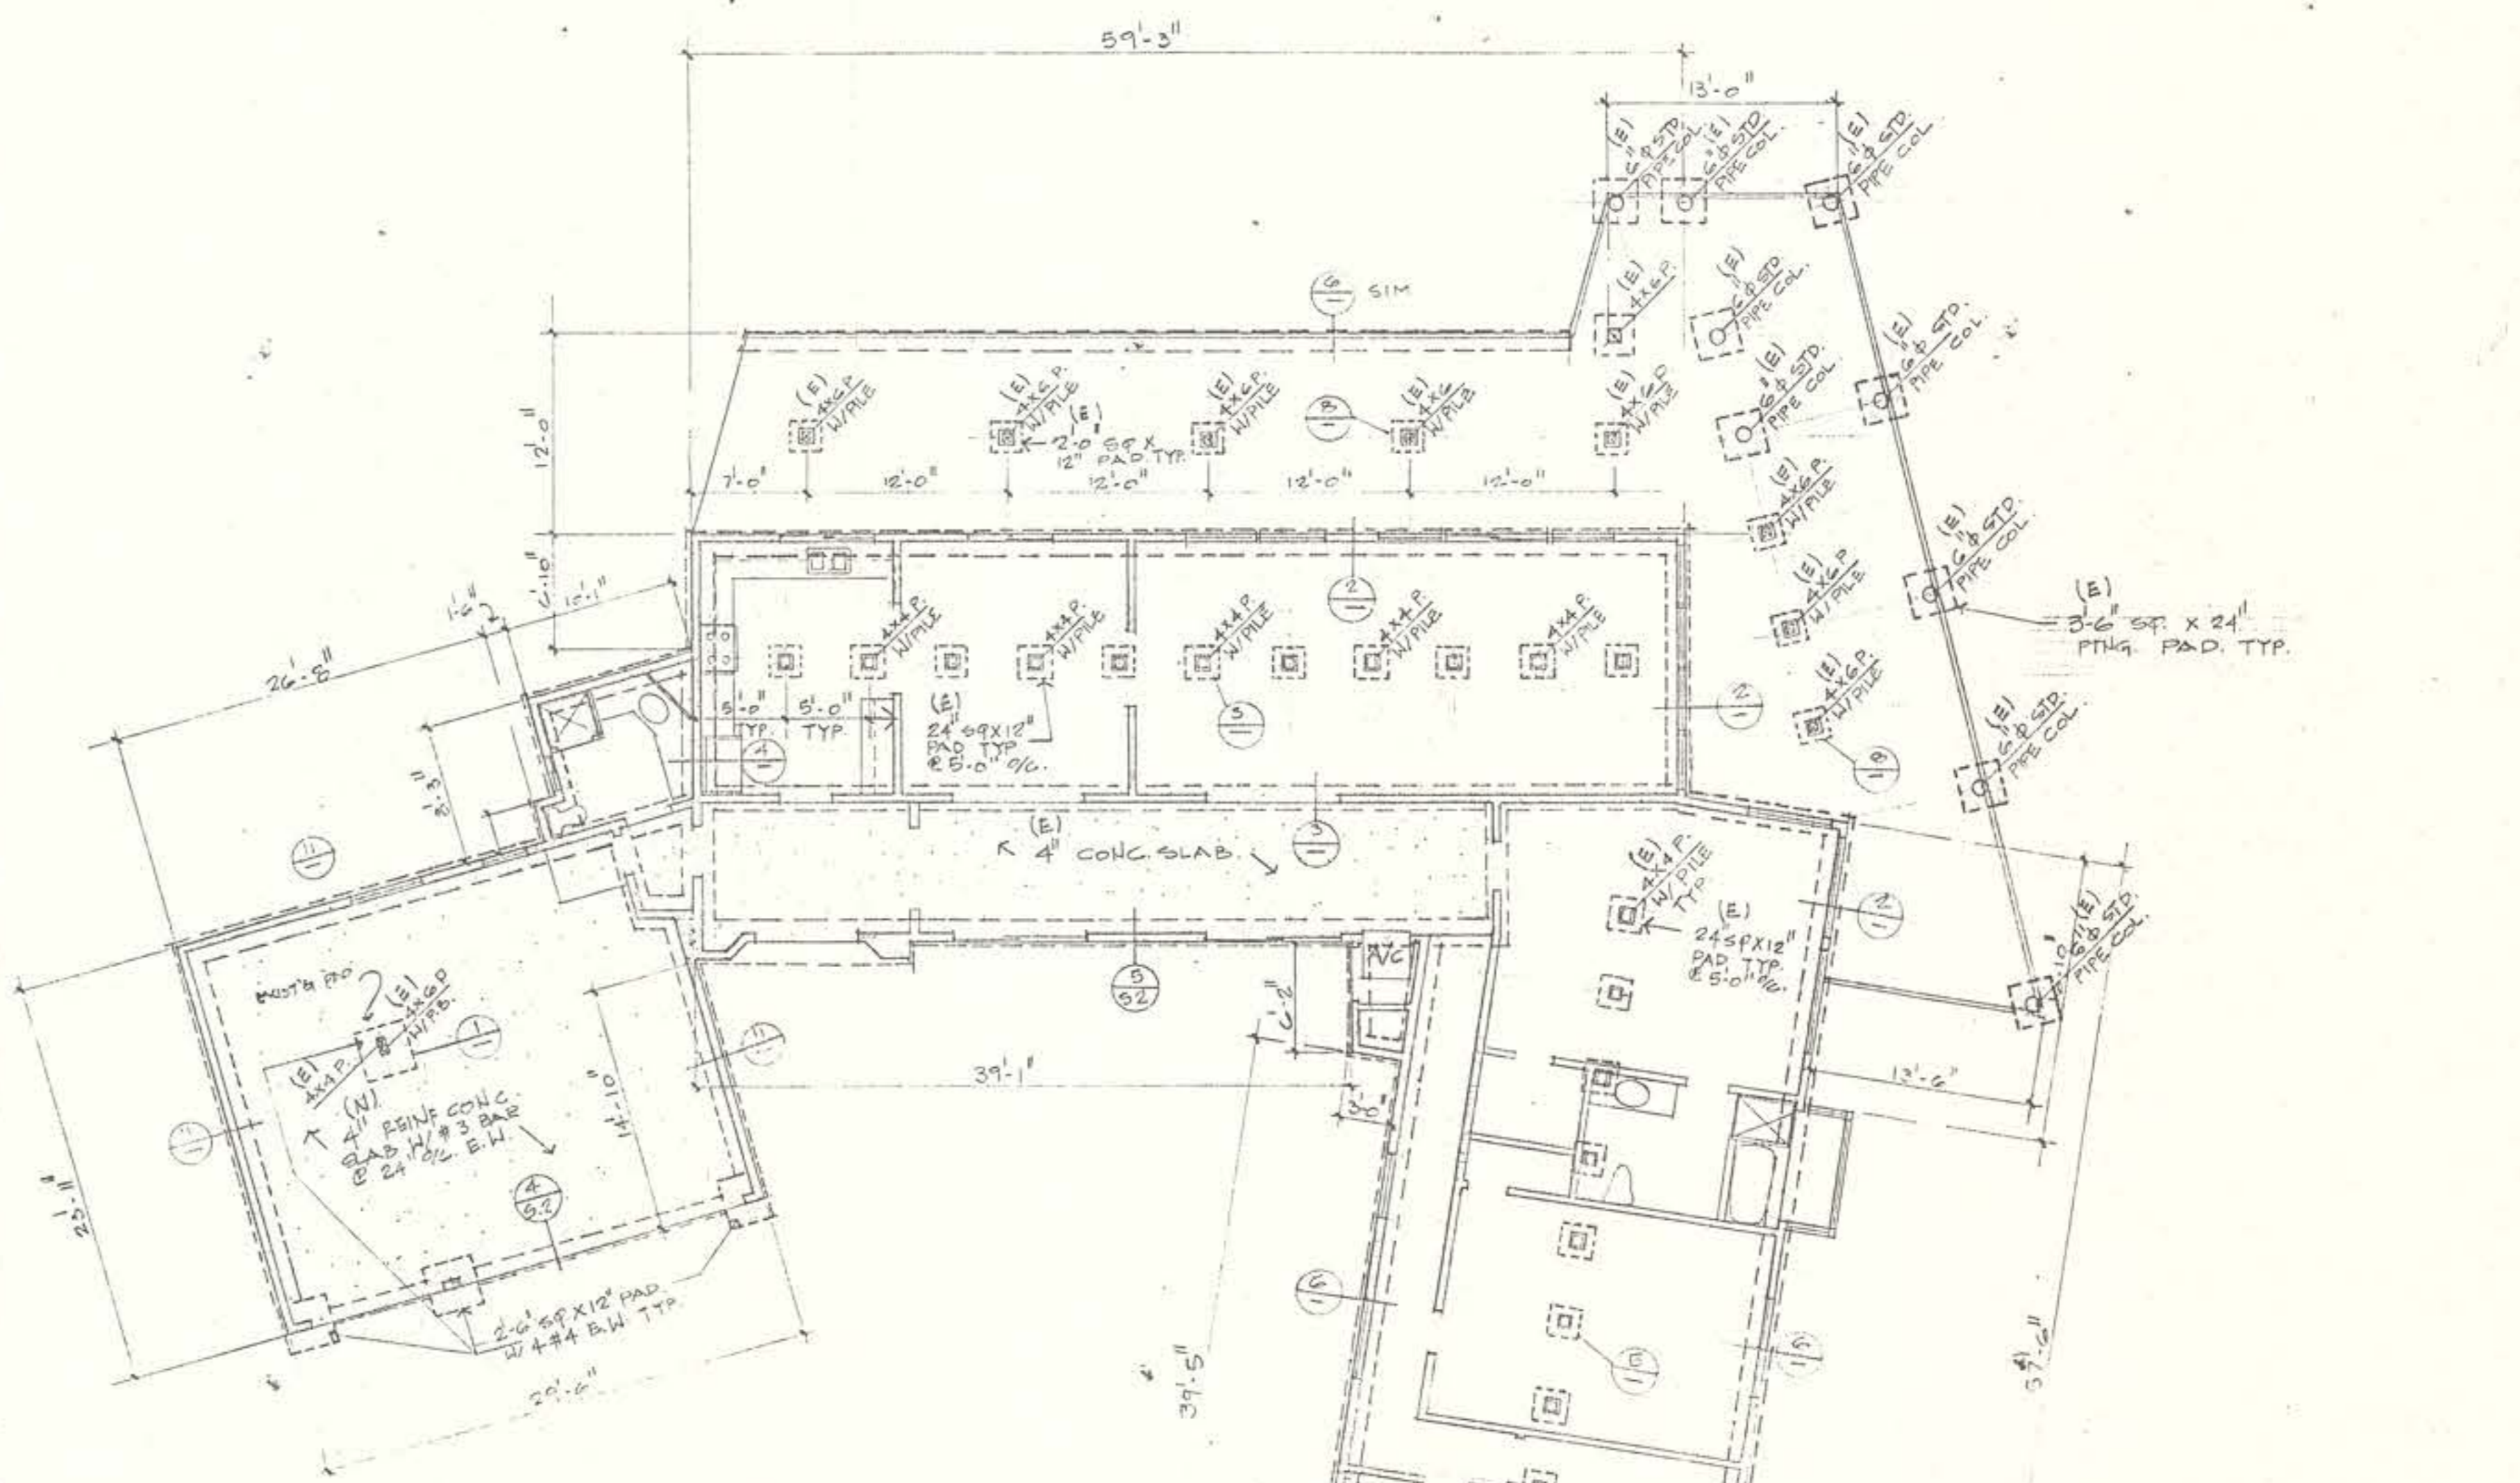


AS-BUILT FOUNDATION PLAN
SCALE 1/8\"/>

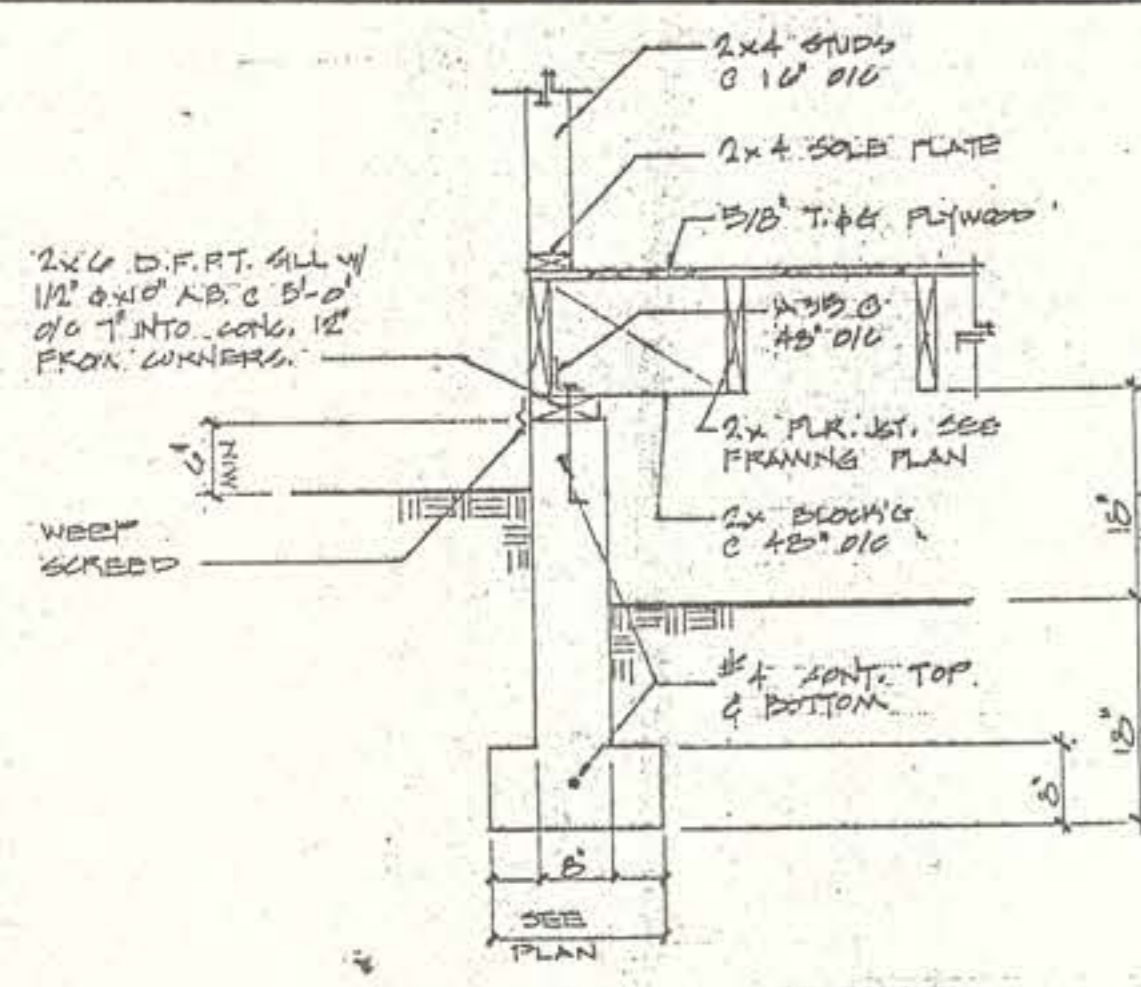


DETAIL # 10

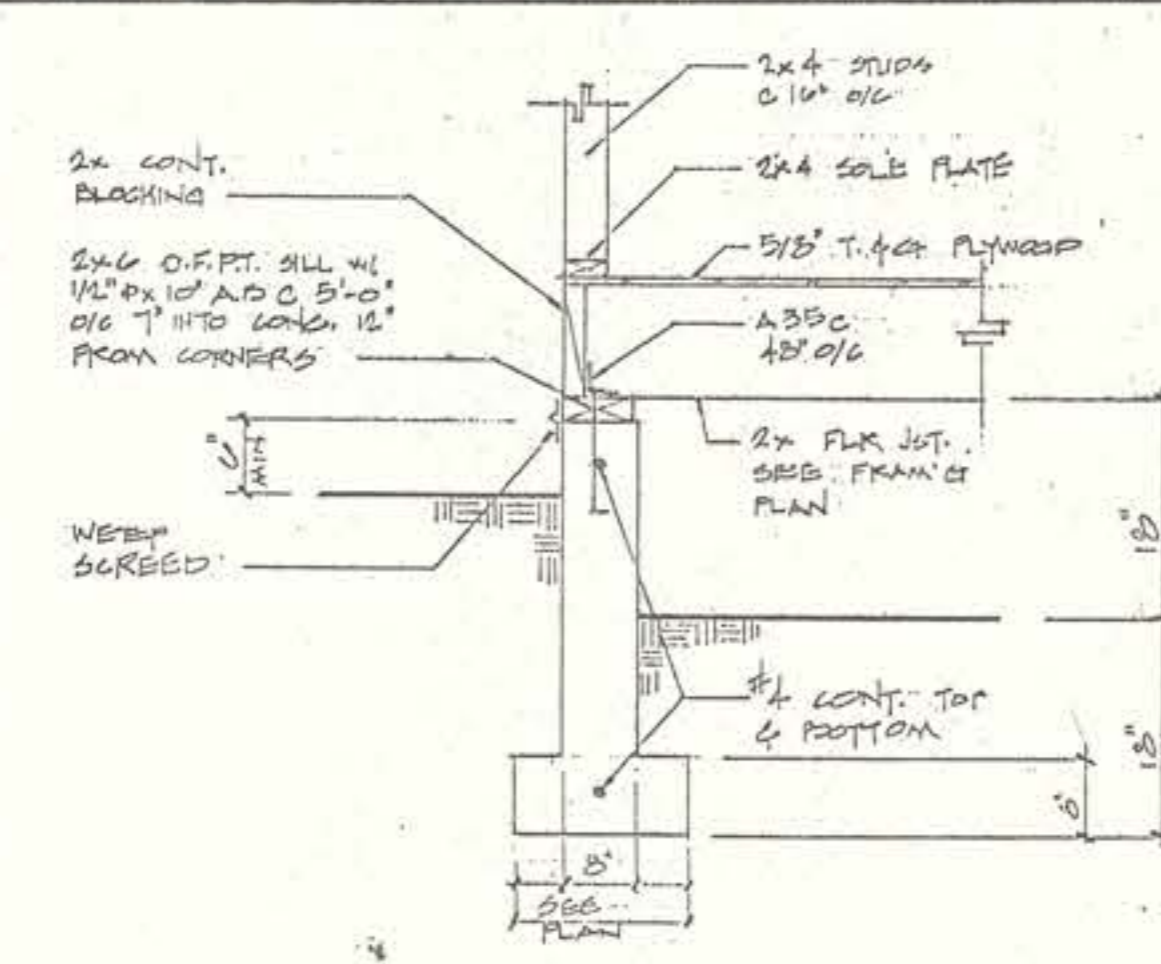

DETAIL # 6

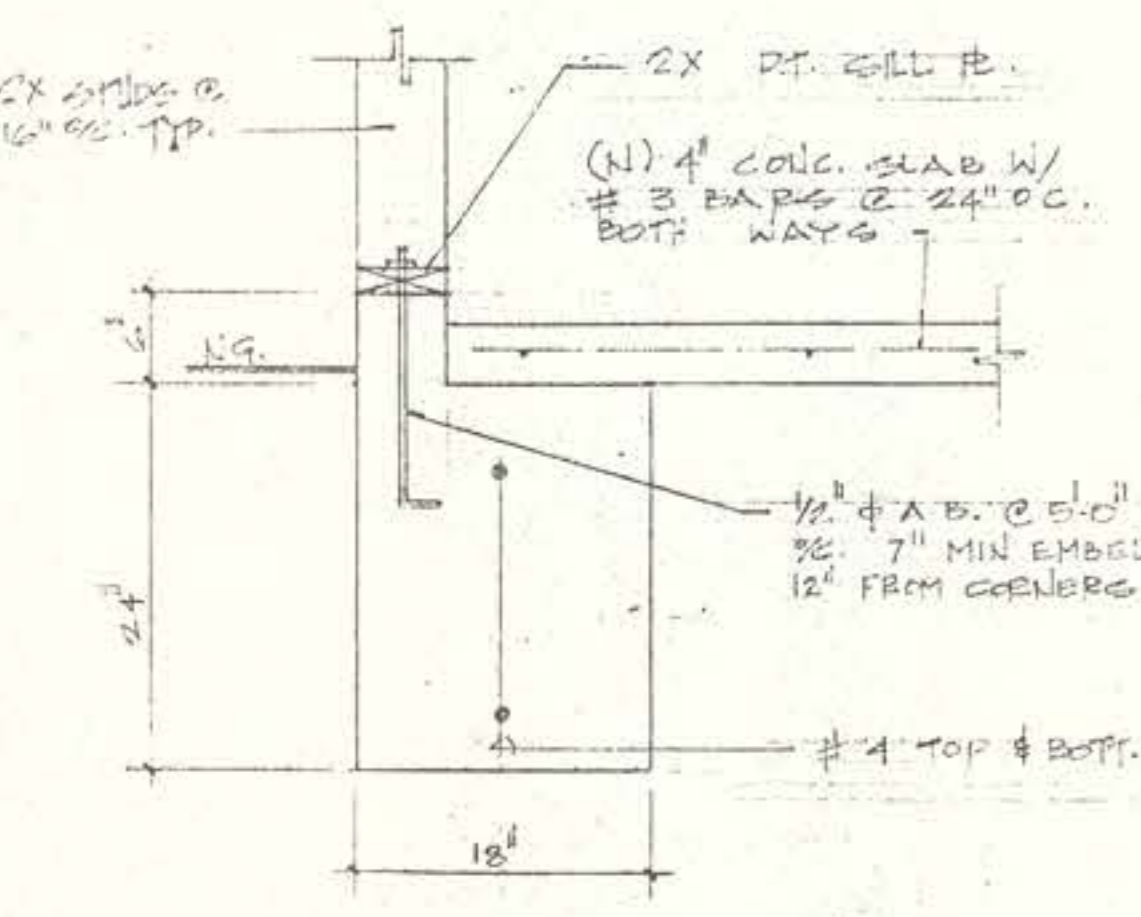

DETAIL # 11

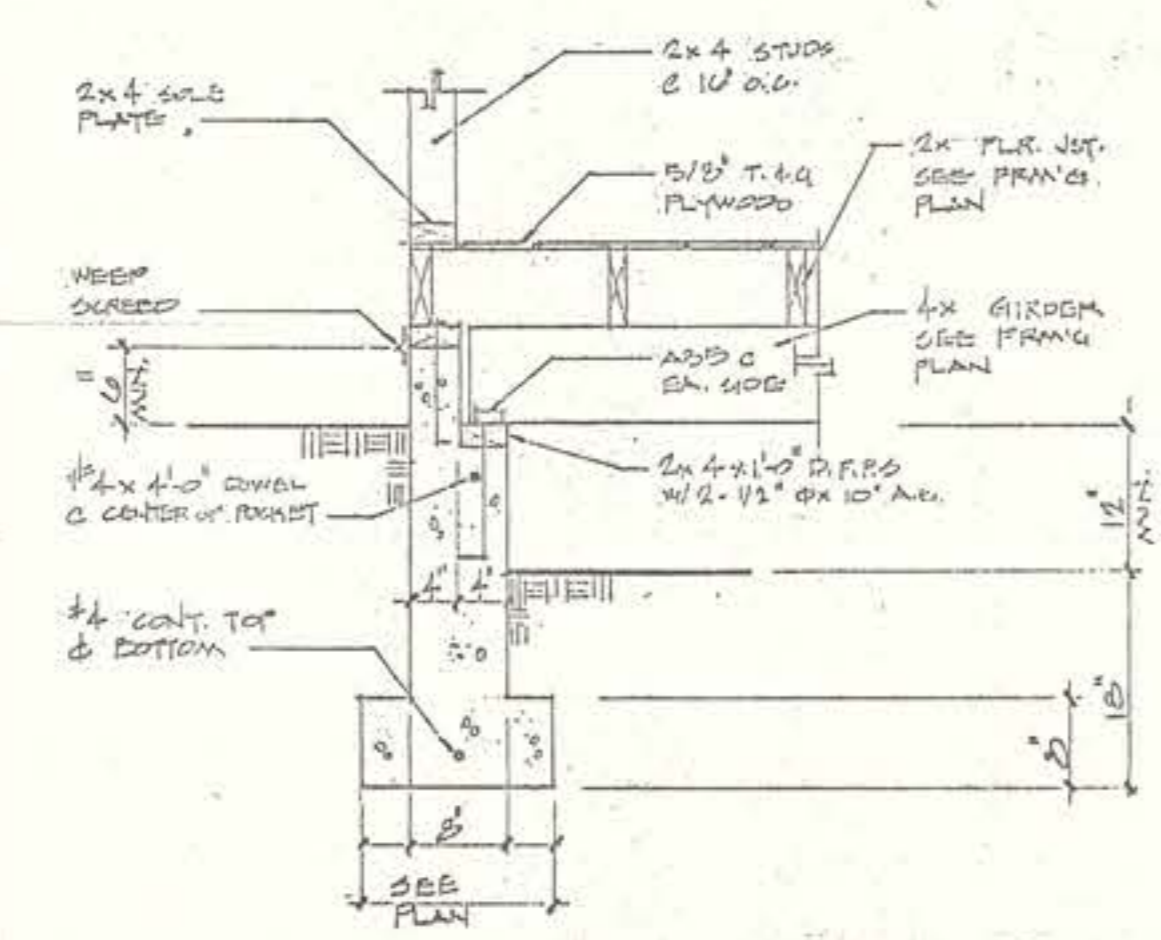

DETAIL # 7

revision
 david c. breiholz
 david c. breiholz & company
 DESIGN ENGINEERING ARCHITECTS

sheet description
 FOUNDATION PLAN, AS-BUILT
 All rights, designs and drawings indicated or represented by this drawing are the property of David C. Breiholz & Co., and were created and developed for use on and in connection with the project and shall not be used for any other project without the written consent of David C. Breiholz & Co.

project description
 MR. LOTHER MAERTENS
 19 NARCISIA DRIVE
 RANCHO PALOS VERDES, CA 90274
 408-1525

date
 scale 1/8\"/>