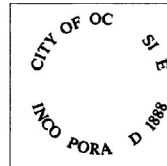


ADMINISTRATIVE COASTAL DEVELOPMENT PLAN APN 148-012-05-00

SHOSHONE ST LOT 8 RESIDENCE WEST

	CITY OF OCEANSIDE Building Division 300 N Coast Highway Oceanside, CA 92054 760-435-3950	I.B. 127 2019 California Building Code 1/1/2020 - 12/31/2022 Effective Date
--	---	--

STATEMENT OF SPECIAL INSPECTIONS INFORMATION BULLETIN

PURPOSE
The purpose of this bulletin is to specify how to remain in compliance with 2019 CBC chapter 17, **Special Inspections and Tests**, when special inspections are mandated by the Engineer of Record on a project within the City of Oceanside.

POLICY
When a special inspection is mandated, a Statement of Special Inspections form shall be printed on the cover sheet of the approved set of plans. The Statement of Special Inspections form is to be completed and signed prior to being printed into the project plans. The plan must be revised accordingly if the Statement of Special Inspections changes, i.e., a change in special inspector(s) or special inspection agency during the construction process.

BACKGROUND
If the registered design professional requires special inspection on a project, 2019 CBC Section 1704.3, Statement of Special Inspections, and Section 1705, Required Special Inspections and Tests, require the registered design professional to prepare a Statement of Special Inspections. The statement is to be approved by the Building Official PRIOR to the issuance of the building permit.

The Statement of Special Inspections must designate the portions of the work that require special inspection, the name or names of the individuals or firms who are to perform the special inspections, and indicate any additional duties of the special inspectors.

When structural observations are required by CBC Section 1704.6, the Statement of Special Inspections shall name the individuals or firms who are to perform structural observations and describe the stages of construction at which structural observations are to occur. Structural observations are to be performed by the registered design professional or a designated representative with prior approval by the Building Official.

PROCEDURE
A special inspector/special inspection agency shall be chosen to perform special inspections on the project. The architect or engineer of record shall imprint onto the plans a completed Statement of Special Inspections reflecting special inspections needed on the project. Plan approval shall be contingent on approval of the imprinted Statement of Special Inspections.

The owner or the architect/engineer of record will be responsible for employing the special inspector(s) (contractors may not employ the special inspector).

Special Inspectors shall check in with the city, present their credentials, and be approved at least 24 hours Prior to beginning work on the job site.

Special inspectors shall conform to, at a minimum, the guidelines contained in the City of Oceanside Procedures for Special Inspection.


a minimum of 65% of nonhazardous construction and demolition debris shall be recycled or salvaged for reuse in accordance with either Section 4.408.2, 4.408.3, or 4.408.4, or meet a more stringent local construction and demolition waste management ordinance.

1. The discharge of pollutants to any storm drainage system is prohibited. No solid waste, petroleum byproducts, soil particulates, construction waste materials, or wastewater generated on construction sites or by construction activities shall be placed, conveyed, or discharged into the street, gutter or storm drain system.
2. Buildings shall be provided with approved address identification in accordance with Section R319 of the 2022 California Residential Code.
3. The finish grade and impervious surfaces shall drain away from the foundation walls at a minimum slope of 2% or shall fall 6 inches within the first ten feet where possible.
4. A Foundation Forms Certification that is certified by a licensed land surveyor will be required to be provided to the building inspector at the first footing inspection.

Submission of PV solar plans for the ADU in accordance with the CF1R form is required prior to permit issuance. The solar PV solar permit must be completed prior to the final inspection of the ADU. Note on the plan that the PV solar plans will be submitted on a separate building permit and will be finalized prior to final inspection of the ADU.

LOT COVERAGE:

LOT 8 AREA = 4997 SF
(P) JADU AREA = 447 SF + (E) RES AREA = 1st 679 + 2nd 1126 SF + 626 SF ADU = 2896 SF HABITABLE
TOTAL (P) AREA = 2896 SF / 4998 SF = 57.95% COVERAGE > 40%
PROPERTY SERVED BY SEWER, ELECTRICAL GRID, NAT GAS SERVICE

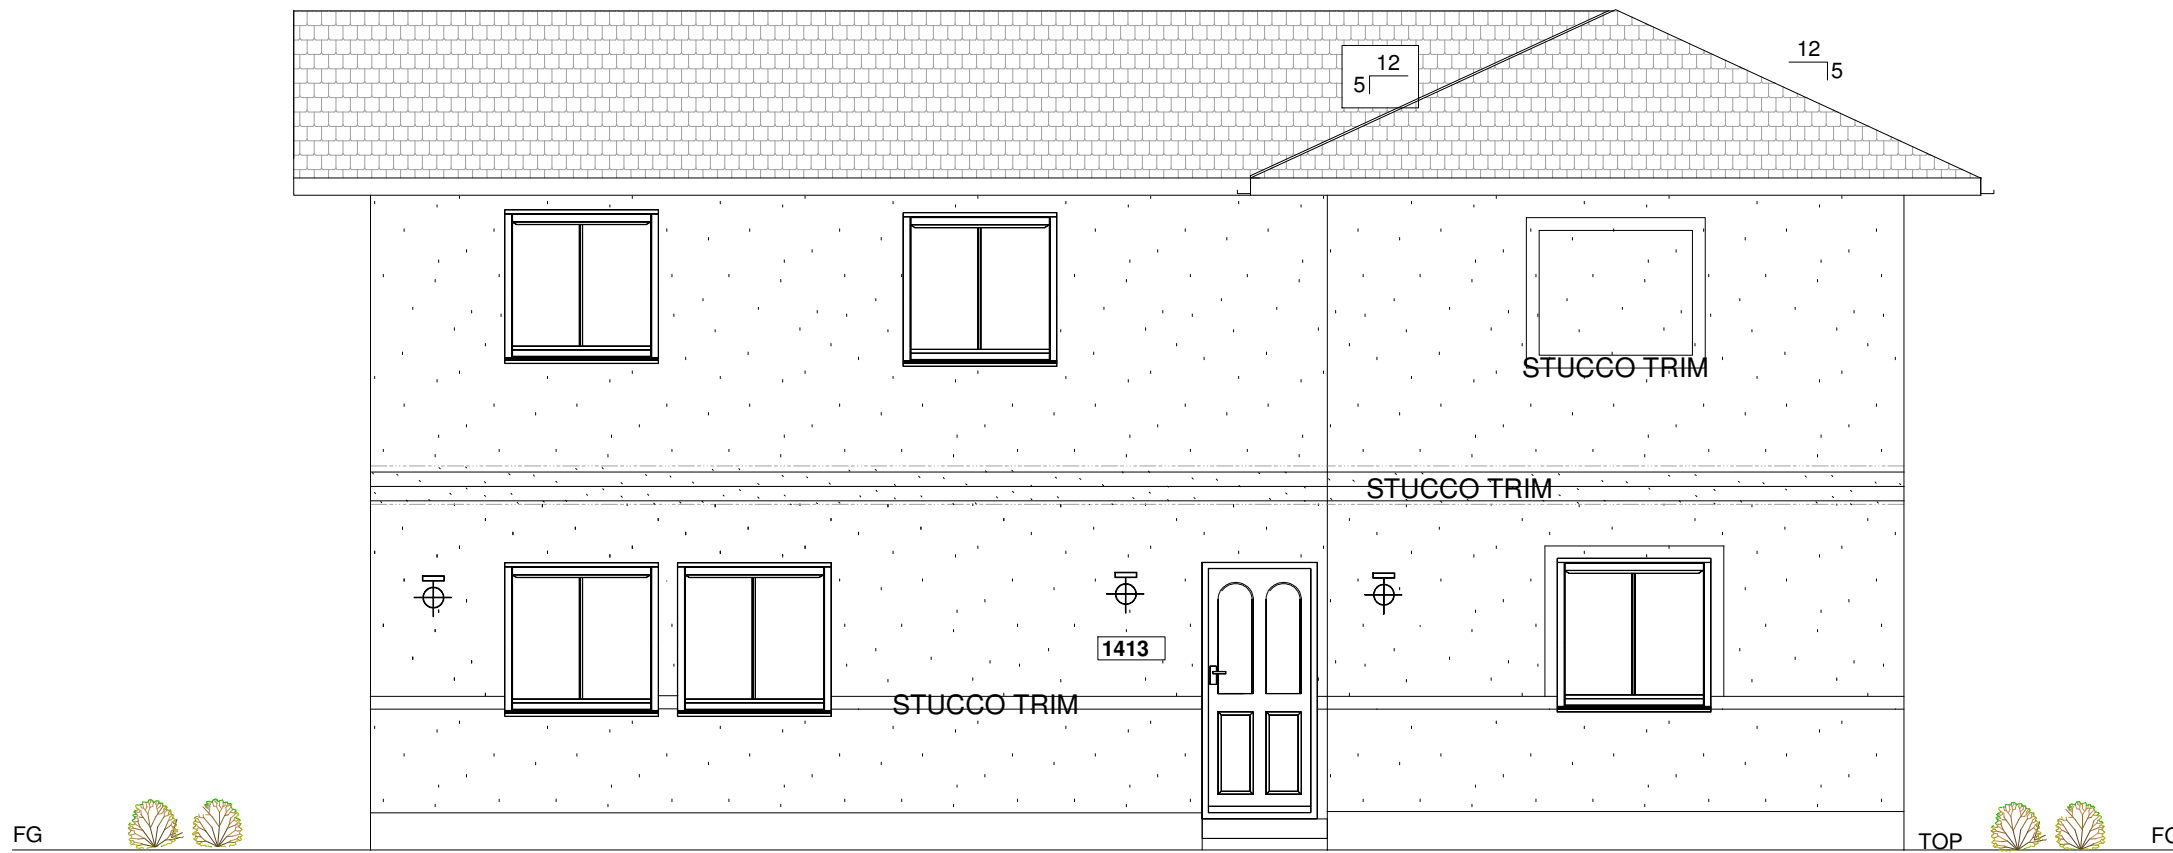

Footing Depth and location within native soil is to be verified by a geotechnical engineer. Report of verification is to be provided to the building inspector at footing inspection.



DEFERRED SUBMITTALS

1. Photovoltaic system to be deferred submittal under separate permit.
2. Fire sprinklers to be deferred submittal under separate permit.

- NO GAS LINE ALLOWED UNDER HOUSE, PATIO COVER, DECK, OVERHANG OR ROOF EAVES
 - NO MATERIAL OR EQUIPMENT TO BE STORED IN STREET R.O.W.
 - STORMWATER BMP PRACTICES TO BE IN PLACE DURING EXCAVATION
 - DIMENSIONS TAKE PRECEDENTS OVER SCALING.
- COUNTY STANDARD DRAWING ARE A PART OF THIS PLAN

LOT COVERAGE:

LOT 8 AREA = 4997 SF
(P) JADU AREA = 447 SF + (E) RES AREA = 1st 679 + 2nd 1126 SF + 626 SF ADU = 2878 SF HABITABLE
TOTAL (P) AREA = 2896 SF / 4998 SF = 57.59% COVERAGE > 40%
PROPERTY SERVED BY SEWER, ELECTRICAL GRID, NAT GAS SERVICE

BUILDING CODE ANALYSIS

DESCRIPTION OF USE: SINGLE FAMILY RESIDENCE
OCCUPANCY: R-3

NUMBER OF STORIES: THREE STORY
TYPE OF CONSTRUCTION: TYPE VB
SPRINKLERED: SPRINKLERED? YES DEFERRED
NEW FLOOR AREA: 3 Story 2878 SF HABITABLE

BUILDING HEIGHT: 32'-0"

PROJECT INFORMATION

PROJECT DATA
OWNER NAME: THE JESSICA AND KRISTINA BRANDT LIVING TRUST
OWNERS ADDRESS: 3512 EL PASO ALTO VISTA, CA. 92084

SITE ADDRESS: 1413 SHOSHONE ST., OCEANSIDE, CA. 92058

LEGAL INFO:
LEGAL DESCRIPTION:
LOTS 7 & 8, BLOCK 8, OF REESE'S ADDITION, IN THE CITY OF OCEANSIDE, COUNTY OF SAN DIEGO, STATE OF CALIFORNIA, ACCORDING TO THE MAP THEREOF NO. 324, FILED IN THE OFFICE OF THE COUNTY RECORDER OF SAN DIEGO COUNTY, SEPTEMBER 2, 1887.

ZONE R-3, MAX HEIGHT = 36'-0"

PROPERTY SERVED BY SEWER
PROPERTY SERVED BY NAT GAS
PROPERTY CONNECTED TO ELECTRICAL GRID

SCHOOL / UTILITY INFORMATION

FIRE DISTRICT: OCEANSIDE FIRE DEPT 760-435-4101
WATER DISTRICT: 619-670-2222
OCEANSIDE WATER DEPT 300 N COAST HWY OCEANSIDE, CA. 92054 760-435-3900

ELEMENTARY SCHOOL:
LAUREL ELEMENTARY SCHOOL 1410 LAUREL ST OCEANSIDE, CA. 92054 760-966-4200

MIDDLE SCHOOL:
LINCOLN MIDDLE SCHOOL 2000 CALIFORNIA ST OCEANSIDE, CA. 92054 760-901-8900

HIGH SCHOOL:
OCEAN SHORES HIGH SCHOOL 3131 OCEANSIDE BLVD OCEANSIDE, CA. 92054 800-644-6133

GAS & ELECTRIC:
SDG&E CO 4760 CLAIREMONT MESA DR SAN DIEGO, CA. 92117 800-644-6133

SYMBOLS

101 ROOM NUMBER REFERENCE
A DOOR REFERENCE
1 WINDOW REFERENCE
1 KEY NOTE REFERENCE
A BUILDING SECTION REFERENCE
7 INDICATES SECTION NUMBER
7 INDICATES SHEET ON WHICH SECTION IS SHOWN


7 DETAIL REFERENCE
7 INDICATES DETAIL NUMBER
7 INDICATES SHEET ON WHICH DETAIL IS SHOWN

CHANGE IN ELEVATION SYMBOL
A ELEVATION REFERENCE
7 INDICATES ELEVATION NUMBER
7 INDICATES SHEET ON WHICH ELEVATION IS SHOWN

City of Oceanside Building Division Requirements
Provide the following at requested foundation inspection:
☒ Geotechnical/Soils field evaluation/observation report
☐ concrete special inspection field evaluation report
☒ Surveyor's Form Board Elevation/Location report
☐ Other:
☐ Other:

TRUSS CALCS BY:
RAMONA LUMBER CO, INC.
425 MAPLE ST
RAMONA, CA. 92065
760-789-1080
JOB # 230003
ED@RAMONALUMBER.COM

VICINITY MAP

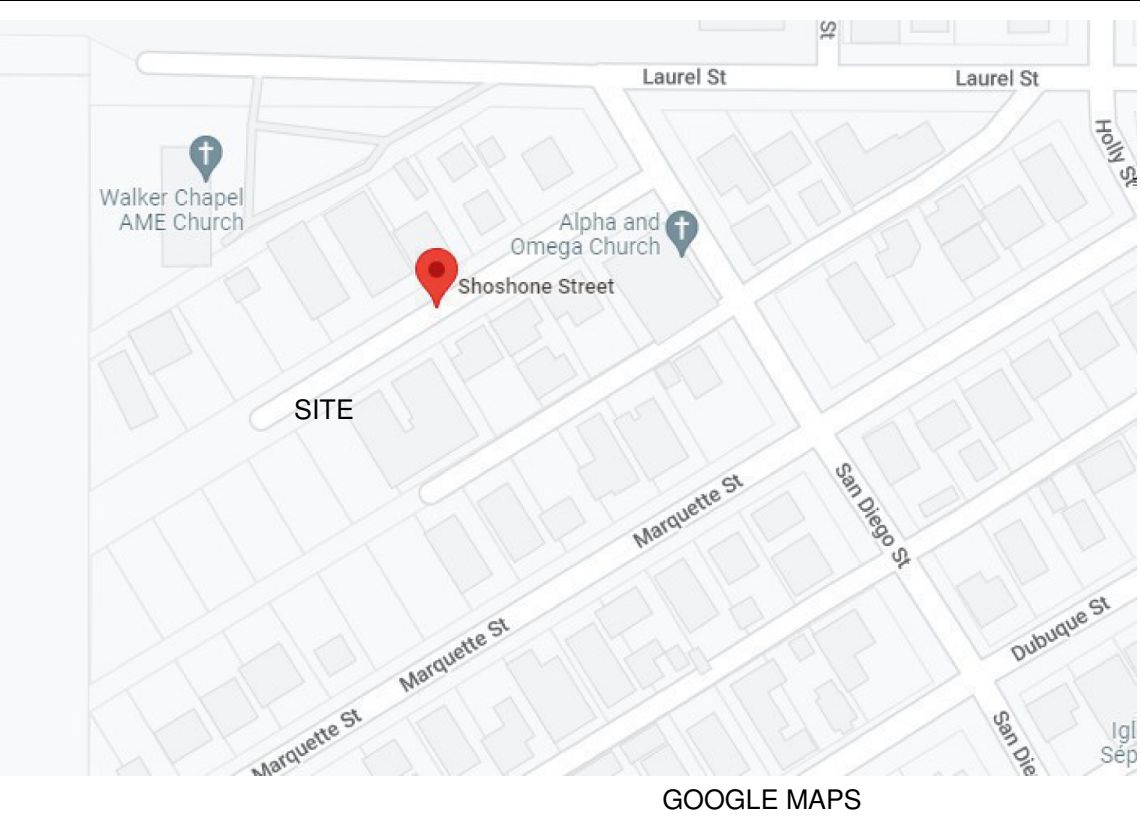

SHEET INDEX

A-0	COVER SHEET & PROPERTY INFO
A-1	SITE PLAN
A-2-0	FIRST FLOOR PLAN
A-2-1	SECOND FLOOR & ADU PLAN
A-3	EXTERIOR ELEVATIONS
A-4	BUILDING SECTIONS
A-5	ELECTRICAL PLAN, NOTES
A-6	MANUFACTURERS SHEET
AIA CA	2022 CBC REQ
CS-1	MINIMUM CONSTRUCTION SPECIFICATIONS
T24-1	TITLE 24
T24-2	TITLE 24
T24-3	TITLE 24
T24-M	TITLE 24 MANDATORY MEASURES
S-1	FOUNDATION PLAN
S-2	BASEMENT FLOOR FRAMING
S-3	FLOOR FRAMING
S-4	ROOF FRAMING
SD-1	DETAILS
SS	STRUCTURAL SPECS
SSD	STANDARD STRUCTURAL DETAILS
C1	CIVIL ENGINEERING FOOTPRINT PLAN

SCOPE OF WORK

NEW 3 STORY RESIDENCE W/ ADU, JADU 2,878 SF, 32' HIGH
4.5 BATHS, 8 BEDROOMS TOTAL

(P) 5' WIDE WOOD DECK & STAIRS AROUND SIDE & BACK OF
RESIDENCE FOR ENTRY ACCESS TO ADU. 370 SF

(P) 1ST FLR = 626 SF

(P) 2ND FLR = 1126 SF

(P) 3RD FLR = 1126 SF

TOTAL = 2,878 SF

CONSULTANTS

City of Oceanside Building Division
Reviewed for code compliance with the California Building Standards Codes and applicable City of Oceanside Codes and Ordinances
Arthur Cronin 07/17/2025 12:30:26 PM

STRUCTURAL ENGINEERING BY:
NADER'S DESIGN CONSULTING, INC.
5959 MISSION GORGE RD STE 203
SAN DIEGO, CA. 92120
619-284-1848
JOB # MJ-642-23
LIC NO. C-68179


GEOTECH ENG:
UES ENG CONSULTANTS
1441 MONTIEL RD STE 115
ESCONDIDO, CA. 92026
7-1-2025

CONTRACTOR:
Geotechnical information only
SAN DIEGO CONSTRUCTION & DEVELOPMENT INC.
DOMINIQUE ST. PIERRE
867 N. 2ND ST STE 2242
EL CAJON, CA. 92021
619-436-8579
LIC # B 1131213

CIVIL ENGINEER:
CIVIL LANDWORKS
110 COPPERWOOD WAY, STE P
OCEANSIDE, CA. 92058
760-908-8745
LIC. NO. C070066
DAVE@CIVILLANDWORKS.COM

SHOSHONE ST RESIDENCES
ADMINISTRATIVE COASTAL DEVELOPMENT PLAN
OCEANSIDE, CA. 92058

APN 148-012-05-00
LOT 8

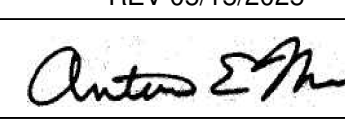JOB:	
DATE:	MAY 15, 2025
SHEET TITLE:	COVER SHEET & INFO
REVISIONS:	REV 05/15/2025
DESIGNERS SIGNATURE:	
SHEET A-0	

All work shall be done in accordance with the City of Oceanside Municipal code which include amendments to the 2022 California Code of Regulations.


Note: Building permit applications submitted on or after January 1, 2023 shall comply with the following codes:

1. 2022 Edition of the California Building Code
2. 2022 Edition of the California Residential Code
3. 2022 Edition of the California Mechanical Code
4. 2022 Edition of the California Plumbing Code
5. 2022 Edition of the California Electrical Code
6. 2022 Edition of the California Fire Code
7. 2022 Edition of the California Green Building Standard
8. 2022 Edition of the California Energy Code


DRAWN BY: MONTI
DRAWING NO: 20250515-01

ADMINISTRATIVE COASTAL DEVELOPMENT PLAN APN 148-012-05-00
SHOSHONE ST LOT 8 RESIDENCE WEST

1413 SHOSHONE ST

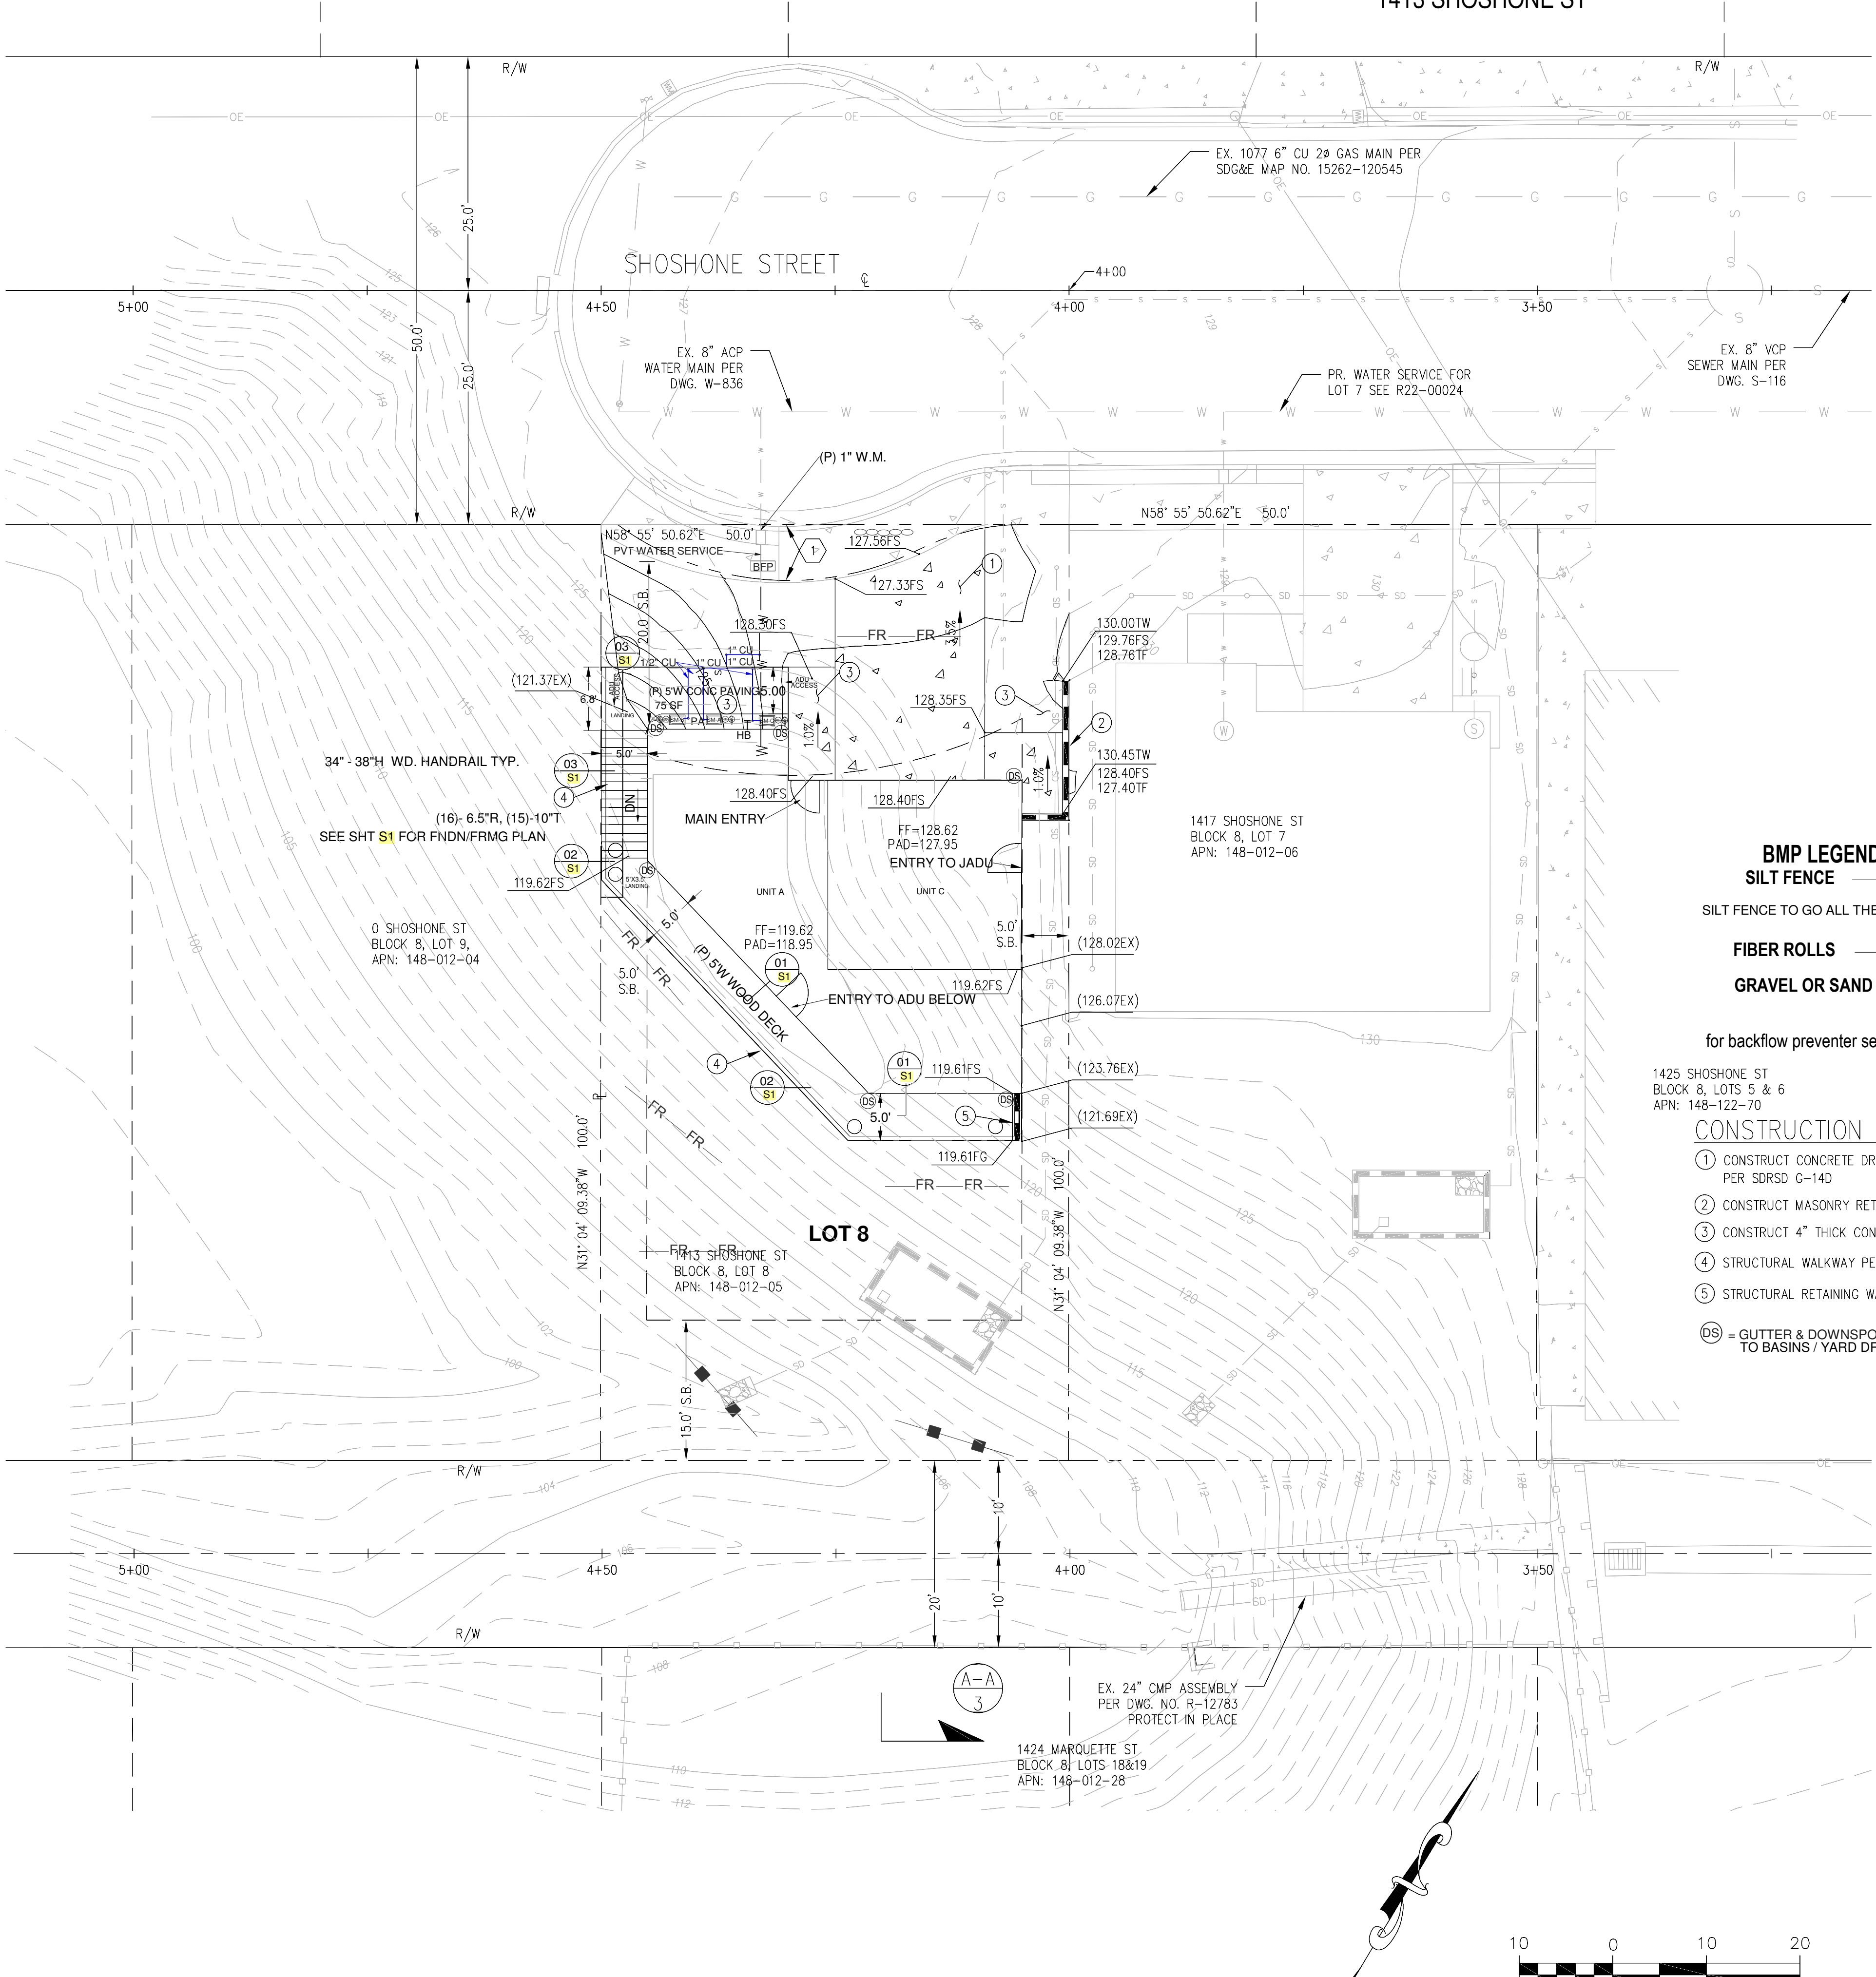

EQUIVALENT FIXTURE UNITS (Includes Combined Hot and Cold Water Demand)		Number of Fixture Units Per Fixture			
Types of Fixtures		Private Use	Public Use	Quantity	Total
Bar Sink		1	2	X	=
Bathtub (with or without shower over)		4	4	X	= 8
Dental unit or cuspidor		-	1	X	=
Drinking fountain (each head)		1	2	X	=
Hose bibb (standard type faucet)		2.5	5	X	= 2.5
House trailer (each)		6	6	X	=
Laundry tub or clothes washer		4	4	X	= 4
Lavatory		1	2	X	= 4
Lavatory (dental)		1	1	X	=
Lawn sprinklers (standard type each head)		1	1	X	= 4
Shower (each head)		2	4	X	=
Sink (bar)		1	2	X	=
Sink or dishwasher		1.5	4	X	= 7.5
Sink (flushing rim, clinic)		-	10	X	=
Sink (washup, each set of faucets)		-	2	X	=
Sink (washup, circular spray)		-	4	X	=
Toilet (flush tank)		2.5	5	X	= 10
Toilet (flushometer valve)		6	10	X	=
Urinal (pedestal or similar type)		-	10	X	=
Urinal (stall or wall)		-	5	X	=
Urinal (flush tank)		-	3	X	=
Other (please specify)		-	-	X	=
Water supply outlets for items not listed above shall be computed at their maximum demand, but in no case less than:					
3/8 inch		1	2	X	=
1/2 inch		2	4	X	=
3/4 inch		3	6	X	=
1 inch		6	10	X	=
TOTAL FIXTURE UNITS					40

Then measure the approximate distance between the water meter and the most distant fixture.
Insert distance in 55 feet from water meter to furthest fixture.

- BMP LEGEND**
- SILT FENCE
- SILT FENCE TO GO ALL THE WAY AROUND THE PERIMETER OF THE PROPERTY
- FIBER ROLLS
- GRAVEL OR SAND BAGS
- for backflow preventer see w-12 on sheet a-6

- 1425 SHOSHONE ST
BLOCK 8, LOTS 5 & 6
APN: 148-122-70
- CONSTRUCTION NOTES:**
- CONSTRUCT CONCRETE DRIVEWAY (FOR CONFINED RIGHT-OF-WAY) PER SDRSD G-14D
 - CONSTRUCT MASONRY RETAINING WALL PER SDRSD C-06
 - CONSTRUCT 4" THICK CONCRETE SIDEWALK PER GEOTECHNICAL RECOMMENDATIONS
 - STRUCTURAL WALKWAY PER OTHERS
 - STRUCTURAL RETAINING WALL PER OTHERS
- Ⓢ = GUTTER & DOWNSPOUT CONNECTED TO BASINS / YARD DRAINS

- ABBREVIATIONS**
- PL = PROPERTY LINE
CL = CENTER LINE
FG = FINISH GRADE
WL = WATERLINE
DA = DOOR ALARM REQ'D
PA = PLANTED AREA
TOS = TOP OF SLOPE
BOS = BOTTOM OF SLOPE
(E) = EXISTING
(P) = PROPOSED
(N) = NEW
FYSB = FRONT YARD SET BACK
SYSB = SIDE YARD SET BACK
RYSB = REAR YARD SET BACK
W.I. = WROUGHT IRON
C.L. = CHAIN LINK FENCE
FF = FINISH FLOOR ELEVATION
TOP = TOP OF PLATE
TOF = TOP OF FOOTING
BOF = BOTTOM OF FOOTING
TOW = TOP OF WALL
BOW = BOTTOM OF WALL
TBR = TO BE REMOVED
RBB = RAISED BOND BEAM
EP = EDGE OF PAVING
FS = FINISH SURFACE

(P) 1ST FLR = 679 SF
(P) 2ND FLR = 1126 SF
(P) JADU = 447 SF
(P) ADU = 626 SF
TOTAL = 2,896 SF

- NOTES:**
- ALL SPOILS TO GO TO AN APPROVED LANDFILL
 - NO GAS LINE ALLOWED UNDER HOUSE, PATIO COVER, DECK, OVERHANG OR ROOF EAVES
 - NO MATERIAL OR EQUIPMENT TO BE STORED IN STREET R.O.W.
 - STORMWATER BMP PRACTICES TO BE IN PLACE DURING EXCAVATION
 - DIMENSIONS TAKE PRECEDENTS OVER SCALING.
- LOT COVERAGE:**
- LOT 8 AREA = 4997 SF
(P) JADU AREA = 447 SF + (E) RES AREA = 1st 679 + 2nd 1126 SF + 626 SF ADU = 2896 SF HABITABLE
TOTAL (P) AREA = 2896 SF / 4998 SF = 57.95% COVERAGE > 40%
PROPERTY SERVED BY SEWER, ELECTRICAL GRID, NAT GAS SERVICE

- CONSTRUCTION NOTES:**
- CONSTRUCT CONCRETE DRIVEWAY (FOR CONFINED RIGHT-OF-WAY) PER SDRSD G-14D
 - CONSTRUCT CONCRETE PAVEMENT PER O.S.D. T-2
 - CONSTRUCT 4" THICK CONCRETE SIDEWALK PER GEOTECHNICAL RECOMMENDATIONS
 - CONSTRUCT FOUNDATION WALL PER SEPARATE PERMIT
 - CONSTRUCT MASONRY RETAINING WALL PER SDRSD C-04
 - CONSTRUCT NDS 6" CIRCULAR STORM WATER YARD INLET OR EQUIVALENT
 - CONSTRUCT NDS 12"x12" STORM WATER DRAINAGE CATCH BASIN OR EQUIVALENT
 - CONSTRUCT CONCRETE STAIRS
 - CONSTRUCT 6" HDPE SD
 - CONSTRUCT RIP RAP ENERGY DISSIPATER PER SDRSD D-40, TYPE 2, NO. 2 BACKING, T=1.1 FT
 - CONSTRUCT STRAIGHT HEADWALL - TYPE A PER SDRSD D-30, H=2'-8", L=5',
 - CONSTRUCT DETENTION BASIN
 - CONSTRUCT CONCRETE PATH
 - STORM DRAIN-RETAINING WALL INTERSECTION
 - SEWER EJECTION PUMP - SEE SHT A-6
 - SEWER EJECTION TANK - SEE SHT A-6

- EASEMENTS:**
- PROPOSED 6' R.O.W. DEDICATION
- EASEMENT NOTES:**
- PROPOSED 6' R.O.W. DEDICATION
- UTILITY NOTES:**
- CONSTRUCT 1" WATER SERVICE W/ METER PER R22-00025
 - CONSTRUCT 4" PVC SEWER SERVICE PER C.O.S. S-3
 - CONSTRUCT PVC SEWER CLEANOUT PER SDRSD SC-01 & SEWAGE BACKWATER VALVE ASSEMBLY PER C.O.S. S-4
 - 36" x 72" DEEP FIBERGLASS BASIN W/ SHIMAWA NORUS SERIES 50CR2.4S SEWER PUMP
 - 2" SEWER FORCEMAIN PER R22-00025
 - CONNECT TO EXISTING SEWER MANHOLE PER R22-00025

- 1" PRIVATE SUB METER W/ UNIT ID
MECH METER HORIZ INSTALL
PRESSURE REDUCER
SHUT OFF VALVE
APPROVED BACKFLOW PREVENTER

A PERMIT, SUPPLEMENTED WITH A TRAFFIC CONTROL PLAN, SHALL BE SUBMITTED TO THE CITY FOR ANY WORK WITHIN EXISTING CITY RIGHT-OF-WAY AND/OR EASEMENTS. TRAFFIC CONTROL DESIGN & PROCEDURES; AND TRAFFIC CONTROL WARNING SIGNS, LIGHTS AND DEVICES SHALL CONFORM TO THE CURRENT EDITION OF THE CALIFORNIA MANUAL ON UNIFORM TRAFFIC CONTROL DEVICES. THE CONTRACTOR IS REQUIRED TO SUBMIT A TRAFFIC CONTROL PLAN THAT MEETS THE CITY AND CALTRANS REQUIREMENTS. TRAFFIC CONTROL PLAN SHALL BE IN OPERATION FROM 9:00 A.M. TO 3:00 P.M., UNLESS OTHERWISE APPROVED.

City of Oceanside Building Division
Building Standards Codes and Ordinances
APR 17 2025 12:30:26 PM
SCALE: 1" = 10'



DRAW4U2@GMAIL.COM
442-333-8173

DESIGNERS SIGNATURE: *Antonio E Monti*
ANTONIO E MONTI



7-1-2025
Geotechnical information only

SHOSHONE ST RESIDENCES
ADMINISTRATIVE COASTAL DEVELOPMENT PLAN
OCEANSIDE, CA. 92058
APN 148-012-05-00
LOT 8

APPLICANT:
THE JESSICA AND KRISTINA BRANDT LIVING TRUST
3512 EL PASO ALTO
VISTA, CA 92084

LEGAL DESCRIPTION:
LOTS 8, BLOCK 8, OF REESE'S ADDITION IN THE CITY OF OCEANSIDE, COUNTY OF SAN DIEGO, STATE OF CALIFORNIA, ACCORDING TO THE MAP THEREOF NO. 324, FILED IN THE OFFICE OF THE COUNTY RECORDER OF SAN DIEGO COUNTY, SEPTEMBER 2, 1897.

APN 148-012-05-00
LOT 8

PROJECT ADDRESS: 1413 SHOSHONE ST
OCEANSIDE, CA. 92058

DATE: 03/25/2024
SHEET TITLE: SITE PLAN SCALE: 1" = 10'-0"
REVISIONS: 08/24/2022 HOUSE REVISED
04/23/2024 eng corr 02/11/2025 / 2
REV 07/13/2024 corrections water dept corr 02/11/2025 / 1

REV 05/15/2025

SHEET A-1

LOT 8 1413 SHOSHONE ST NEW 2 STORY RESIDENCE ADU JADU

MAY 15, 2025

BLDG24-0479

NOTES:

VENT NOTE:
ALL VENTS (ROOF, FOUNDATION, COMBUSTION AIR, ETC)
SHALL BE PROTECTED BY LOUVERES AND 1/8" NON-
COMBUSTIBLE CORROSION RESISTANT MESH

MECHANICAL EXHAUST FANS FROM BATHROOMS SHALL COMPLY WITH
THE FOLLOWING: (CAL GREEN 4.506.1)
ENERGY STAR COMPLIANT AND DUCTED TO TERMINATE OUTSIDE BUILDING
CONTROLLED BY READILY ACCESSIBLE HUMIDSTAT-UNLESS FAN
FUNCTIONS AS COMPONENT OF WHOLE HOUSE VENTILATION SYSTEM
- WITH CONTROLS CAPABLE OF ADJUSTMENT BETWEEN RELATIVE HUMIDITY
RANGE OF 50% TO 80%.

WALL COVERING IN SHOWER TO BE CERAMIC TILE, MIN. 70" ABOVE DRAIN
WITH A GREENBOARD WATERPROOF BACKING.
ANTI-SCALDING SHOWER VALVES REQUIRED

BATHROOM: LIGHTING FIXTURES AND SWITCHES SHOWN ON FLOOR PLAN
SHALL DEMONSTRATE THE FOLLOWING:

1. AT LEAST ONE HIGH EFFICACY FIXTURE SHALL BE INSTALLED IN EACH BATHROOM.
2. ALL OTHER BATHROOM LIGHTING SHALL BE HIGH EFFICACY OR CONTROLLED BY A VACANCY SENSOR.
3. GARAGES, LAUNDRY ROOMS, AND UTILITY ROOMS: LIGHTING SHALL BE HIGH EFFICACY AND CONTROLLED BY A VACANCY SENSOR.
4. ROOMS OTHER THAN KITCHENS, BATHROOMS, GARAGES, LAUNDRY ROOMS, OR UTILITY ROOMS: LIGHTING SHALL BE HIGH EFFICACY OR CONTROLLED BY A VACANCY SENSOR OR DIMMER.
5. OUTDOOR LIGHTING: ALL LIGHTING SHALL BE HIGH EFFICACY.

OUTDOOR LIGHTING SHALL BE HIGH EFFICACY LUMINAIRES
OR SHALL BE CONTROLLED BY A PHOTO/MOTION SENSOR COMBINATION.

GUTTERS AND DOWNSPOUTS SHALL BE CONSTRUCTED OF NON-COMBUSTIBLE
MATERIAL AND DESIGNED TO REDUCE ACCUMULATION OF LEAVES, LITTER & DEBRIS.
STUCCO & ROOF TILES COLOR MUST MATCH EXISTING RESIDENCE IN COLOR & TEXTURE

FAN IN BATHROOM TO BE CAPABLE
OF MIN. 5 AIR CHANGES PER HOUR.

VENT NOTE:
ALL VENTS (ROOF, FOUNDATION, COMBUSTION AIR, ETC)
SHALL COMPLY WITH THE COUNTY BLDG CODE 92.1.706A.1:
PROTECTED BY LOUVERES AND 1/8" NON-COMBUSTIBLE
CORROSION RESISTANT MESH

Glazing in doors are safety glazing material in accordance with Section R308.4:
Receptacle outlet locations will comply with CEC Article 210.52
Water conserving fixtures: New water closets shall use no
more than 1.28 gallons of water per flush, kitchen faucets may not exceed 1.8
GPM, lavatories are limited to 1.2 GPM, and showerheads may not exceed 1.8
GPM of flow. CPC Sections 407, 408, 411, 412.

FIXTURE TYPE MAXIMUM FLOW RATE

Water closets 1.28 gallons/flush
Urinals (wall-mounted) 0.125 gallon/flush
Urinals (others) 0.5 gallon/flush
Showerheads 1.8 gpm @ 80 psi
Lavatory faucets 1.2 gpm @ 60 psi
Kitchen faucets 1.8 gpm @ 60 psi
Metering faucets 0.25 gallons per cycle
1. Lavatory faucets shall not have a flow rate less than 0.8 gpm at 20 psi.
When a shower is provided with multiple shower heads,
the sum of flow to all the heads shall not exceed 1.8 gpm (ii) 80 p.s.i. or the
shower shall be designed so that only one head is on at all time. CGC Section
3.303.1.3.2.

"A mechanical exhaust ventilation system, supply ventilation or combination thereof
shall be installed for each dwelling unit to provide whole-building ventilation with outdoor
air in compliance with ASHRAE Standard 62.2 as adopted by the California Energy Commission."

"An intermittently or continuously operating local mechanical exhaust ventilation system
shall be installed in each bathroom with a bathtub, shower, or similar moisture source
and in each kitchen in compliance with ASHRAE Standard adopted by the California
Energy Commission. Intermittent local exhaust ventilation airflow rates shall be 50 cfm
in bathrooms and 100 cfm in kitchens. Continuous local exhaust ventilation airflow rates
shall be 20 cfm in bathroom & 5 air changes per hour in kitchens based on kitchen volume."

"The main electrical service panel shall include reserved space allowing for
installation of a circuit breaker for a future electric vehicle charging system. The reserved
space shall be permanently and visibly marked as "EV Capable."

"The main electrical service panel shall not be of a type with a center-fed main circuit
breaker and shall include reserved space allowing for installation of double-pole circuit
breakers for a future solar photovoltaic system. Such
reserved space shall be positioned at the opposite (load) end from the input feeder or
main circuit breaker location. The reserved space shall be permanently and visibly
marked as "For Future Solar Photovoltaic."

AN INTERMITTENTLY OR CONTINUOUSLY OPERATING LOCAL

MECHANICAL EXHAUST SYSTEM (WITH OUTDOOR AIR) SHALL BE INSTALLED IN
EACH KITCHEN AND BATHROOM COMPLYING WITH ASHRAE STANDARD 62.2-2007
AS ADOPTED BY THE CALIFORNIA ENERGY COMMISSION. INTERMITTENT LOCAL
VENTILATION EXHAUST AIRFLOW RATES SHALL BE 50 CFM IN BATHROOMS AND
100 CFM IN KITCHENS. CONTINUOUS LOCAL VENTILATION EXHAUST AIRFLOW
RATES SHALL BE 20 CFM IN BATHROOMS AND
5 ACH (AIR CHANGES PER HOUR) IN KITCHENS BASED ON KITCHEN VOLUME.
MECHANICAL EXHAUST FANS FROM BATHROOMS SHALL COMPLY WITH
THE FOLLOWING: (CAL GREEN 4.506.1)
ENERGY STAR COMPLIANT AND DUCTED TO TERMINATE OUTSIDE BUILDING
CONTROLLED BY READILY ACCESSIBLE HUMIDSTAT-UNLESS FAN
FUNCTIONS AS COMPONENT OF WHOLE HOUSE VENTILATION SYSTEM
- WITH CONTROLS CAPABLE OF ADJUSTMENT BETWEEN RELATIVE HUMIDITY
RANGE OF 50% TO 80%.

EXPOSED VALLEY FLASHING SHALL BE CONSTRUCTED WITH MIN 26 GAUGE CORROSION RESISTANT METAL
INSTALLED OVER MIN. 36 INCH WIDE SINGLE LAYER OF NO 72 ASTM CAP SHEET RUNNING FULL LENGTH
OF VALLEY.

ALL FLASHING AND COUNTER FLASHING TO BE INSTALLED BY ROOFING CONTRACTOR
ALL LUMBER SHALL BE GRADE DFL#2 OR BETTER U.N.O.

ROOF SHEATHING SHALL BE:

1/2" CDX PLYWOOD 24/0 PI
NAILS @ 6" O.C. B.N. & E.N.
8D COMMON NAILS @ 12" O.C.F.N.

"The inspector will recheck for expansive soils and/or grading requirements at first foundation inspection."

"The main electrical service panel shall not be of a type with a center-fed main
circuit breaker and shall include reserved space allowing for installation of double-pole circuit breakers for a future
solar photovoltaic system. Such reserved space shall be positioned at the opposite (load) end from the input feeder
or main circuit breaker location. The reserved space shall be permanently and visibly marked as "For Future Solar
Photovoltaic."

"Electrical junction box and segment of metallic raceway in the attic shall be
permanently and visibly marked as "For Future Solar Photovoltaic."

"The main electrical service panel shall include reserved space allowing for
installation of a circuit breaker for a future electric vehicle charging system. The reserved space shall be permanently
and visibly marked as "EV Capable."

"Roofing shall have a class A fire rating." (County Building Code 92.2.R902 and County
Building Code 92.1.1505.1)

exterior garage doors shall include weather stripping as necessary to reduce any gaps at the bottom, sides,
and top of the door to 1/8 inch or less. (CRC R337.8.4, CBC 708A.4)

Paper-faced insulation prohibited in attics or other ventilated spaces. (County Building Code 92.1.711A.1)

KEY NOTES

- 1 MIRROR, TYP
- 2 110V 75W LIGHT/FAN FIXTURE TYP.
- 3 SINK WHITE W/ CABINET LIGHT OAK FINISH
- 4 TOILET PAPER ROLL HOLDER CHROME FINISH
- 5 KOHLER BRAND ELONGATED TOILET LOW VOLUME
FLUSH WHITE, H.C. HEIGHT
- 6 SLIP RESISTANT CERAMIC TILE FLOOR - WHITE
- 7 6" X 6" C.T. W/ WOOD BASE
- 8 HEAT PUMP LOCATION 220V SEE SHT A-7 FOR SPECS
Mitsubishi Electric AC msysgl18na,
18k BTU, 20.5 SEER, above door
- 9 ROD & CURTAIN @ SHOWER
- 10 OHAGIN ROOF VENT 70 SQ INCHES EACH
- 11 STUCCO PER BLDG CODE
- 12 Rheem XE50T10H45U0
TANK ELECTRIC WATER HEATERS
- 13 MIN 22" X 36" ATTIC ACCESS
- 14 A/C CONDENSER LOCATION
- 15 (1) 200A ELECTRICAL PANEL
- 16 MIN 42" GRAB BAR
- 17 MIN 36" GRAB BAR
- 18 (2) 100A ELECTRICAL PANELS
- 19 Rheem TANKLESS RETEX 11
ELECTRIC WATER HEATER

DS GUTTERS & DOWNSPOUTS SEE SHT A5 FOR DETAIL

@ = ROOF VENTING WITH OHAGIN ROOF VENTS:
FIRE & ICE MODEL

(P) SOLAR PANELS

ROOF PLAN

1/4" = 1'-0"

EDGE OF ROOF



City of Oceanside Building Division
Reviewed for code compliance with the California
Building Standards Codes and applicable City of
Oceanside Codes and Ordinances
Arthur Cronin 07/17/2025 12:30:26 PM

City of Oceanside Building Division

NOTES:

VENT NOTE:
ALL VENTS (ROOF, FOUNDATION, COMBUSTION AIR, ETC)
SHALL BE PROTECTED BY LOUVERES AND 1/8" NON-COMBUSTIBLE CORROSION RESISTANT MESH
MECHANICAL EXHAUST FANS FROM BATHROOMS SHALL COMPLY WITH THE FOLLOWING: (CAL GREEN 4.506.1)
ENERGY STAR COMPLIANT AND DUCTED TO TERMINATE OUTSIDE BUILDING CONTROLLED BY READILY ACCESSIBLE HUMIDSTAT-UNLESS FAN FUNCTIONS AS COMPONENT OF WHOLE HOUSE VENTILATION SYSTEM
- WITH CONTROLS CAPABLE OF ADJUSTMENT BETWEEN RELATIVE HUMIDITY RANGE OF 50% TO 80%.

WALL COVERING IN SHOWER TO BE CERAMIC TILE, MIN. 70" ABOVE DRAIN WITH A GREENBOARD WATERPROOF BACKING.
ANTI-SCALDING SHOWER VALVES REQUIRED

BATHROOM: LIGHTING FIXTURES AND SWITCHES SHOWN ON FLOOR PLAN SHALL DEMONSTRATE THE FOLLOWING:

1. AT LEAST ONE HIGH EFFICACY FIXTURE SHALL BE INSTALLED IN EACH BATHROOM.
2. ALL OTHER BATHROOM LIGHTING SHALL BE HIGH EFFICACY OR CONTROLLED BY A VACANCY SENSOR.

GARAGES, LAUNDRY ROOMS, AND UTILITY ROOMS: LIGHTING SHALL BE HIGH EFFICACY AND CONTROLLED BY A VACANCY SENSOR.
ROOMS OTHER THAN KITCHENS, BATHROOMS, GARAGES LAUNDRY ROOMS, OR UTILITY ROOMS: LIGHTING SHALL BE HIGH EFFICACY OR CONTROLLED BY A VACANCY SENSOR OR DIMMER

OUTDOOR LIGHTING: ALL LIGHTING SHALL BE HIGH EFFICACY.

OUTDOOR LIGHTING SHALL BE HIGH EFFICACY LUMINAIRES OR SHALL BE CONTROLLED BY A PHOTO/MOTION SENSOR COMBINATION.

GUTTERS AND DOWNSPOUTS SHALL BE CONSTRUCTED OF NON-COMBUSTIBLE MATERIAL AND DESIGNED TO REDUCE ACCUMULATION OF LEAVES, LITTER & DEBRIS.
STUCCO & ROOF TILES COLOR MUST MATCH EXISTING RESIDENCE IN COLOR & TEXTURE

FAN IN BATHROOM TO BE CAPABLE OF MIN. 5 AIR CHANGES PER HOUR.

VENT NOTE:

ALL VENTS (ROOF, FOUNDATION, COMBUSTION AIR, ETC) SHALL COMPLY WITH THE COUNTY BLDG CODE 92.1.706A.1: PROTECTED BY LOUVERES AND 1/8" NON-COMBUSTIBLE CORROSION RESISTANT MESH

Glazing in doors are safety glazing material in accordance with Section R308.4: Recreational outlet locations will comply with CEC Article 210.52

Water conserving fixtures: New water closets shall use no more than 1.28 gallons of water per flush. Kitchen faucets may not exceed 1.8 GPM, lavatories are limited to 1.2 GPM, and showerheads may not exceed 1.8 GPM of flow. CPC Sections 407, 408, 411, 412.

FIXTURE TYPE MAXIMUM FLOW RATE

Water closets 1.28 gallons/flush

Urinals (wall-mounted) 0.125 gallon/flush

Urinals (others) 0.5 gallon/flush

Showerheads 1.8 gpm @ 80 psi

Lavatory faucets 1.2 gpm @ 60 psi

Kitchen faucets 1.8 gpm @ 60 psi


Metering faucets 0.25 gallons per cycle

1. Lavatory faucets shall not have a flow rate less than 0.8 gpm at 20 psi.

When a shower is provided with multiple shower heads, the sum of flow to all the heads shall not exceed 1.8 gpm (ii) 80 psi, or the shower shall be designed so that only one head is on at a time. CGC Section 4.503.1.3.2.

A mechanical exhaust ventilation system, supply ventilation shall be installed for each dwelling unit to provide whole building air in compliance with ASHRAE Standard 62.2 as adopted by the California Energy Commission.

AN INTERMITTENTLY OR CONTINUOUS OPERATING LOCAL MECHANICAL EXHAUST SYSTEM (WITH OUTDOOR AIR) SHALL BE INSTALLED IN EACH KITCHEN AND BATHROOM COMPLYING WITH ASHRAE STANDARD 62.2-2007 AS ADOPTED BY THE CALIFORNIA ENERGY COMMISSION. INTERMITTENT LOCAL VENTILATION EXHAUST AIRFLOW RATES SHALL BE 50 CFM IN BATHROOMS AND 100 CFM IN KITCHENS. CONTINUOUS LOCAL VENTILATION EXHAUST AIRFLOW RATES SHALL BE 20 CFM IN BATHROOMS AND 5 ACH (AIR CHANGES PER HOUR) IN KITCHENS BASED ON KITCHEN VOLUME. MECHANICAL EXHAUST FANS FROM BATHROOMS SHALL COMPLY WITH THE FOLLOWING: (CAL GREEN 4.506.1)
ENERGY STAR COMPLIANT AND DUCTED TO TERMINATE OUTSIDE BUILDING CONTROLLED BY READILY ACCESSIBLE HUMIDSTAT-UNLESS FAN FUNCTIONS AS COMPONENT OF WHOLE HOUSE VENTILATION SYSTEM
- WITH CONTROLS CAPABLE OF ADJUSTMENT BETWEEN RELATIVE HUMIDITY RANGE OF 50% TO 80%.

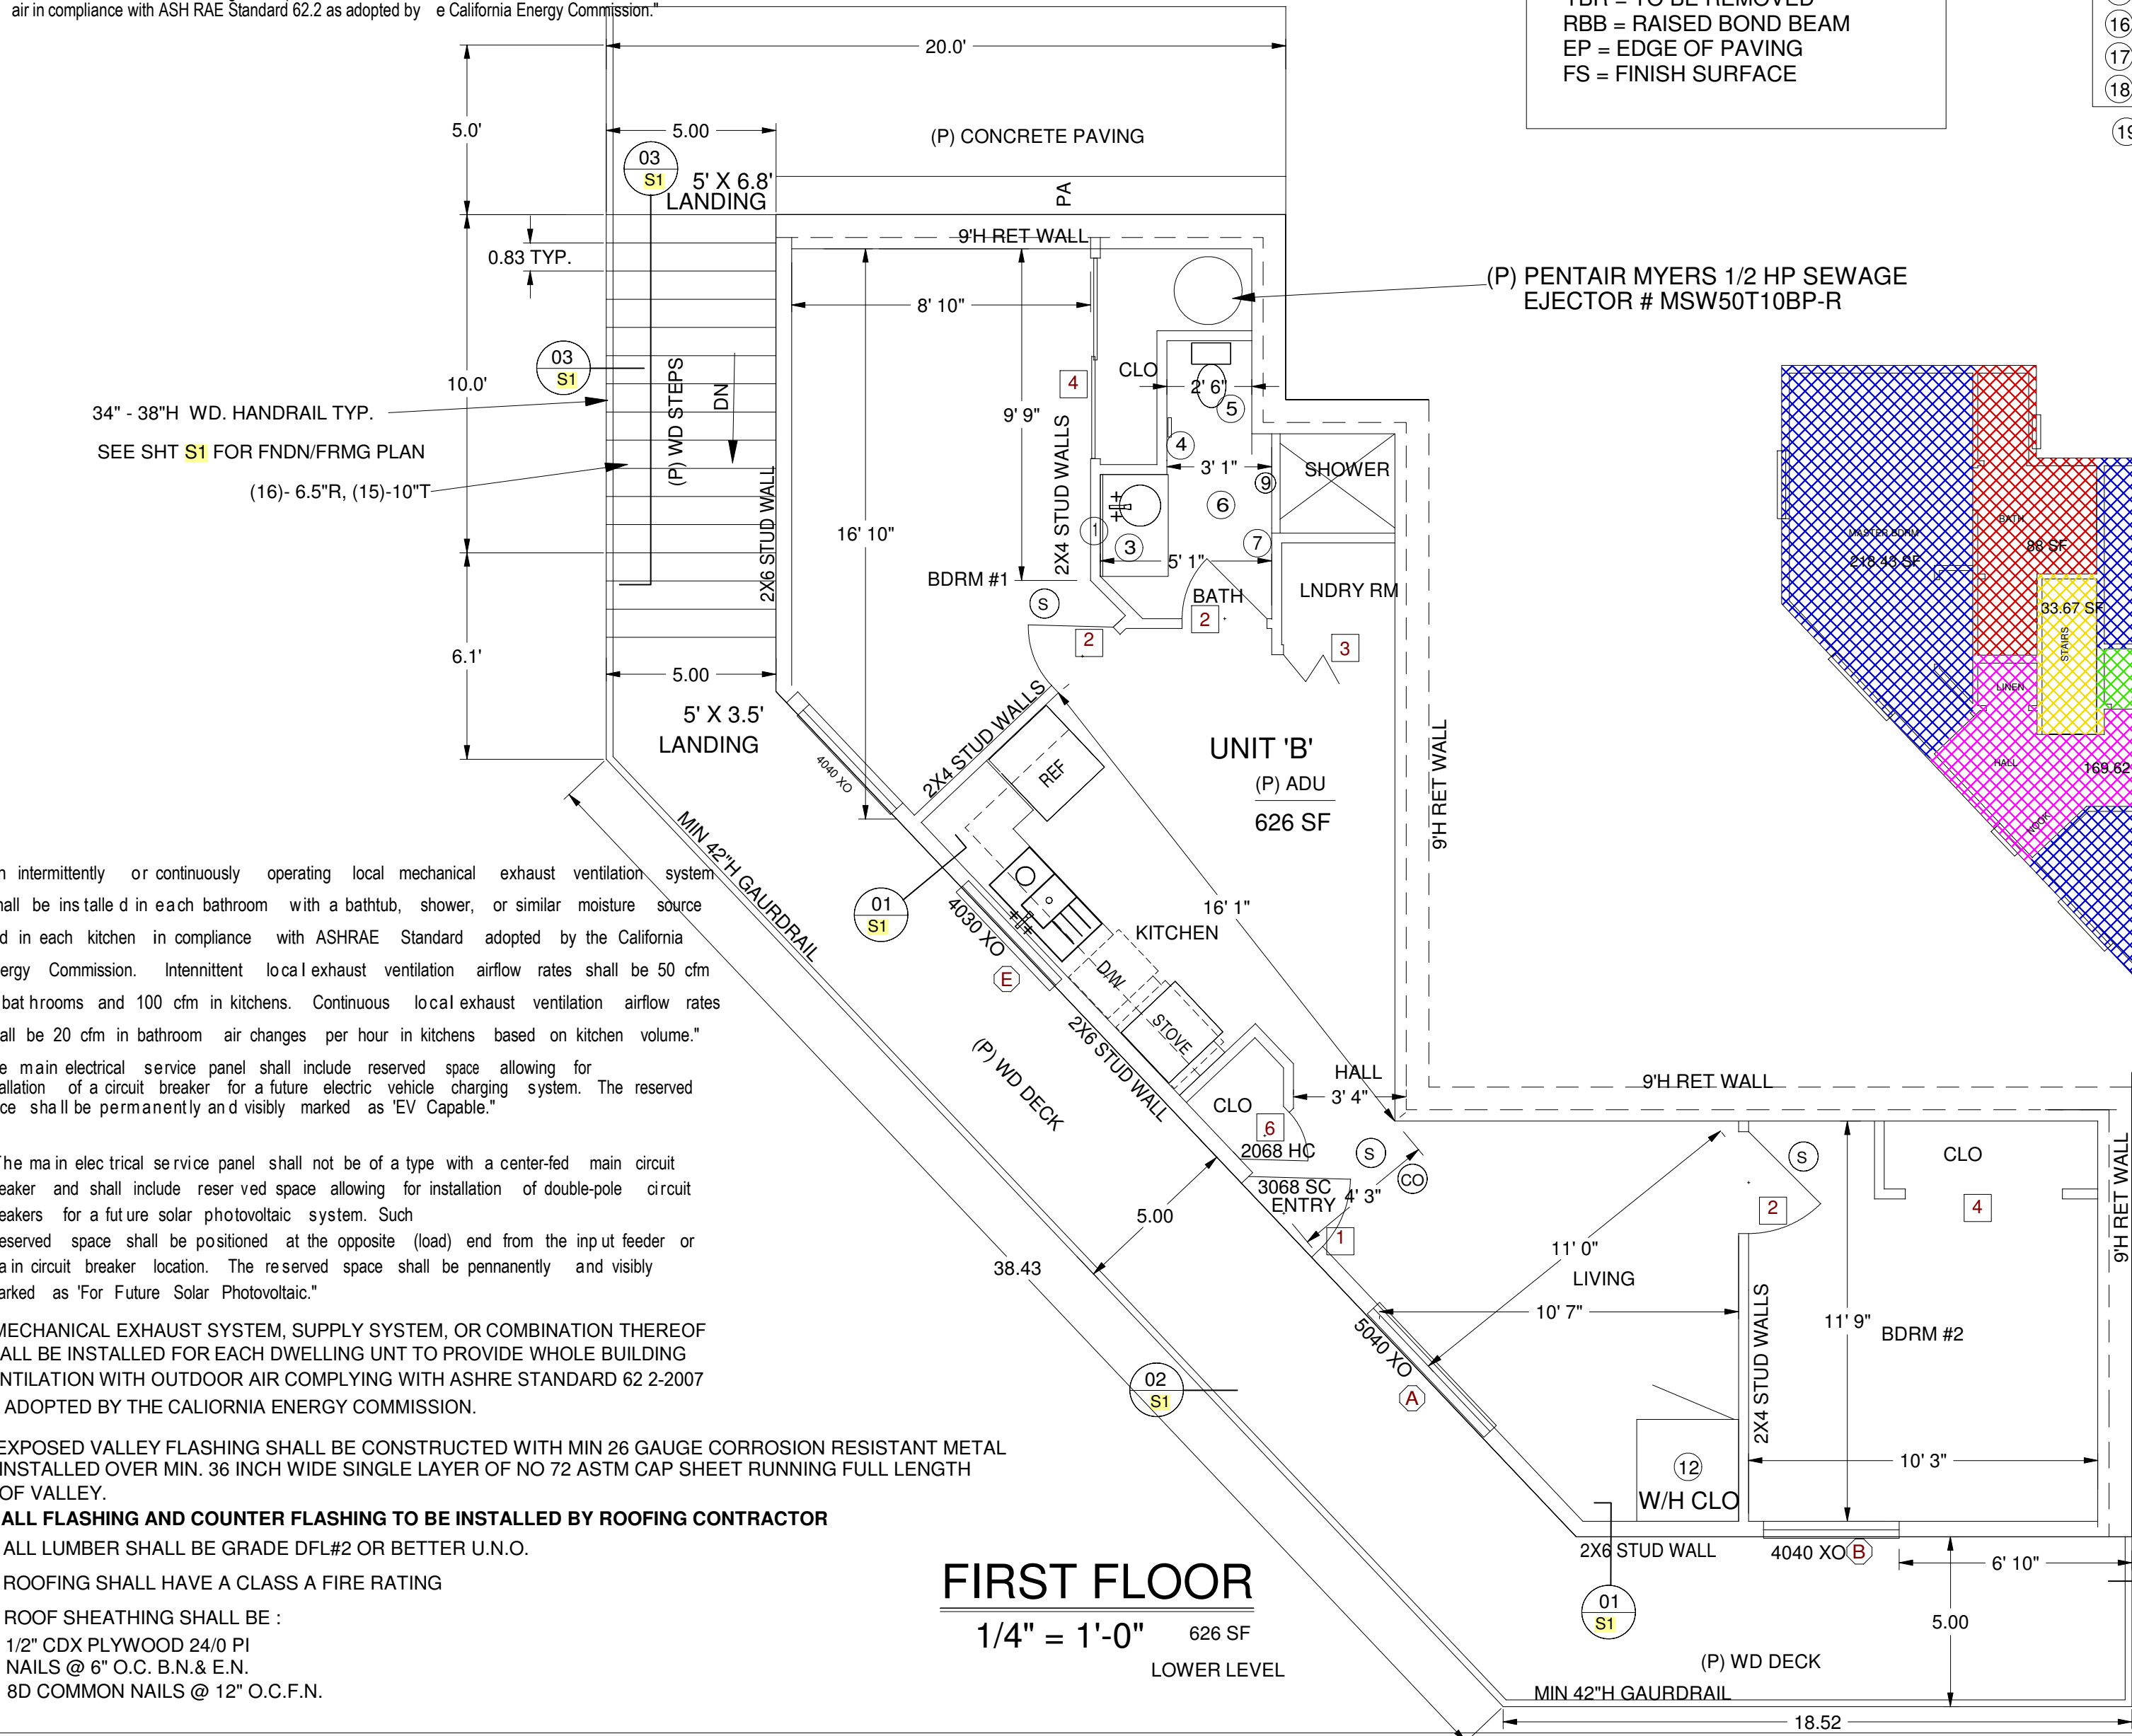

FIRST FLOOR

1/4" = 1'-0"

626 SF

LOWER LEVEL

18.52

5.00

6.10"

5.00

5.00

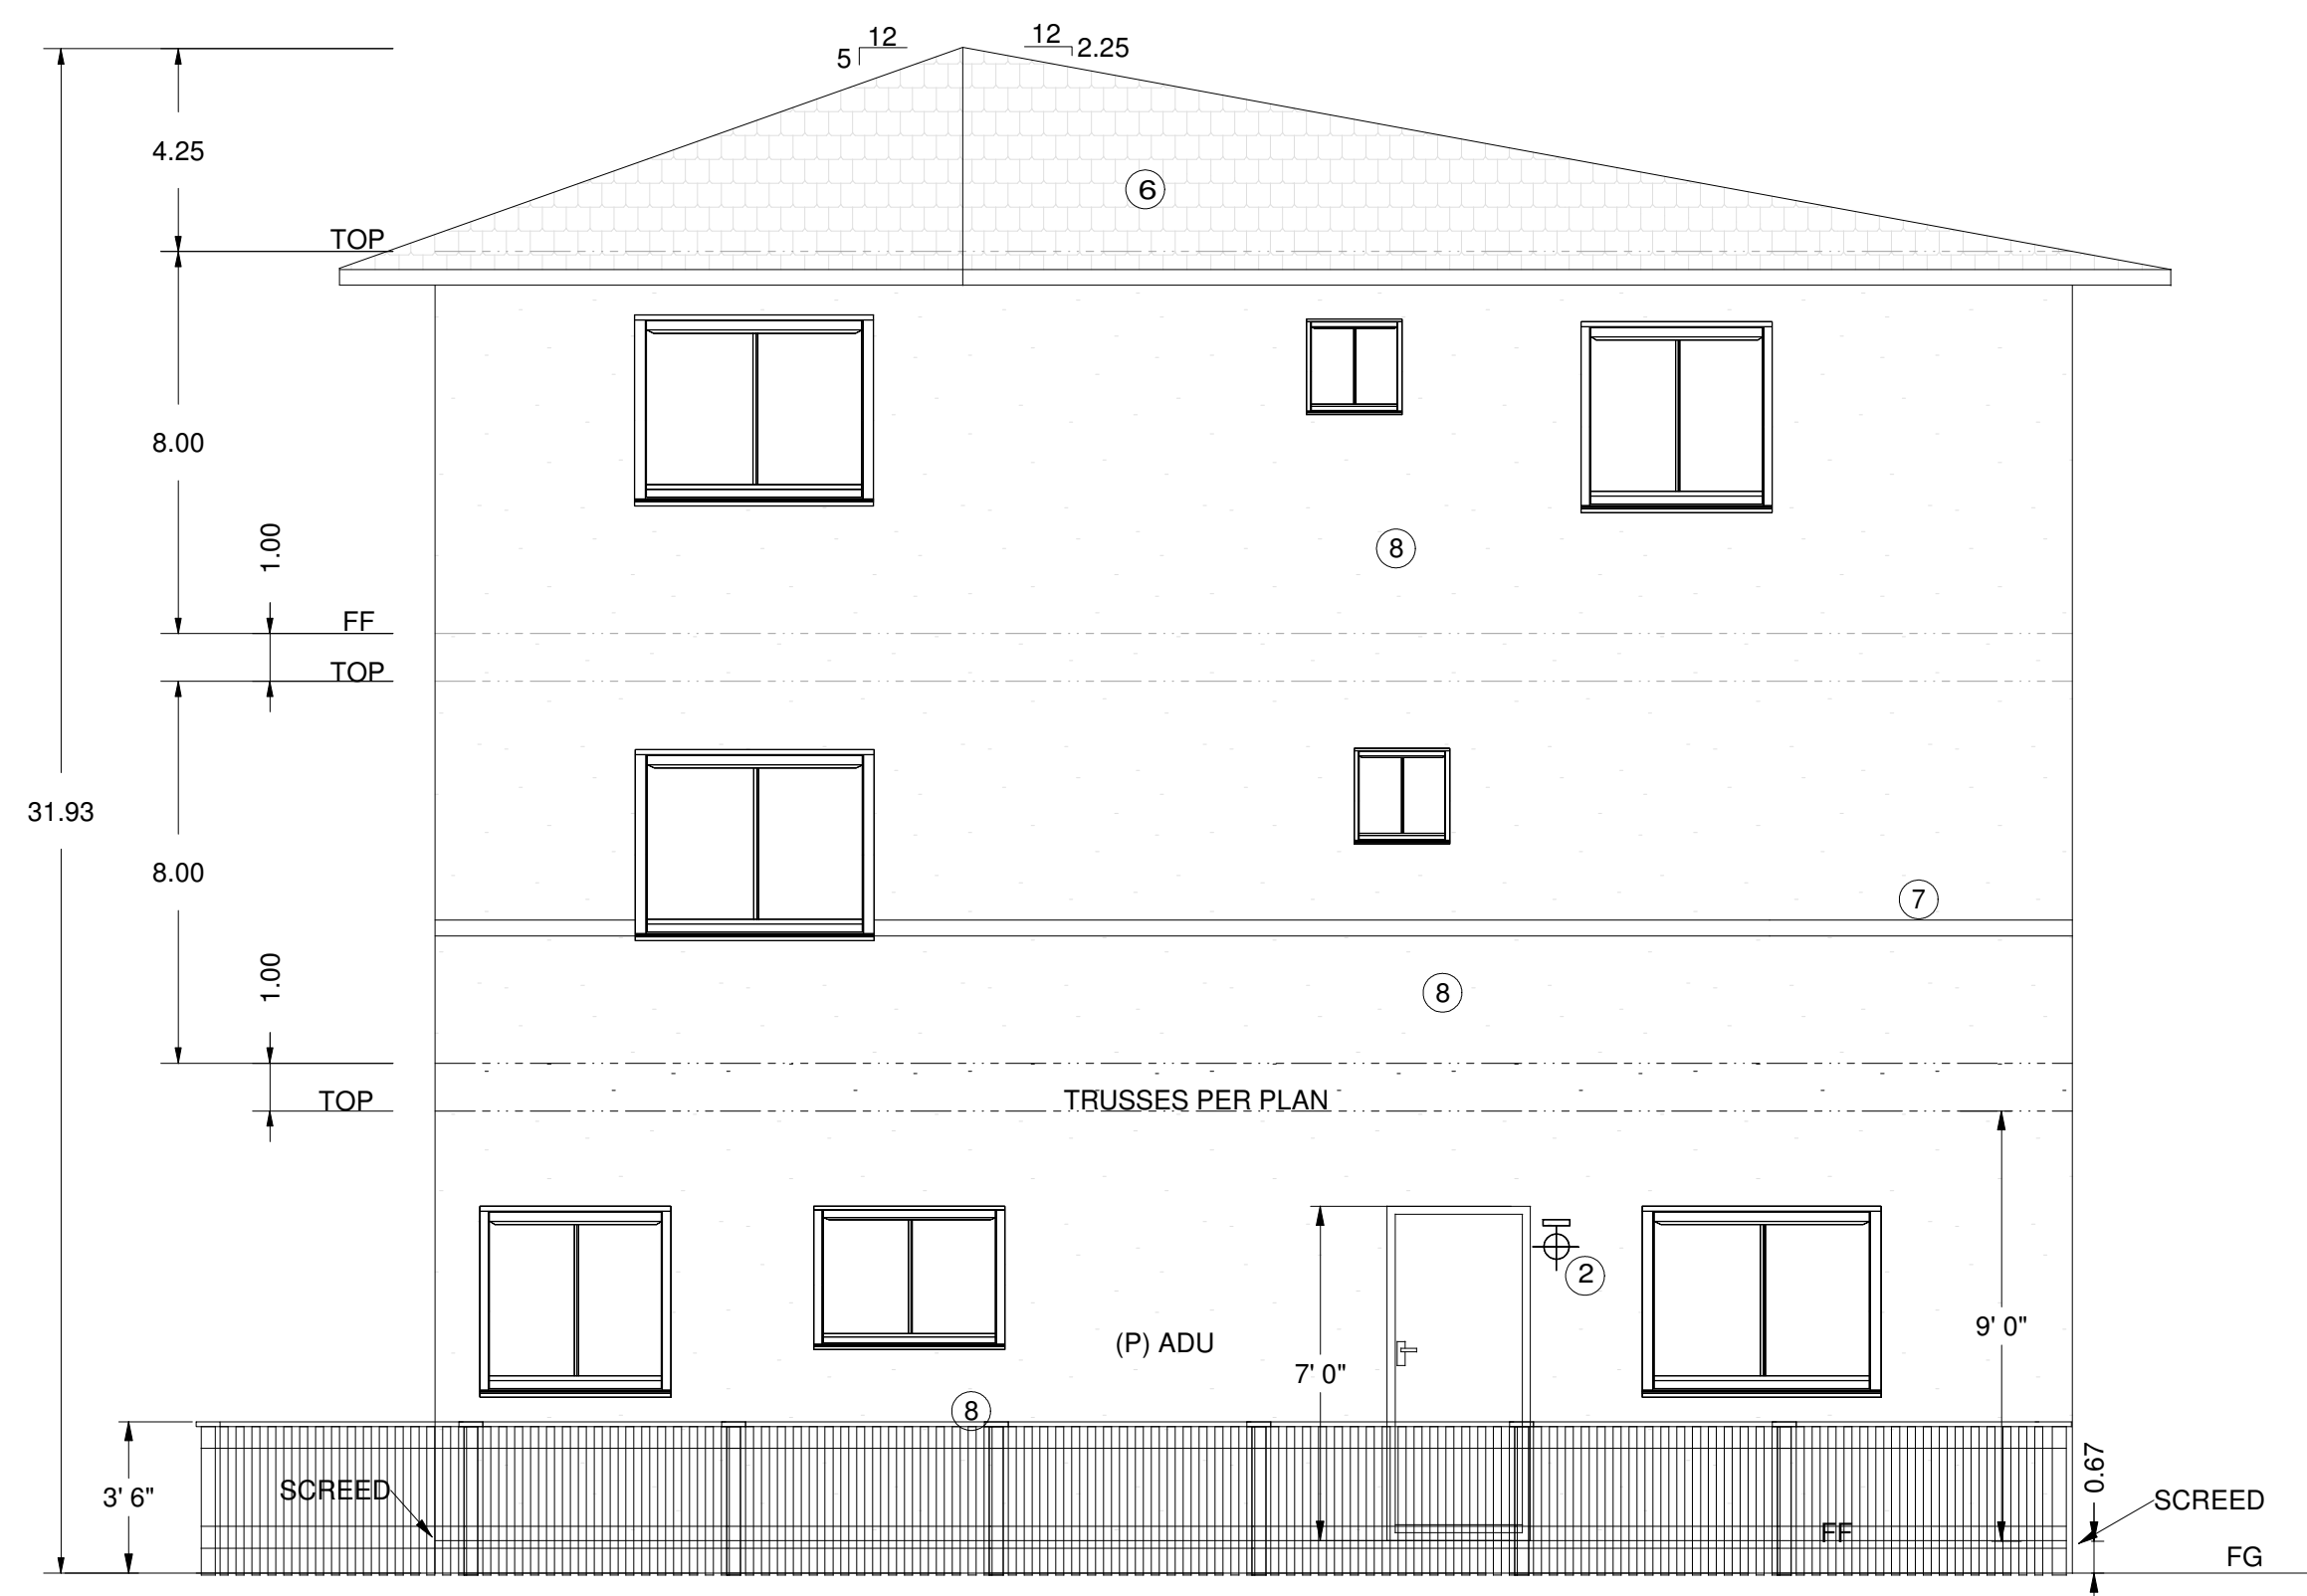


ELEVATION D
1/4" = 1'-0"

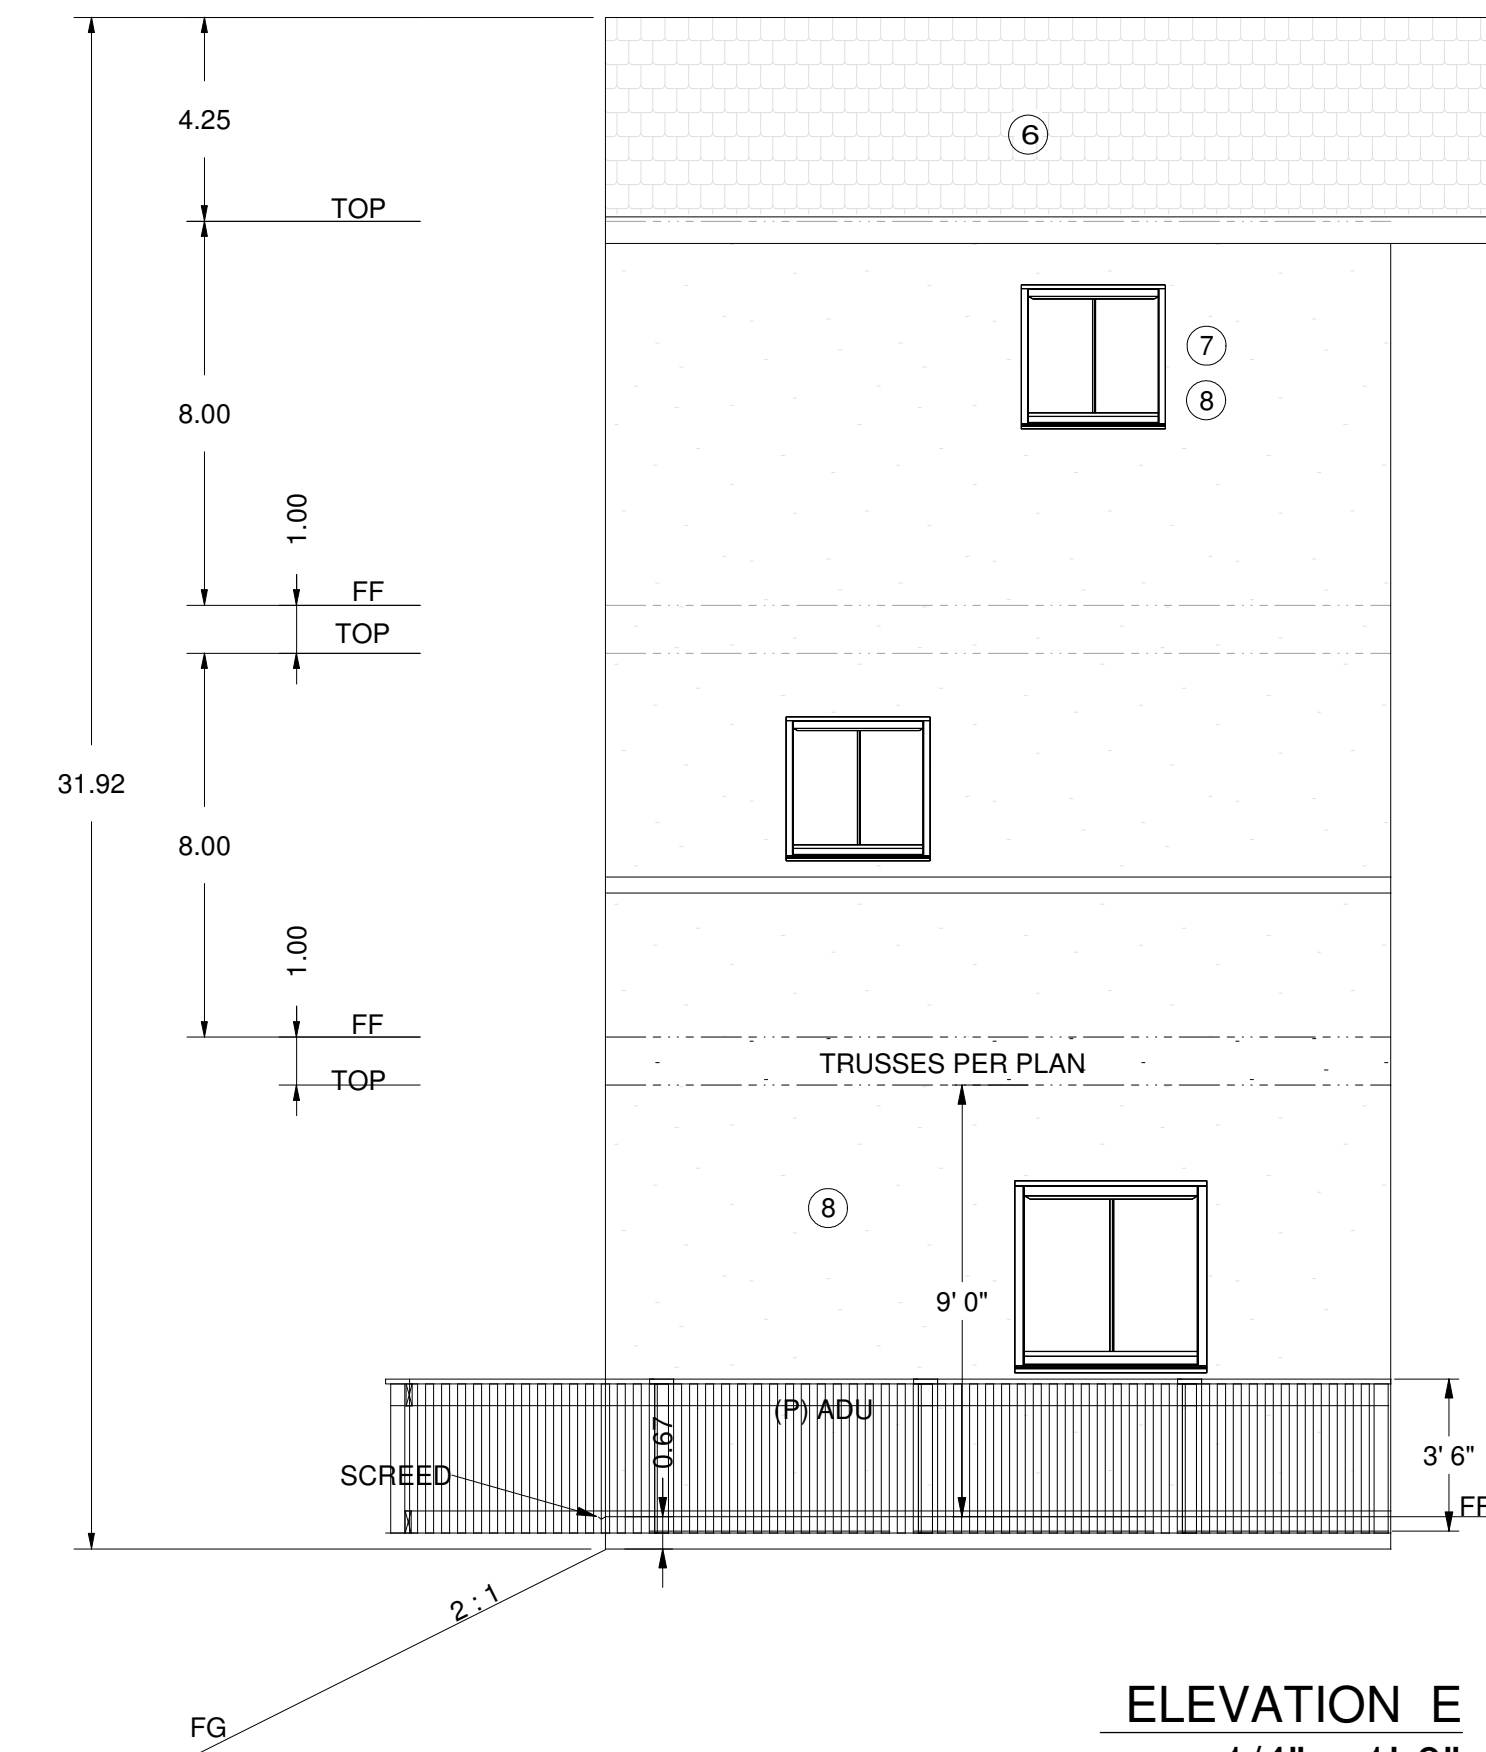


ELEVATION E
1/4" = 1'-0"

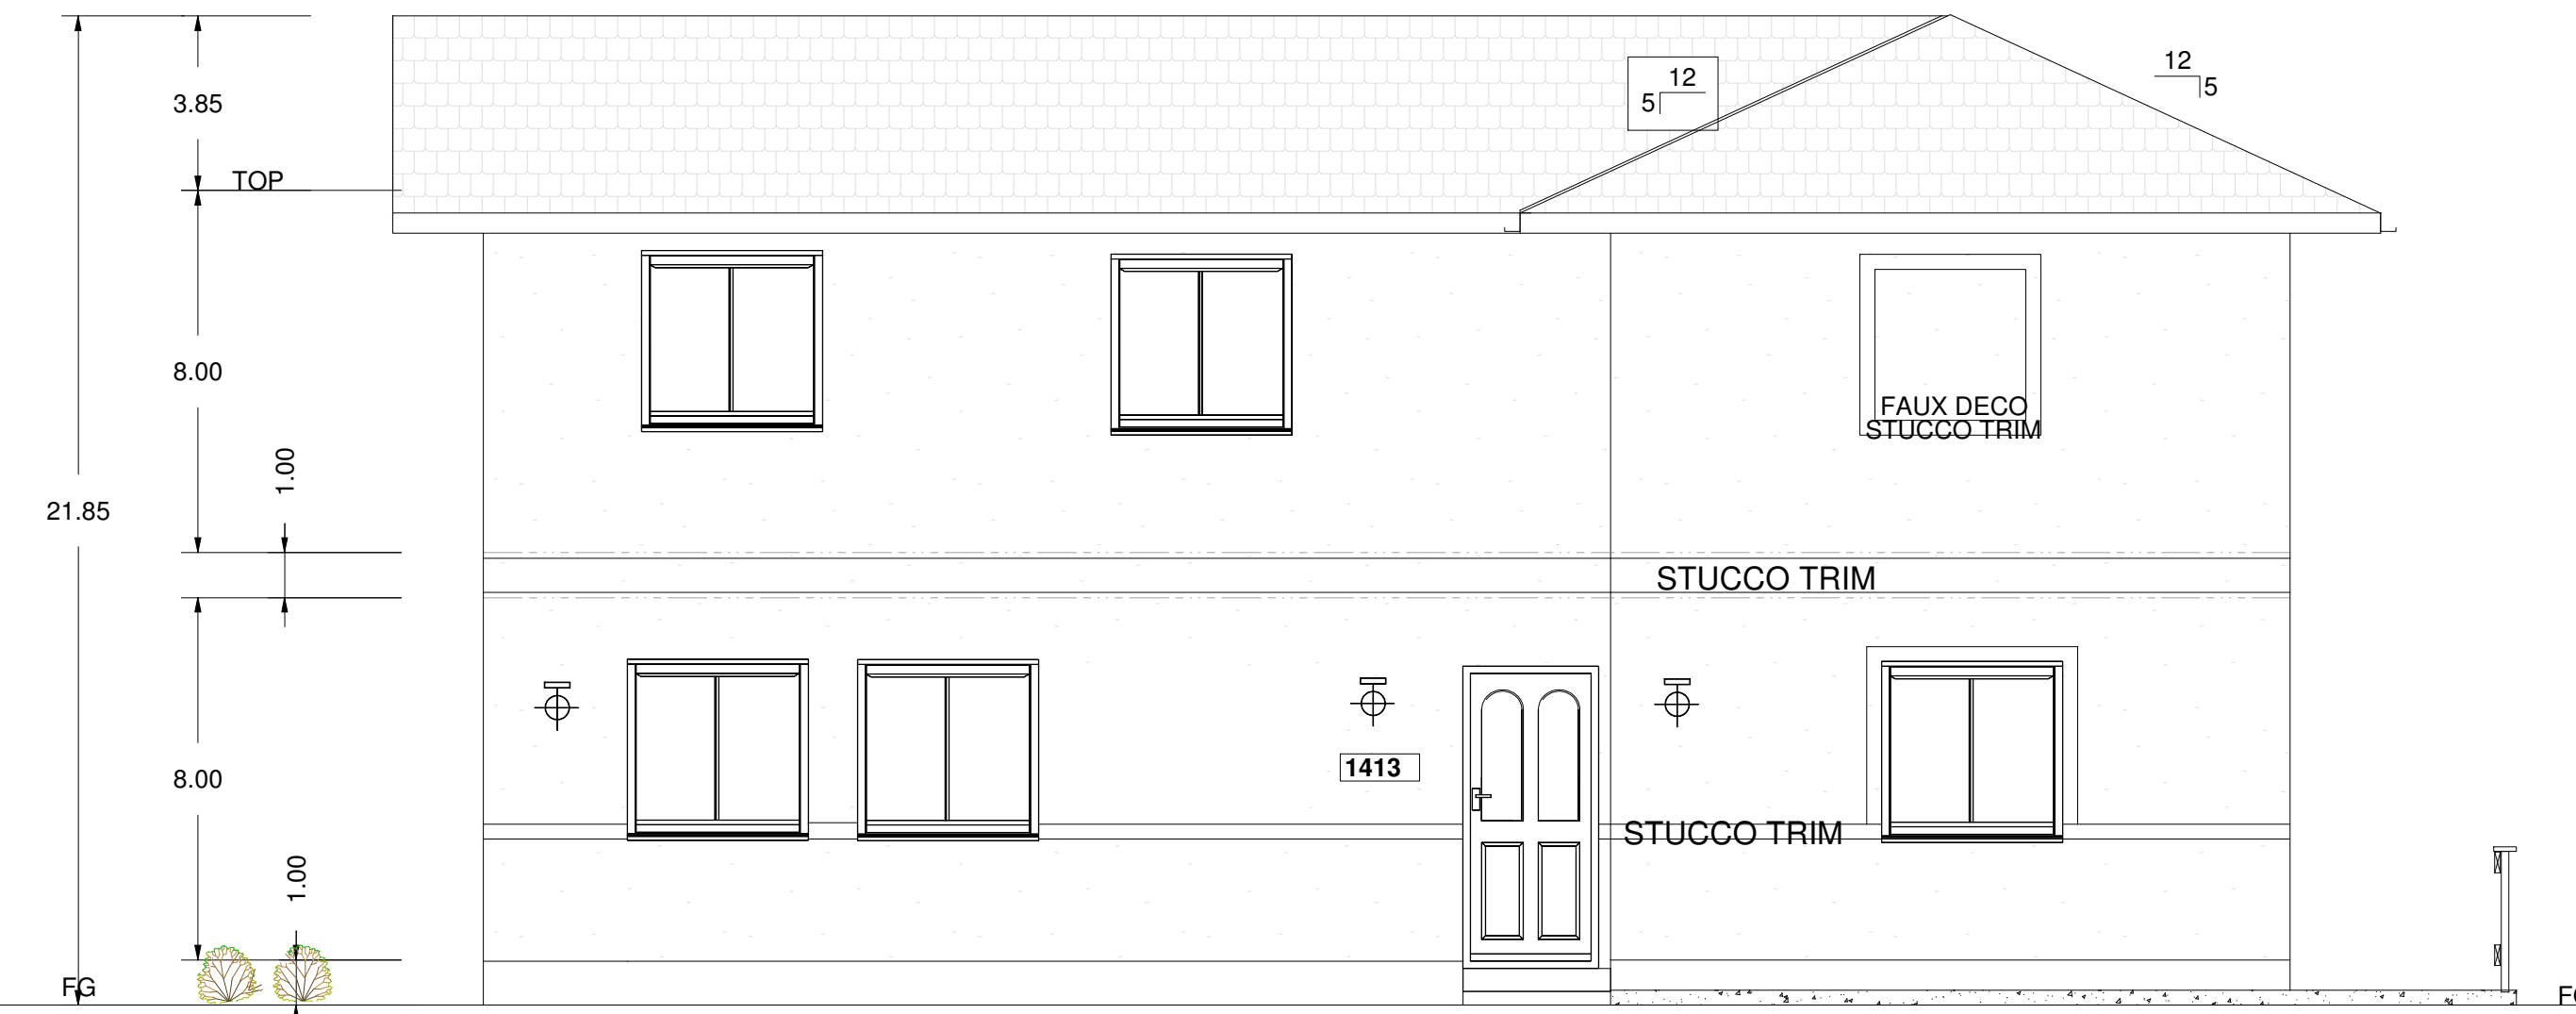

ELEVATION B
1/4" = 1'-0"

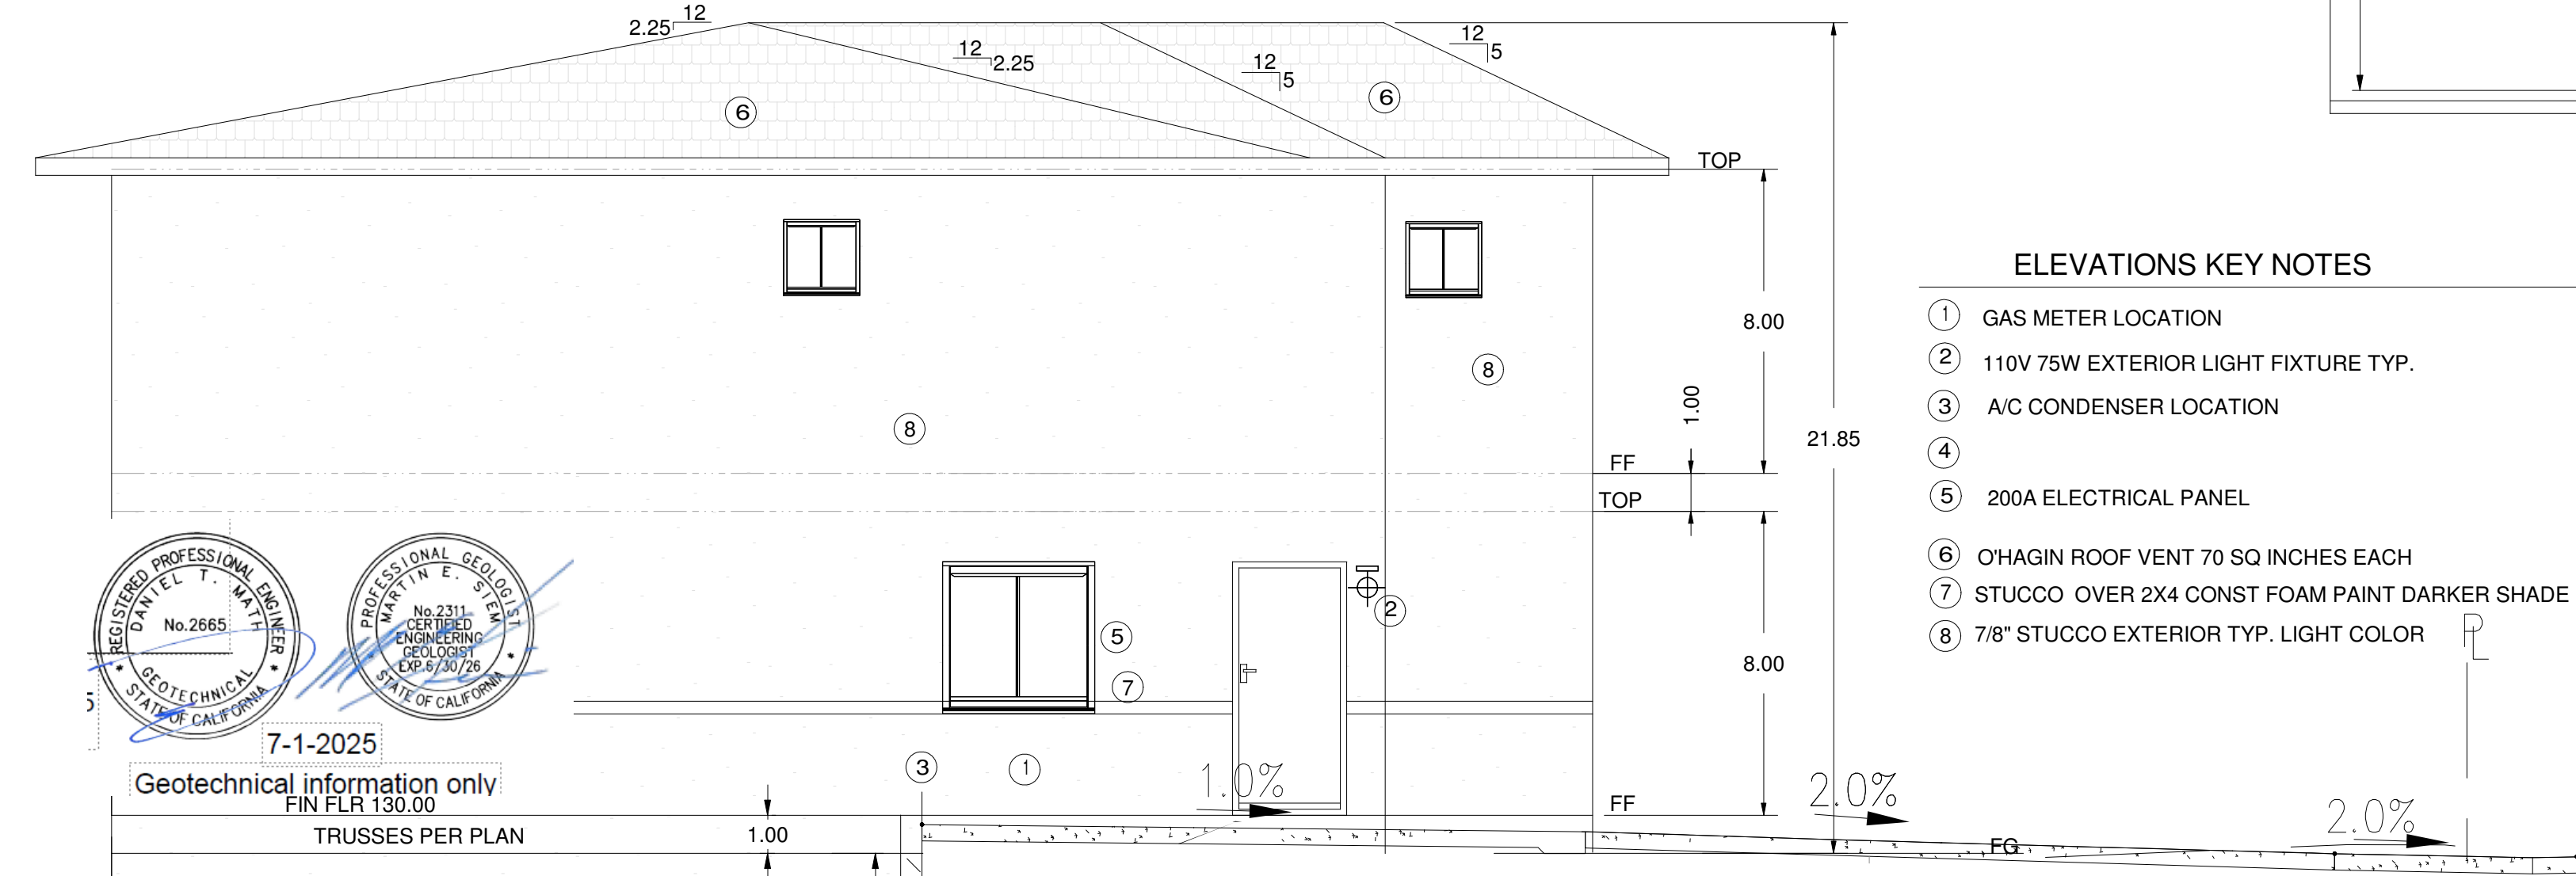

ELEVATION A
1/4" = 1'-0"

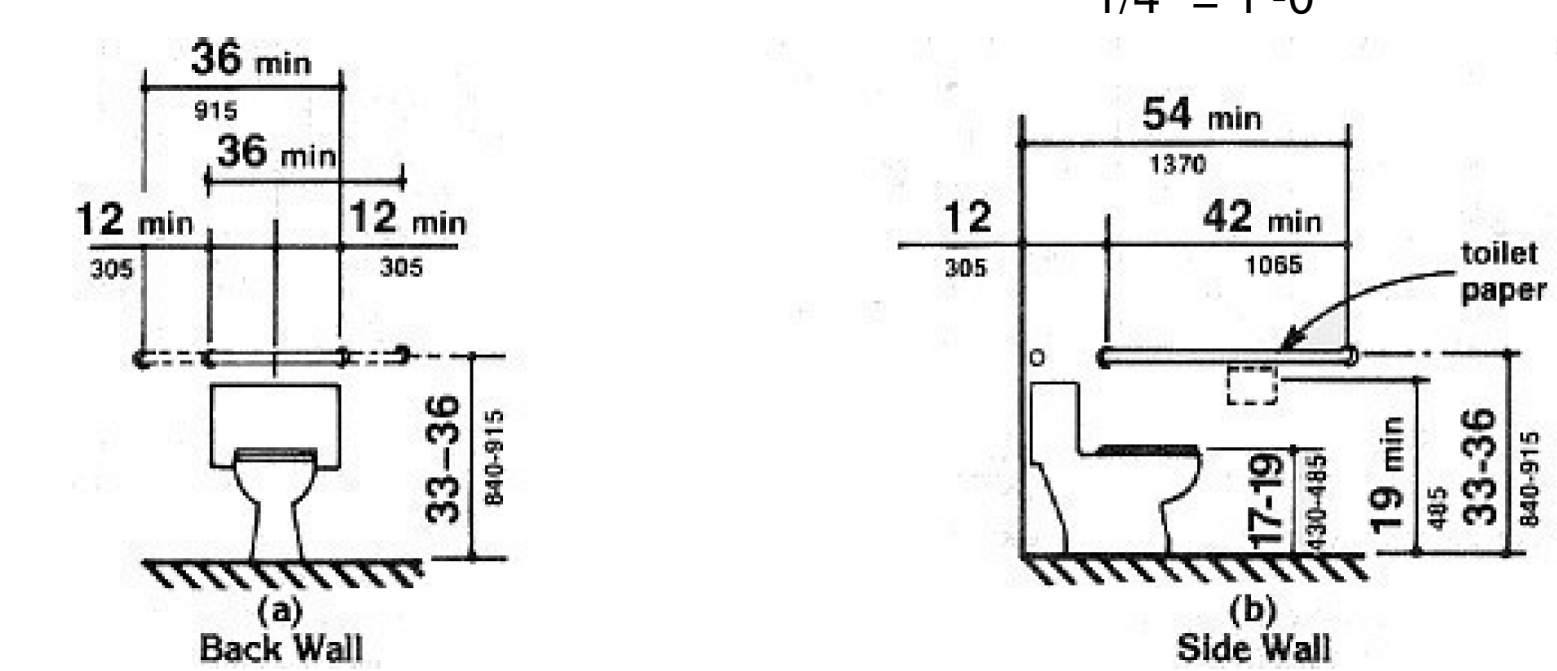

- ELEVATIONS KEY NOTES
- ① GAS METER LOCATION
 - ② 110V 75W EXTERIOR LIGHT FIXTURE TYP.
 - ③ A/C CONDENSER LOCATION
 - ④
 - ⑤ 200A ELECTRICAL PANEL
 - ⑥ OHAGIN ROOF VENT 70 SQ INCHES EACH
 - ⑦ STUCCO OVER 2X4 CONST FOAM PAINT DARKER SHADE
 - ⑧ 7/8" STUCCO EXTERIOR TYP. LIGHT COLOR

ELEVATION C
1/4" = 1'-0"

R327.1 Aging-in-Place Design and Fall Prevention
Newly constructed dwellings subject to the requirements of this code shall be designed and constructed in accordance with Sections R327.1.1 through R327.1.4.
Exceptions:
Covered multifamily dwellings designed and constructed in accordance with Chapter 11A of the California Building Code.
Public housing and places of public accommodation required to comply with Chapter 11B of the California Building Code.

R327.1.1 Reinforcement for Grab Bars
At least one bathroom on the entry level shall be provided with reinforcement installed in accordance with this section. Where there is no bathroom on the entry level, at least one bathroom on the second or third floor of the dwelling shall comply with this section.
Reinforcement shall be solid lumber or other construction materials approved by the enforcing agency.
Reinforcement shall not be less than 2 by 8 inch (51 mm by 203 mm) nominal lumber. [1 1/2 inch by 7 1/4 inch (38 mm by 184 mm) actual dimension] or other construction material providing equal height and load capacity. Reinforcement shall be located between 32 inches (812.8 mm) and 39 1/4 inches (997 mm) above the finished floor flush with the wall framing.

Water closet reinforcement shall be installed on both side walls of the fixture, or one side wall and the back wall.
Shower reinforcement shall be continuous where wall framing is provided.
Bathtub and combination bathtub/shower reinforcement shall be continuous on each end of the bathtub and the back wall. Additionally, back wall reinforcement for a lower grab bar shall be provided with the bottom edge located no more than 6 inches (152.4 mm) above the bathtub rim.
Exceptions:
Where the water closet is not placed adjacent to a side wall capable of accommodating a grab bar, the bathroom shall have provisions for installation of floor-mounted, foldaway or similar alternate grab bar reinforcements approved by the enforcing agency.
Reinforcement shall not be required in wall framing for pre-fabricated shower enclosures and bathtub wall panels with integral factory-installed grab bars or when factory-installed reinforcement for grab bars is provided.
Shower enclosures that do not permit installation of reinforcement and/or grab bars shall be permitted, provided reinforcement for installation of floor-mounted grab bars or an alternate method is approved by the enforcing agency.
Bathtubs with no surrounding walls, or where wall panels do not permit the installation of reinforcement shall be permitted, provided reinforcement for installation of floor-mounted grab bars adjacent to the bathtub or an alternate method is approved by the enforcing agency.
Reinforcement of floors shall not be required for bathtubs and water closets installed on concrete slab floors.

R327.1.1.1 Documentation for Grab Bar Reinforcement
Information and/or drawings identifying the location of grab bar reinforcement shall be placed in the operation and maintenance manual in accordance with the California Green Building Standards Code, Chapter 4, Division 4.4.

R327.1.2 Electrical Receptacle Outlet, Switch and Control Heights
Electrical receptacle outlets, switches and controls (including controls for heating, ventilation and air conditioning) intended to be used by occupants shall be located no more than 48 inches (1219.2 mm) measured from the top of the outlet box and not less than 15 inches (381 mm) measured from the bottom of the outlet box above the finish floor.
Exceptions:
Dedicated receptacle outlets; floor receptacle outlets; controls mounted on ceiling fans and ceiling lights; and controls located on appliances.
Receptacle outlets required by the California Electrical Code on a wall space where the distance between the finished floor and a built-in feature above the finish floor, such as a window, is less than 15 inches (381 mm).

R327.1.3 Interior Doors
Effective July 1, 2024, at least one bathroom and one bedroom on the entry level shall provide a doorway with a net clear opening of not less than 32 inches (812.8 mm), measured with the door positioned at an angle of 90 degrees from the closed position; or, in the case of a two- or three-story single family dwelling, on the second or third floor of the dwelling if a bathroom or bedroom is not located on the entry level.

R327.1.4 Doorbell Buttons
Doorbell buttons or controls, when installed, shall not exceed 48 inches (1219.2 mm) above exterior floor or landing, measured from the top of the doorbell button assembly. Where doorbell buttons integrated with other features are required to be installed above 48 inches (1219.2 mm) measured from the exterior floor or landing, a standard doorbell button or control shall also be provided at a height not exceeding 48 inches (1219.2 mm) above exterior floor or landing, measured from the top of the doorbell button or control.

SEE SHT A-5 FOR DOWNSPOUT DETAILS

GENERAL NOTES

1. PROVIDE AN EMERGENCY ESCAPE AND RESCUE OPENING THAT COMPLIES WITH ALL OF THE FOLLOWING: MIN. NET CLEAR OPENING OF 5.7 SQ. FT. (5 SQ. FT. MIN. AT GRADE FLR. OPENINGS, MIN. 20 INCH NET CLEAR OPENING WIDTH, MIN. 24 INCH NET CLEAR OPENING HEIGHT, BOTTOM OF THE CLEAR OPENING NOT GREATER THEN 44 INCHES MEASURED FROM THE FLOOR.
2. PROVIDE R-13 BATT INSULATION IN ALL NEW EXTERIOR WALLS. PROVIDE R-30 BATT INSULATION IN THE NEW ATTIC. PAPER BACKED INSULATION IS NOT PERMITTED IN ATTIC SPACES.
3. PROVIDE MINIMUM CLEARANCE OF 15 INCHES FROM THE CENTER LINE ON BOTH SIDES AND 24 INCHES IN FRONT OF THE WATER CLOSET.
4. PENETRATIONS OF FIRE-RESISTIVE WALLS, FLOOR-CEILING AND ROOF-CEILINGS SHALL BE PROTECTED AS REQUIRED IN CRC SECTION R302.4.
5. SHOWER COMPARTMENTS AND BATHTUBS WITH INSTALLED SHOWER HEADS SHALL BE FINISHED WITH A NONABSORBENT SURFACE THAT EXTENDS TO THE HEIGHT OF NOT LESS THAN 6 FEET ABOVE THE FLOOR.

FINISH NOTES

1. ALL CERAMIC TILE UNLESS SPECIFIED ON THE ROOM FINISH SCHEDULE SHALL BE SPECIFIED BY OWNER.
2. CERAMIC TILE INSTALLATION SHALL CONFORM TO THE LATEST EDITION OF THE "HANDBOOK FOR CERAMIC TILE INSTALLATION" BY THE "TILE COUNCIL OF AMERICA."
3. BATHROOM WALL TILE SHALL BE INSTALLED OVER AN APPROVED "WATER RESISTANT" GYPSUM WALLBOARD WITH ORGANIC ADHESIVES IN ACCORDANCE WITH METHOD B413-87 OR ON CEMENT MORTAR IN ACCORDANCE WITH METHOD B111-87.
4. SHOWER RECEPTORS/WALLS SHALL BE INSTALLED WITH ORGANIC ADHESIVES OVER "WATER-RESISTANT" GYPSUM WALL BOARD IN ACCORDANCE WITH METHOD B416-87.
5. TILE TUBS SHALL BE INSTALLED IN ACCORDANCE WITH METHOD B14-87.
6. TILE COUNTERTOPS SHALL BE INSTALLED IN ACCORDANCE WITH METHOD C611-87.
7. GYPSUM WALL BOARD SHALL CONFORM TO THE LATEST EDITION OF THE BUILDING CODE CHAPTER 25 AND "AMERICAN STANDARD SPECIFICATIONS FOR THE APPLICATION AND FINISHING OF GYPSUM WALLBOARD."
8. REGULAR 1/2" OR 5/8" THICK GYPSUM WALLBOARD EQUAL TO U.S.G. TAPED EDGE SHEETROCK WHERE TYPE "X" OR 11/R WALLBOARD IS NOT REQUIRED.

9. TYPE "X" 1/2" OR 5/8" GYPSUM WALLBOARD EQUAL TO U.S.G. TAPED EDGE FIRECODE "C" PANELS WHERE TYPE "X" WALLBOARD IS REQUIRED. REGULAR AND TYPE "X" SINGLE LAYER WALLBOARD SHALL BE INSTALLED HORIZONTALLY STAGGERING END JOINTS. NAIL WITH 5d COOLER NAILS (1/2" WALLBOARD USE 6d COOLER NAILS AND AT 5/8" WALLBOARD AT 6" ON CENTER FOR CEILINGS AND 7" ON CENTER FOR WALLS. MULTI-LAYERED APPLICATIONS AS SPECIFIED AND APPLICABLE IN THE UNIFORM BUILDING CODE.

10. WATER RESISTANT 1/2" OR 5/8" TH CK GYPSUM WALLBOARD EQUAL TO U.S.G. TAPED EDGE SHEETROCK REGULAR PANELS OR FIRECODE "C" (TYPE "X") PANELS AS REQUIRED.

- a) FOR BATHROOMS AND TOILET ROOMS, NON- ABSORBANT FINISH AND BACKING FOR WALLS AND FLOOR TO CONFORM WITH THE BUILDING CODE SECTION 2512.
- b) APPLY SINGLE LAYER OF WALLBOARD HORIZONTALLY WITH FACTORY EDGE PAPER, ABUTTING TOP EDGE OF SPACER, STAGGERING END JOINTS. NAILING PER REGULAR AND TYPE "X" WALLBOARD.
- c) ALL EDGES, HOLES AND JOINTS SHALL BE TREATED WITH SHEETROCK BRAND OF WATER RESISTANT SEALANT PRIOR TO INSTALLATION.
- d) FLOAT ALL CEILING END JOINTS, EXCEPT AT PERIMETER.

11. GYPSUM WALLBOARD ACCESSORIES:
 - a) METAL TRIM EQUAL TO U.S.G. NO. 402 WHERE ABUTS WITH OTHER MATERIAL OR TERMINATES.
 - b) CORNER BEADS EQUAL TO U.S.G. NO. 103 BURABEAD AT ALL EXTERNAL CORNERS.
 - c) JOINT TAPE, BEDDING, FINISHING CEMENT, ADHESIVES AND LAMINATION COMPOUND TO BE AS RECOMMENDED BY SHEETROCK MANUFACTURER AND COMPLIANCE WITH U.L. INC. FOR FIRE RESISTIVE RATINGS.
 - d) ACCESS PANELS WHERE INDICATED OR REQUIRED TO BE EQUAL TO MILCOR "STYLE DW 22" x 30" UNLESS OTHERWISE NOTED.

12. GYPLAP SHEATHING SHALL BE EQUAL TO 1/2" THICK U.S.G. GYPSUM SHEATING (TRADEMARK GYPLAP) ENCASED WITH WATER-REPELLENT PAPER ON BOTH FACES AND LONG SIDES, IN COMPLIANCE WITH BUILDING CODE.






13. FINISH COAT: APPLY TEXTURE FINISH COAT USING SPRAY EQUIPMENT CAPABLE OF PRODUCING A FINE ORANGE PEEL TEXTURE FINISH AS APPROVED FROM SAMPLES FURNISHED TO THE OWNER.

14. LATH AND PLASTER;
 - a) LATH AND PLATER SHALL CONFORM TO LATEST EDITION OF THE "CALIFORNIA LATHING AND PLASTERING CONTRACTORS ASSOCIATION REFERENCE SPECIFICATIONS."
 - b) EXTERIOR CEMENT PLASTER (STUCCO) SHALL COMPLY WITH THE CALIFORNIA BUILDING CODE.

15. PORTLAND CEMENT PLASTER:
 - a) PORTLAND CEMENT SHALL BE MIXED IN PROPORTION AS REQUIRED IN APPLICABLE CODE FOR MACHINE APPLICATION WITH INTEGRALLY COLORED STUCCO FINISH AS SELECTED BY OWNER.
 - b) VERTICAL SURFACES SELF-FURRING GALVANIZED METAL LATH LAMINATED KRAFT-BACKED DIAMOND MESH "B."
 - c) HORIZONTAL SURFACES-PAPER- BACKED 3/8" FURRED GALVANIZED METAL WEB LATH.
 - d) MASONRY OR CONCRETE SURFACES SHALL BE CLEANED WITH 10% MURIATE ACID TO WATER SOLUTION, WITH CLEAR WATER AND RECEIVE PLASTER BONDING AGENT TO "WEL- CRETE." APPLY BASE COAT OF PLASTER OVER BONDING AGENT, TWO MACHINE APPLIED COATS WITH FINISH STUCCO COAT AS SELECTED BY OWNER. 1/2" TOTAL THICKNESS.

16. PORTLAND CEMENT PLASTER ACCESSORIES:
 - a) CASTING BEADS, EQUAL TO MILCOR OR U.S.G. NO. 66, TO BE INSTALLED AT ALL LOCATIONS WHERE PLASTER STOPS AGAINST MASONRY, CONCRETE, WOOD OR METAL SURFACES AND AS OTHERWISE SPECIFIED.
 - b) EXP ANSION JOINTS EQUAL TO MAILCOR OR U.S.G. NO. 40. ONE CONTINUOUS PIECE AS SPECIFIED.
 - c) REMOVABLE GROUNDS OR SCREDS AS REQUIRED TO MAINTAIN EXACT PLASTER THICKNESSES AND PLANE SURFACES.

BURIAL DEPTHS FOR YARD PIPING*

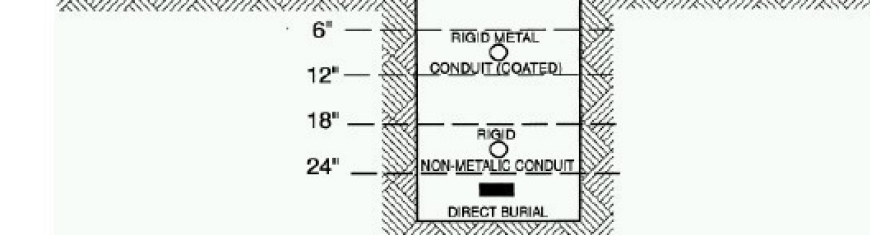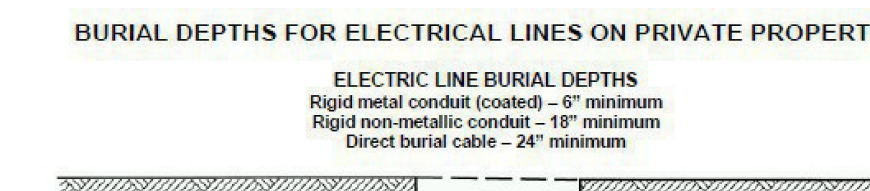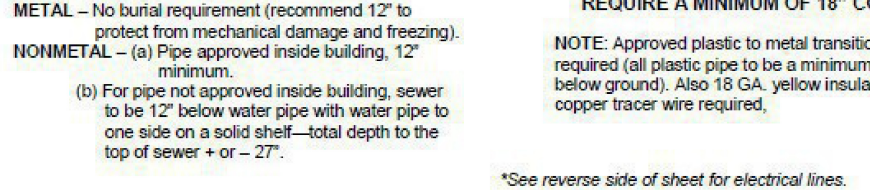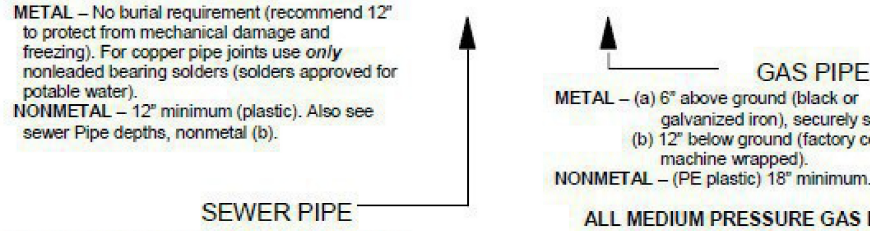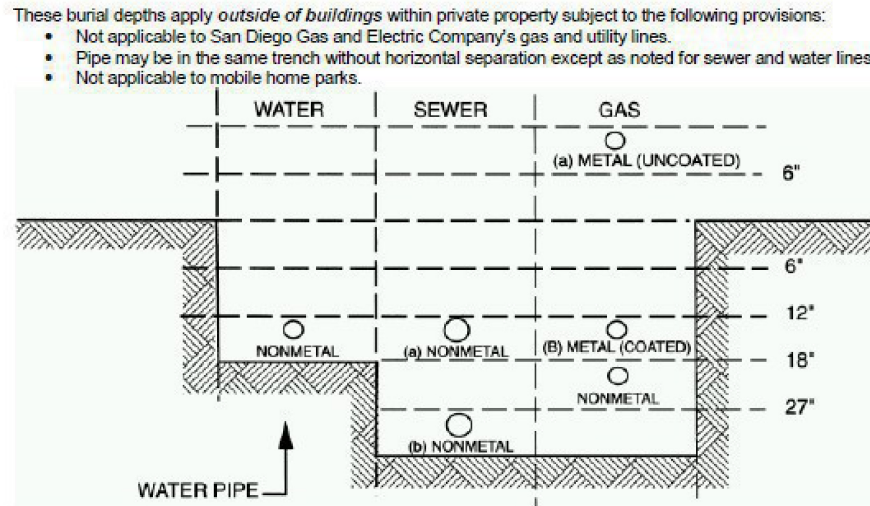



- PL = PROPERTY LINE
CL = CENTER LINE
FG = FINISH GRADE
WL = WATERLINE
DA = DOOR ALARM REQ'D
PA = PLANTED AREA
TOS = TOP OF SLOPE
BOS = BOTTOM OF SLOPE
(E) = EXISTING
(P) = PROPOSED
(N) = NEW
FYSB = FRONT YARD SET BACK
SYSB = SIDE YARD SET BACK
RYSB = REAR YARD SET BACK
W.I. = WPOUGHT IRON
C.L. = CHAIN LINK FENCE
FF = FINISH FLOOR ELEVATION
TOP = TOP OF PLATE
TOP = TOP OF FOOTING
BOF = BOTTOM OF FOOTING
TOW = TOP OF WALL
BOW = BOTTOM OF WALL
TBR = TO BE REMOVED
RBB = RAISED BOND BEAM
EP = EDGE OF PAVING
FS = FINISH SURFACE

- 12W OUTDOOR LIGHT FIXTURE


- ABBREVIATIONS

- KEY NOTES
1. MIRROR, TYP
 2. 110V 75W LIGHT/FAN FIXTURE TYP.
 3. SINK WHITE W/ CABINET LIGHT OAK FINISH
 4. TOILET PAPER ROLL HOLDER CHROME FINISH
 5. KOHLER BRAND ELONGATED TOILET LOW VOLUME FLUSH WHITE, H.C. HEIGHT
 6. SLIP RESISTANT CERAMIC TILE FLOOR - WHITE
 7. 6" X 6" C.T. W/ WOOD BASE
 8. HEAT PUMP LOCATION 220V SEE SHT A-7 FOR SPECS
 9. Mitsubishi Electric AC may-g118na, 18k BTU, 20.5 SEER, above door
 10. ROD & CURTAIN @ SHOWER
 11. O'HAGIN ROOF VENT 70 SQ INCHES EACH
 12. STUCCO PER BLDG CODE
 13. Rheem XE50T10H45U0
 14. TANK ELECTRICAL WATER HEATERS
 15. MIN 22" X 36" ATTIC ACCESS
 16. A/C CONDENSER LOCATION
 17. (1) 200A ELECTRICAL PANEL
 18. MIN 42" GRAB BAR
 19. MIN 36" GRAB BAR
 20. (2) 100A ELECTRICAL PANELS

- DOWNSPOUT

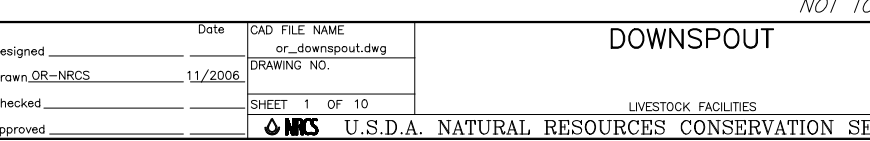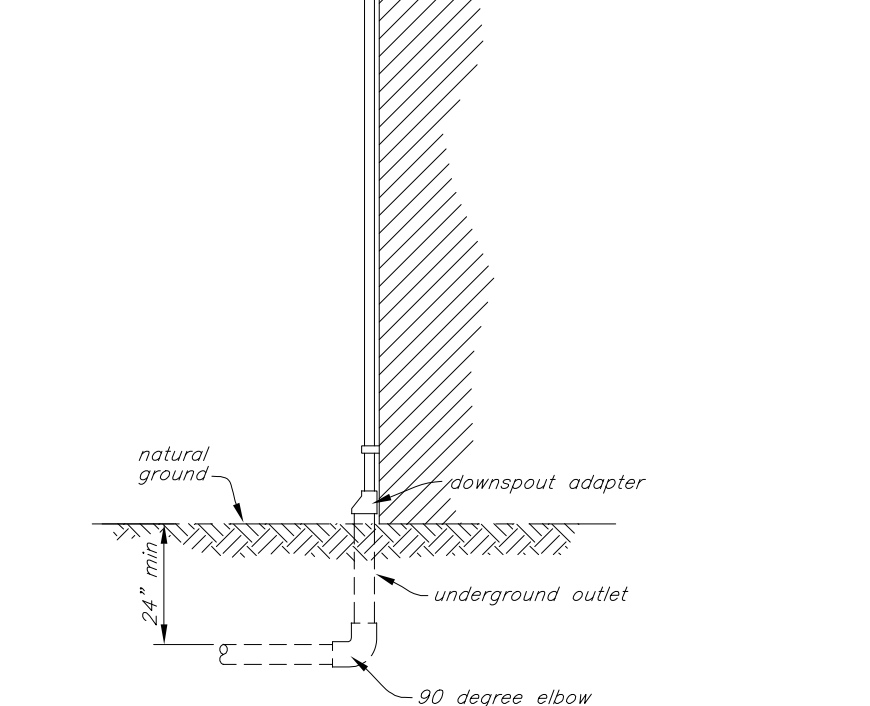

All smoke and carbon monoxide alarms must be interconnected and must receive there main power from the building with battery backup. Type 1 or Type 2 surge protective device (SPD) for dwelling unit services.

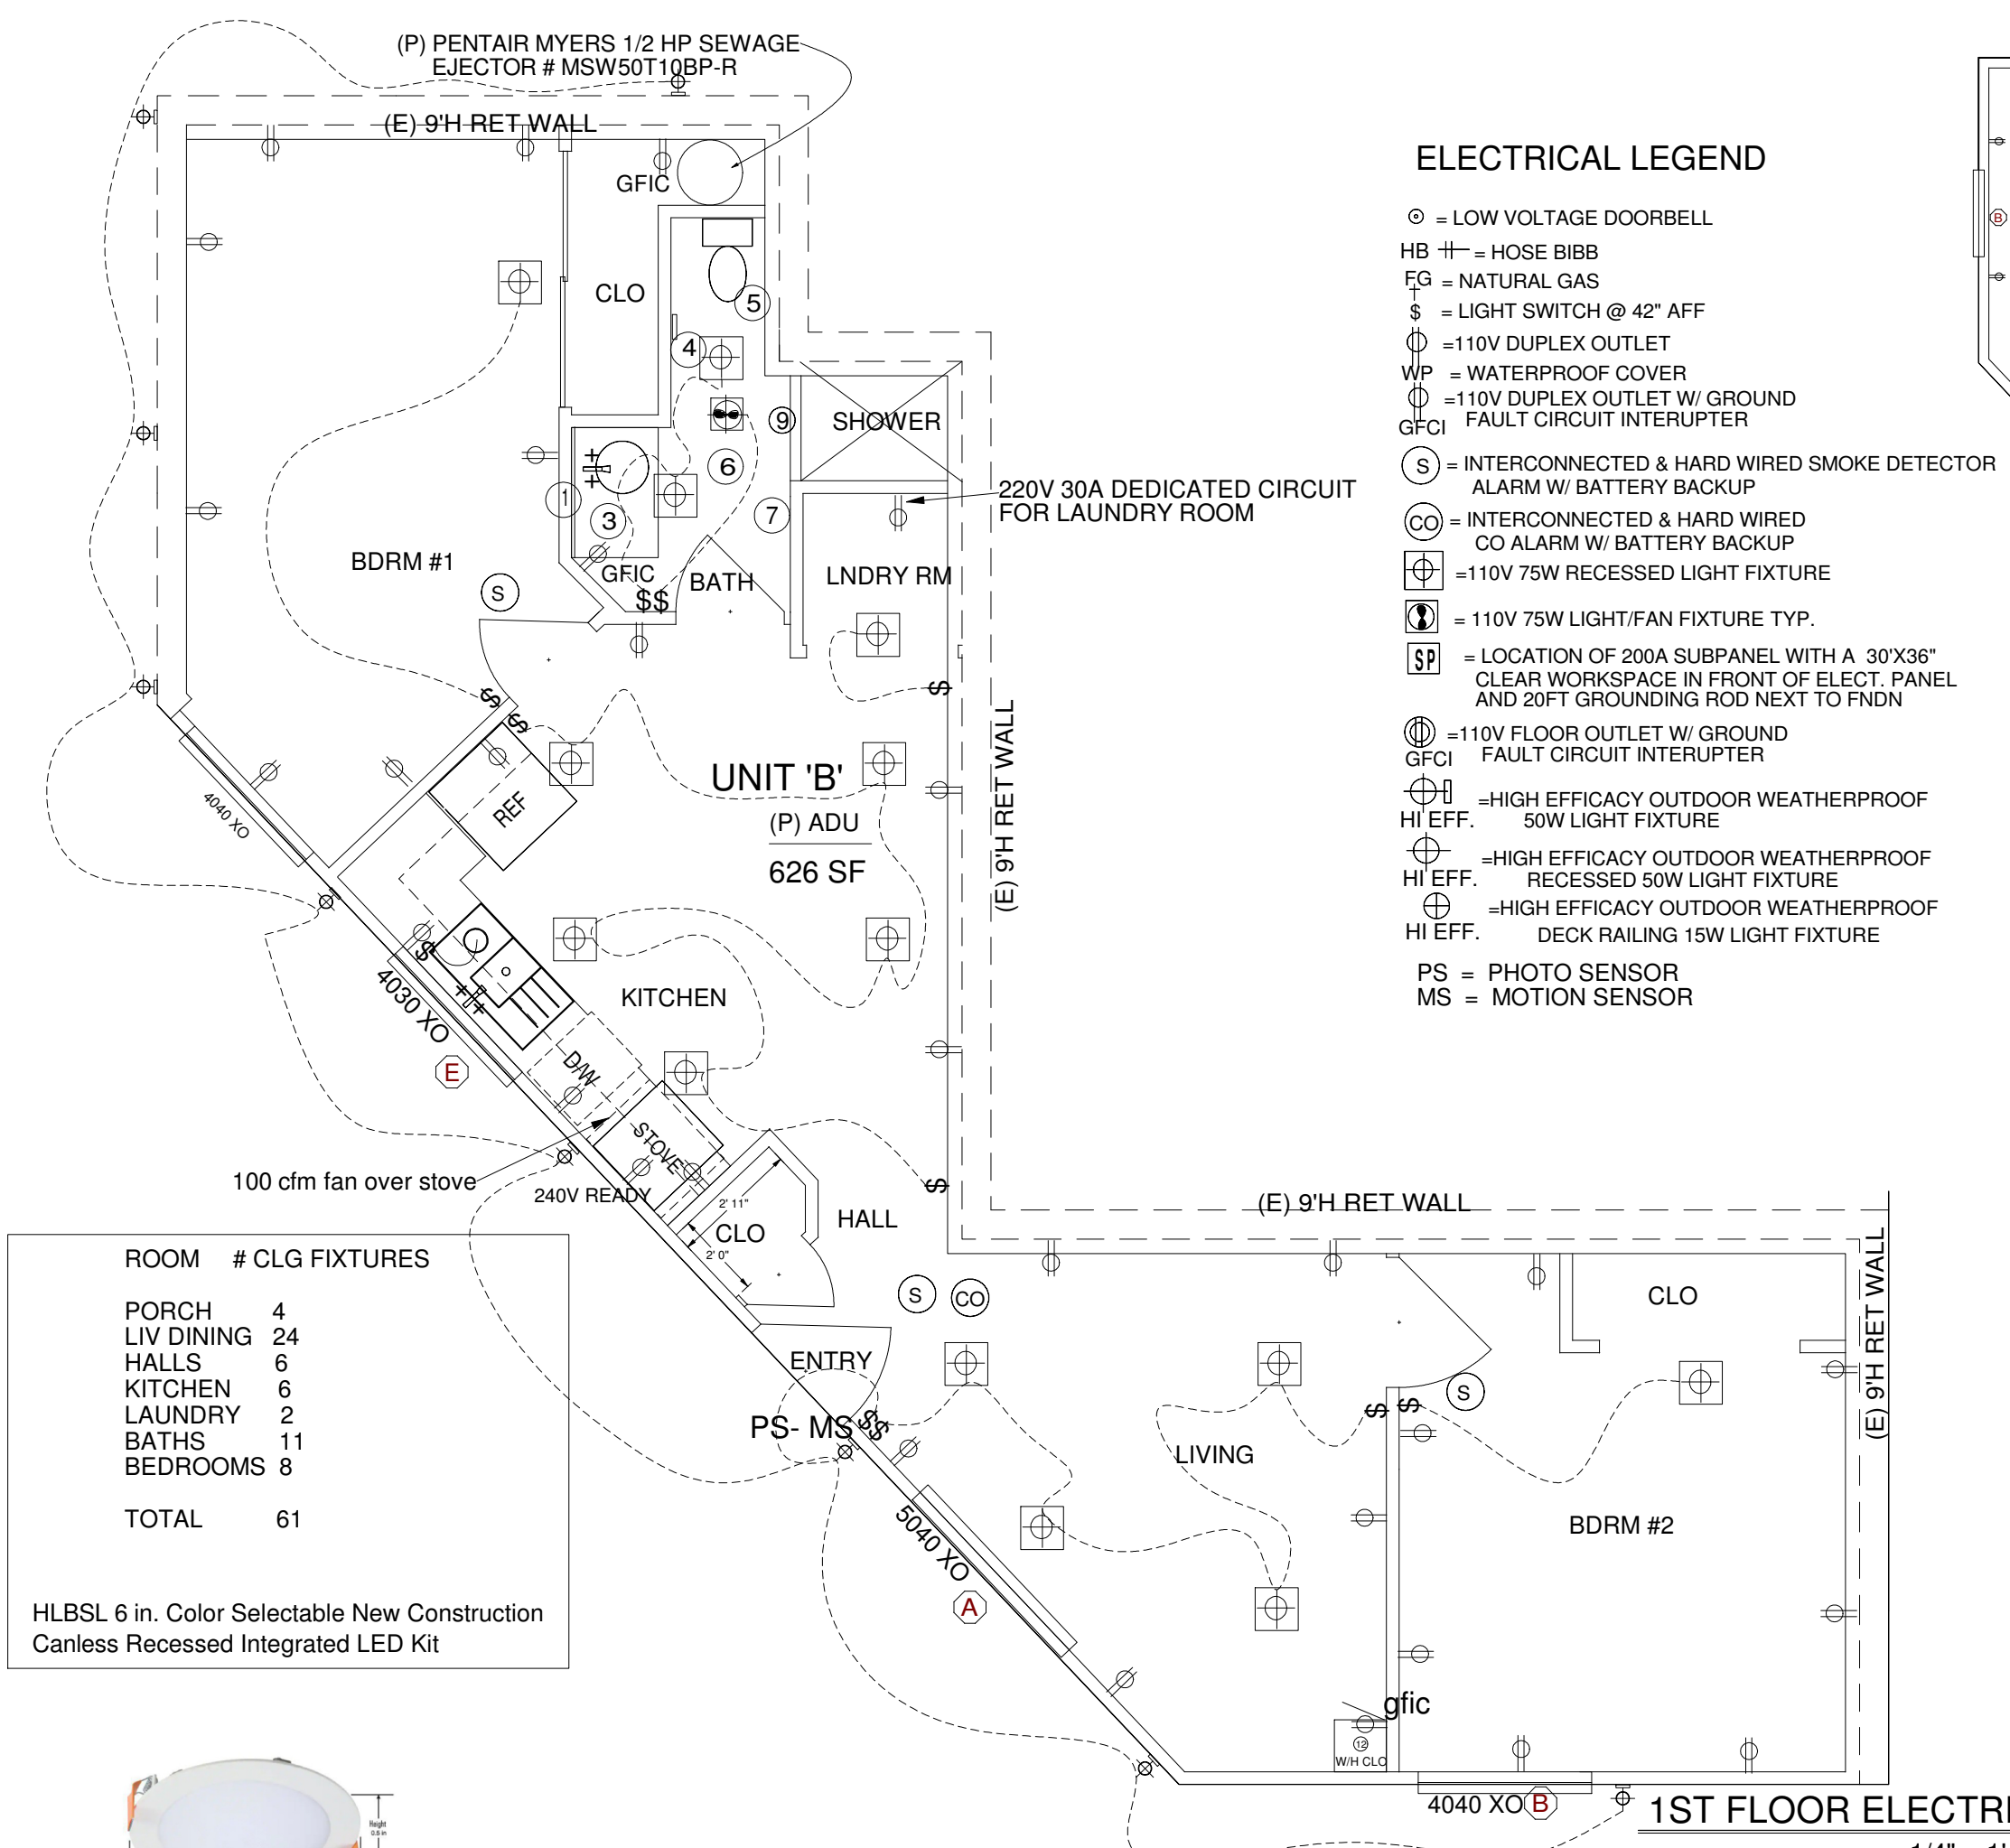

10. Energy storage systems (ESS) ready. All single-family residences that include one or two dwelling units shall meet the following. All electrical components shall be installed in accordance with the California Electrical Code:
 1. At least one of the following shall be provided:
 - A. ESS ready interconnection equipment with a minimum backed-up capacity of 60 amps and a minimum of four ESS-supplied branch circuits, or
 - B. A dedicated raceway from the main service to a panelboard (subpanel) that supplies the branch circuits in Section 150.0(s)(2). All branch circuits are permitted to be supplied by the main service panel prior to the installation of an E SS. The trade size of the raceway shall be not less than 1 inch. The panelboard that supplies the branch circuits (subpanel) must be labeled "Subpanel shall include all backed-up load circuits."
 2. A minimum of four branch circuits shall be identified and have their source of supply collocated at a single panelboard suitable to be supplied by the ESS. At least one circuit shall supply the refrigerator, one lighting circuit shall be located near the primary egress and at least one circuit shall supply a sleeping room receptacle outlet.

3. The main panelboard shall have a minimum busbar rating of 225 amps.
4. Sufficient space shall be reserved to allow future installation of a system isolation equipment/transfer switch within 3 feet of the main panelboard. Raceways shall be installed between the panelboard and the system isolation equipment /transfer switch location to allow the connection of backup power source.
2022 California Energy Code § 150.0(s)



11. Heat pump space heater ready. Systems using gas or propane furnace to serve individual dwelling units shall include the following:
 1. A dedicated 240 volt branch circuit wiring shall be installed within 3 feet from the furnace and accessible to the furnace with no obstructions. The branch circuit conductors shall be rated at 30 amps minimum. The blank cover shall be identified as "240V ready." All electrical components shall be installed in accordance with the California Electrical Code.
 2. The main electrical service panel shall have a reserved space to allow for the installation of a double pole circuit breaker for a future heat pump space heater installation. The reserved space shall be permanently marked as "For Future 240V use." 2022 California Energy Code § 150.0(t)

14. Electric clothes dryer ready. Clothes dryer locations with gas or propane plumbing to serve individual dwelling units shall include the following:
 1. A dedicated 240 volt branch circuit wiring shall be installed within 3 feet from the clothes dryer location and accessible to the clothes dryer location with no obstructions. The branch circuit conductors shall be rated at 30 amps mini mum. The blank cover shall be identified as "240V ready." All electrical components shall be installed in accordance with the California Electrical Code.
 2. The main electrical service panel shall have a reserved space to allow for the installation of a double pole circuit breaker for a future electric clothes dryer installation. The reserved space shall be permanently marked as "For Future 240V use." 2022 California Energy Code § 150.0(v)


15. Electric Cooktop ready. Systems using gas or propane cooktop to serve individual dwelling units shall include the following:
 1. A dedicated 240 volt branch circuit wiring shall be installed within 3 feet from the cooktop and accessible to the cooktop with no obstructions. The branch circuit conductors shall be rated at 50 amps minimum. The blank cover shall be identified as "240V ready." All electrical components shall be installed in accordance with the California Electrical Code.
 2. The main electrical service panel shall have a reserved space to allow for the installation of a double pole circuit breaker for a future electric cooktop installation. The reserved space shall be permanently marked as "For Future 240V use." 2022 California Energy Code § 150.0(u)

ELECTRICAL LEGEND


- ⊙ = LOW VOLTAGE DOORBELL
- HB = HOSE BIBB
- FG = NATURAL GAS
- \$ = LIGHT SWITCH @ 42" AFF
- ⊕ = 110V DUPLEX OUTLET
- ⊕ = WATERPROOF COVER
- ⊕ = 110V DUPLEX OUTLET W/ GROUND
- GFCI = FAULT CIRCUIT INTERRUPTER
- ⊕ = INTERCONNECTED & HARD WIRED SMOKE DETECTOR ALARM W/ BATTERY BACKUP
- ⊕ = INTERCONNECTED & HARD WIRED CO ALARM W/ BATTERY BACKUP
- ⊕ = 110V 75W RECESSED LIGHT FIXTURE
- ⊕ = 110V 75W LIGHT/FAN FIXTURE TYP.
- ⊕ = LOCATION OF 200A SUBPANEL WITH A 30"x36" CLEAR WORKSPACE IN FRONT OF ELECT. PANEL AND 20FT GROUNDING ROD NEXT TO FNDN
- ⊕ = 110V FLOOR OUTLET W/ GROUND
- GFCI = FAULT CIRCUIT INTERRUPTER
- ⊕ = HIGH EFFICACY OUTDOOR WEATHERPROOF 50W LIGHT FIXTURE
- ⊕ = HIGH EFFICACY OUTDOOR WEATHERPROOF RECESSED 50W LIGHT FIXTURE
- ⊕ = HIGH EFFICACY OUTDOOR WEATHERPROOF DECK RAILING 15W LIGHT FIXTURE
- PS = PHOTO SENSOR
- MS = MOTION SENSOR

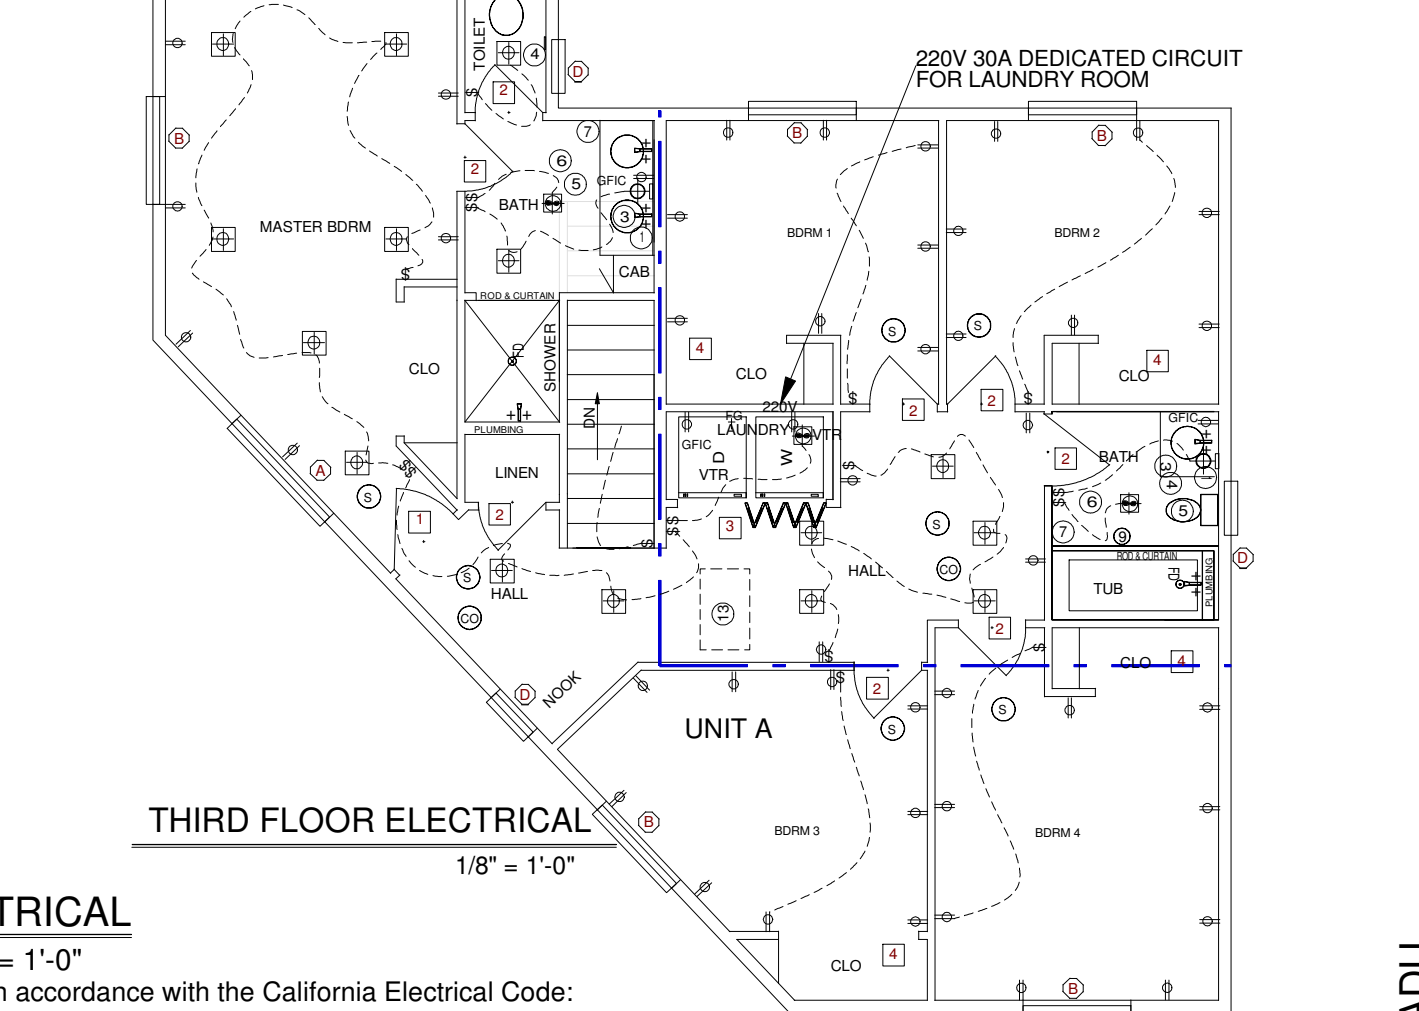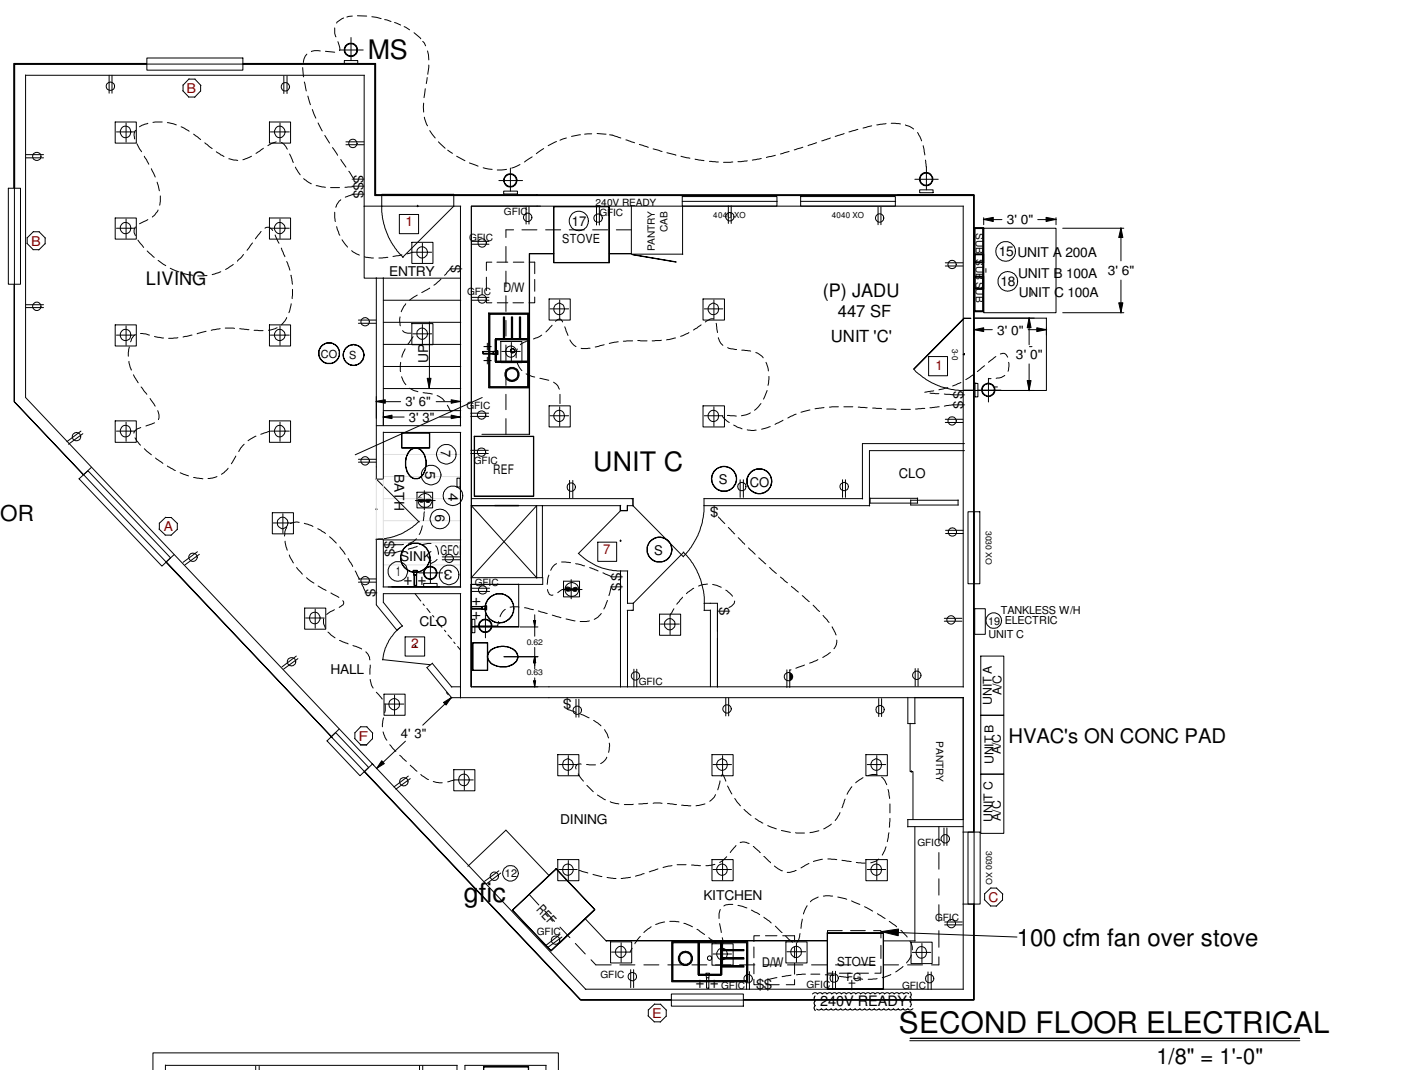


2 TYPICAL INTERIOR WALL

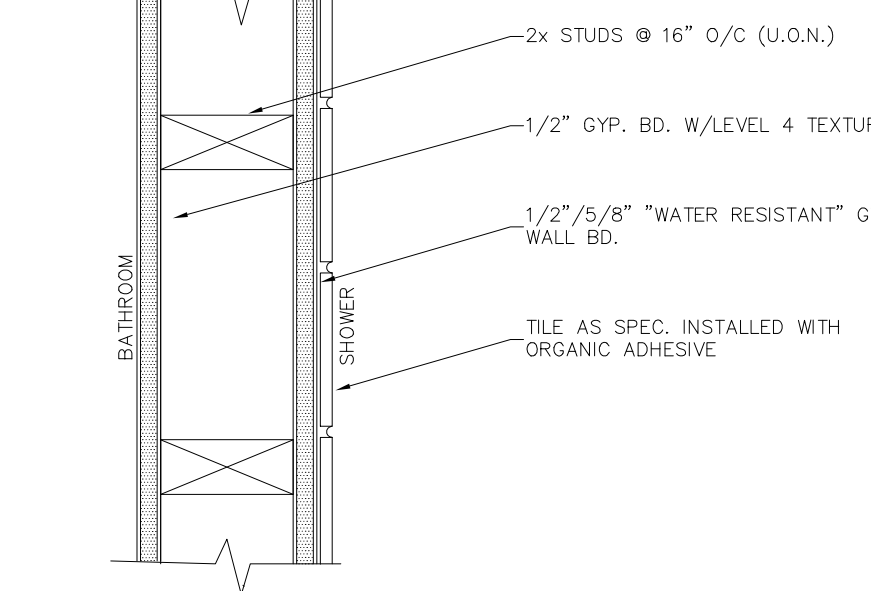


2 TYPICAL SHOWER WALL

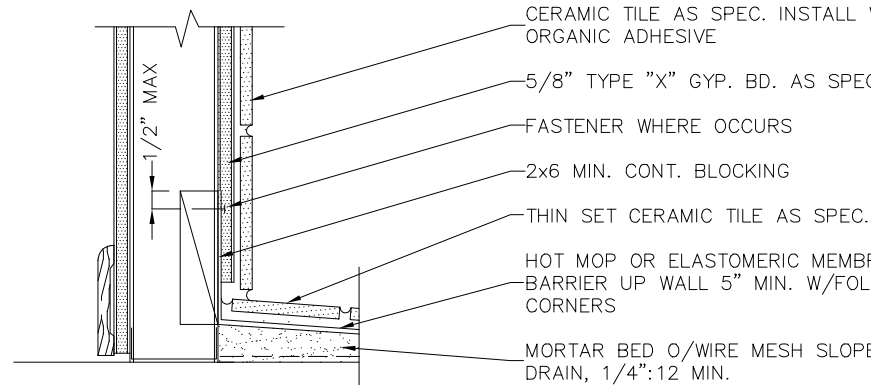

3 TYPICAL SHOWER PAN DETAIL

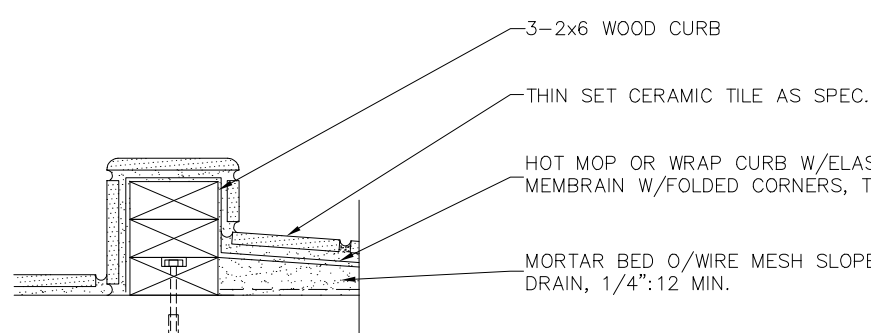

4 TYPICAL SHOWER CURB DETAIL

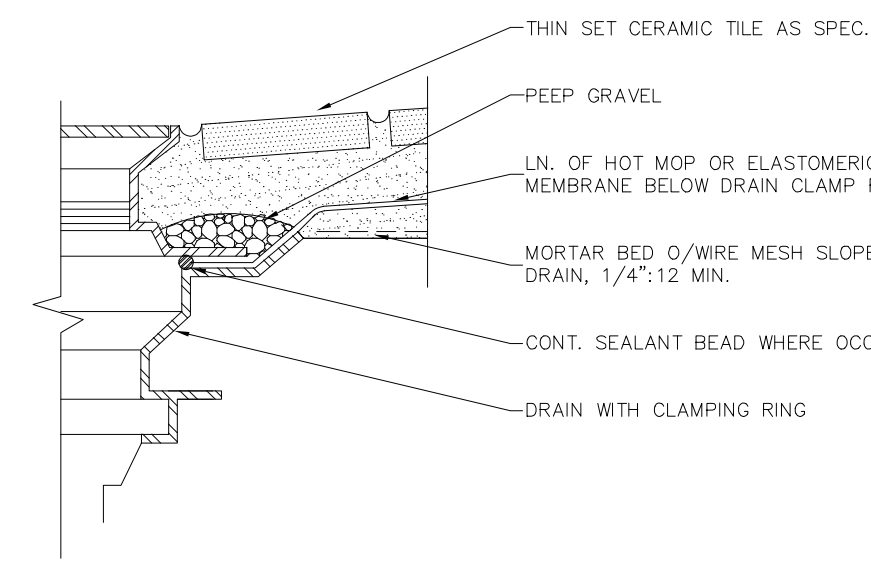

5 TYPICAL SHOWER DRAIN DETAIL

- Indoor Air Quality [whole house] ventilation [IAQ] is mandatory for New bldgs.
-- balanced IAQ fan / no Energy Recovery : 113cfm (~ +7.8)



442-333-8173
DRAW4U2@GMAIL.COM

SHEET TITLE: ELECTRICAL PLAN

DATE: 03/25/2024

SCALE: 1/8" = 1'-0"

REVISIONS: 04/24/2024 07/29/2024
05/15/2025 ADD WD DECK & STAIRS

OWNER INFORMATION: THE JESSICA AND KRISTINA BRANDT LIVING TRUST
3512 EL PASO ALTO
VISTA, CA. 92084

SHEET: A-5

CERTIFICATE OF COMPLIANCE - RESIDENTIAL PERFORMANCE COMPLIANCE METHOD

Project Name: 1413 Shoshone Residence

Calculation Date/Time: 2024-07-26T17:28:22-07:00

Calculation Description: Title 24 Analysis

Input File Name: 1413_Shoshone_residence_r1_v30.rbd22

CF1R-PRF-01-E

(Page 1 of 13)

GENERAL INFORMATION

01	Project Name		1413 Shoshone Residence	
02	Run Title		Title 24 Analysis	
03	Project Location		1413 Shoshone St	
04	City	Oroaniste, CA	05	Standards Version
06	Zip code	92098	07	Software Version
08	Climate Zone	7	09	Front Orientation (deg / Cardinal)
10	Building Type	Single family	11	Number of Dwelling Units
12	Project Scope	Newly Constructed	13	Number of Bedrooms
14	Addition Cond. Floor Area (ft ²)	0	15	Number of Stories
16	Existing Cond. Floor Area (ft ²)	n/a	17	Fenestration Average U-factor
18	Total Cond. Floor Area (ft ²)	2252	19	Glazing Percentage (%)
20	ADU Bedroom Count	n/a	21	ADU Conditioned Floor Area
22	Fuel Type	All electric	23	No Dwelling Unit

COMPLIANCE RESULTS

01	Building Complies with Computer Performance
02	This building incorporates features that require field testing and/or verification by a certified HERS rater under the supervision of a CEC-approved HERS provider.
03	This building incorporates one or more Special Features shown below

Registration Number: 424-P010143833A-000-000-0000000-0000
NOTICE: This document has been generated by California Home Energy Efficiency Rating Services (CHERS) using information submitted by third parties not affiliated with or related to CHERS. Therefore, CHERS is not responsible for, and cannot guarantee, the accuracy or completeness of the information contained in this document.
CA Building Energy Efficiency Standards - 2022 Residential Compliance
Registration Date/Time: 07/27/2024 15:31
HERS Provider: CHERS
Report Version: 2022.0.000
Report Generated: 2024-07-26 17:29:32
Schema Version: rev 20220901

CERTIFICATE OF COMPLIANCE - RESIDENTIAL PERFORMANCE COMPLIANCE METHOD												CF1R-PRF-01-E		
Project Name: 1413 Shoshone Residence						Calculation Date/Time: 2024-07-26T17:28:22-07:00						(Page 4 of 13)		
Calculation Description: Title 24 Analysis						Input File Name: 1413_Shoshone_residence_r1_v30.rbd22								
ENERGY USE INTENSITY														
	Standard Design (kBtu/ft ² - yr)			Proposed Design (kBtu/ft ² - yr)			Compliance Margin (kBtu/ft ² - yr)			Margin Percentage				
Gross EU ¹	13.84			13.67			0.17			1.23				
Net EU ²	5.34			5.17			0.17			3.18				
Notes														
1. Gross EU ¹ is Energy Use Total (not including PV) / Total Building Area.														
2. Net EU ² is Energy Use Total (including PV) / Total Building Area.														
REQUIRED PV SYSTEMS														
01	02	03	04	05	06	07	08	09	10	11	12			
DC System Size (kWdc)	Exception	Module Type	Array Type	Power Electronics	CFI	Azimuth (deg)	Tilt: Input	Array Angle (deg)	Tilt: (x in 12)	Inverter Eff. (%)	Annual Solar Access (%)			
3.56	NA	Standard (14-17%)	Fixed	none	true	150-270	n/a	n/a	<=7-12	96	98			
REQUIRED SPECIAL FEATURES														
The following are features that must be installed as condition for meeting the modeled energy performance for this computer analysis.														
- PV System: 3.56 kWdc - Exposed slab floor in conditioned zone - Electric water heater exception - Exception 2 to Section 150.1(c)(8) - Point of use - Northwest Energy Efficiency Alliance (NEEA) rated heat pump water heater; specific brand/model, or equivalent, must be installed														
HERS FEATURE SUMMARY														
The following is a summary of the features that must be field-verified by a certified HERS Rater as a condition for meeting the modeled energy performance for this computer analysis. Additional detail is provided in the building tables below. Registered CF2Rs and CF3Rs are required to be completed in the HERS Registry														
- Indoor air quality ventilation - Kitchen range hood - Verified heat pump rated heating capacity														
Registration Number: 424-P010143833A-000-000-0000000-0000													Registration Date/Time: 07/27/2024 15:31	HERS Provider: CHERS
NOTICE: This document has been generated by California Home Energy Efficiency Rating Services (CHERS) using information submitted by third parties not affiliated with or related to CHERS. Therefore, CHERS is not responsible for, and cannot guarantee, the accuracy or completeness of the information contained in this document.														
CA Building Energy Efficiency Standards - 2022 Residential Compliance													Report Version: 2022.0.000	Report Generated: 2024-07-26 17:29:32
													Schema Version: rev 20220901	

CERTIFICATE OF COMPLIANCE - RESIDENTIAL PERFORMANCE COMPLIANCE METHOD														CF1R-PRF-01-E	
Project Name: 1413 Shoshone Residence						Calculation Date/Time: 2024-07-26T17:28:22-07:00								(Page 7 of 13)	
Calculation Description: Title 24 Analysis						Input File Name: 1413_Shoshone_residence_r1_v30.rbd22									
FENESTRATION / GLAZING															
01	02	03	04	05	06	07	08	09	10	11	12	13	14		
Name	Type	Surface	Orientation	Azimuth	Width (ft)	Height (ft)	Mult.	Area (ft ²)	U-factor	U-factor Source	SHGC	SHGC Source	Exterior Shading		
Wind-n-D 1	Window	Wall-n-225 deg 1		195	2	2	1	4	0.45	NFRC	0.4	NFRC	Bug Screen		
Wind-n-A 1	Window	Wall-n-225 deg 1		195	5	4	1	20	0.45	NFRC	0.4	NFRC	Bug Screen		
Wind-n-B 2	Window	Wall-n-R 1	Right	240	4	4	1	16	0.45	NFRC	0.4	NFRC	Bug Screen		
Wind-n 1	Window	Wall-n-F 2	Front	330	4	4	1	16	0.45	NFRC	0.4	NFRC	Bug Screen		
Wind-n 2	Window	Wall-n-F 2	Front	330	4	4	1	16	0.45	NFRC	0.4	NFRC	Bug Screen		
Wind-n-F	Window	Wall-n-L 2	Left	60	2	4	1	8	0.45	NFRC	0.4	NFRC	Bug Screen		
Wind-n-B 3	Window	Wall-n-F 3	Front	330	4	4	1	16	0.45	NFRC	0.4	NFRC	Bug Screen		
Wind-n-B 4	Window	Wall-n-F 3	Front	330	4	4	1	16	0.45	NFRC	0.4	NFRC	Bug Screen		
Wind-n-D 2	Window	Wall-n-L 3	Left	60	2	2	1	4	0.45	NFRC	0.4	NFRC	Bug Screen		
Wind-n-D 3	Window	Wall-n-L 3	Left	60	2	2	1	4	0.45	NFRC	0.4	NFRC	Bug Screen		
Wind-n-B 5	Window	Wall-n-B 2	Back	150	4	4	1	16	0.45	NFRC	0.4	NFRC	Bug Screen		
Wind-n-B 6	Window	Wall-n-225 deg 2		195	4	4	1	16	0.45	NFRC	0.4	NFRC	Bug Screen		
Wind-n-D 4	Window	Wall-n-225 deg 2		195	2	2	1	4	0.45	NFRC	0.4	NFRC	Bug Screen		
Wind-n-A 2	Window	Wall-n-225 deg 2		195	5	4	1	20	0.45	NFRC	0.4	NFRC	Bug Screen		
Wind-n-B 7	Window	Wall-n-R 2	Right	240	4	4	1	16	0.45	NFRC	0.4	NFRC	Bug Screen		

Registration Number: 424-P010143833A-000-000-0000000-0000
NOTICE: This document has been generated by California Home Energy Efficiency Rating Services (CHERS) using information submitted by third parties not affiliated with or related to CHERS. Therefore, CHERS is not responsible for, and cannot guarantee, the accuracy or completeness of the information contained in this document.
CA Building Energy Efficiency Standards - 2022 Residential Compliance
Registration Date/Time: 07/27/2024 15:31
HERS Provider: CHERS
Report Version: 2022.0.000
Report Generated: 2024-07-26 17:29:32
Schema Version: rev 20220901

CERTIFICATE OF COMPLIANCE - RESIDENTIAL PERFORMANCE COMPLIANCE METHOD							CF1R-PRF-01-E
Project Name: 1413 Shoshone Residence				Calculation Date/Time: 2024-07-26T17:28:22-07:00			(Page 2 of 13)
Calculation Description: Title 24 Analysis				Input File Name: 1413_Shoshone_residence_r1_v30.rbd22			
ENERGY DESIGN RATINGS							
	Energy Design Ratings			Compliance Margins			
	Source Energy (EDR1)	Efficiency ¹ EDR (EDR2/Efficiency)	Total ² EDR (EDR2total)	Source Energy (EDR1)	Efficiency ¹ EDR (EDR2/Efficiency)	Total ² EDR (EDR2total)	
Standard Design	32.5	42.4	33				
Proposed Design	31.9	41.3	32.5	0.6	1.1	0.5	
RESULT: PASS							
¹ Efficiency EDR includes improvements like a better building envelope and more efficient equipment							
² Total EDR includes efficiency and demand response measures such as photovoltaic (PV) system and batteries							
Building complies when source energy, efficiency and total compliance margins are greater than or equal to zero and unmet load hour limits are not exceeded							
- Standard Design PV Capacity: 3.56 kWdc - PV System resized to 3.56 kWdc (a factor of 0.999) to achieve 'Standard Design PV' PV scaling							

Registration Number: 424-P010143833A-000-000-0000000-0000
NOTICE: This document has been generated by California Home Energy Efficiency Rating Services (CHERS) using information submitted by third parties not affiliated with or related to CHERS. Therefore, CHERS is not responsible for, and cannot guarantee, the accuracy or completeness of the information contained in this document.
CA Building Energy Efficiency Standards - 2022 Residential Compliance
Registration Date/Time: 07/27/2024 15:31
HERS Provider: CHERS
Report Version: 2022.0.000
Report Generated: 2024-07-26 17:29:32
Schema Version: rev 20220901

BUILDING - FEATURES INFORMATION						
01	02	03	04	05	06	07
Project Name	Conditioned Floor Area (ft²)	Number of Dwelling Units	Number of Bedrooms	Number of Zones	Number of Ventilation Cooling Systems	Number of Water Heating Systems
1413 Shoshone Residence	2252	1	6	3	0	2

ZONE INFORMATION						
01	02	03	04	05	06	07
Zone Name	Zone Type	HVAC System Name	Zone Floor Area (ft²)	Avg. Ceiling Height	Water Heating System 1	Status
House 2nd floor	Conditioned	HVAC new 1	679	9	DHW new 1	New
JADU	Conditioned	HVAC new 2	447	9	DHW new 2	New
House 3rd floor	Conditioned	HVAC new 3	1126	8	DHW new 1	New

OPAQUE SURFACES							
01	02	03	04	05	06	07	08
Name	Zone	Construction	Azimuth	Orientation	Gross Area (ft²)	Window and Door Area (ft²)	Tilt (deg)
Wall-n-F 1	House 2nd floor	Wall new	330	Front	168	37	90
Wall-n-L 1	House 2nd floor	Wall new	60	Left	163	9	90
Wall-n-B 1	House 2nd floor	Wall new	150	Back	148	9	90
Wall-n-225 deg 1	House 2nd floor	Wall new	195	n/a	303	24	90
Wall-n-R 1	House 2nd floor	Wall new	240	Right	127	16	90
Wall-n-F 2	JADU	Wall new	330	Front	193	32	90
Wall-n-L 2	JADU	Wall new	60	Left	193	29	90
Wall-n-F 3	House 3rd floor	Wall new	330	Front	325	82	90
Wall-n-L 3	House 3rd floor	Wall new	60	Left	312	8	90
Wall-n-B 2	House 3rd floor	Wall new	150	Back	131	16	90
Wall-n-225 deg 2	House 3rd floor	Wall new	195	n/a	275	40	90

Registration Number: 424-P01043833A-000-000-000000-0000

NOTES: This document was generated using California's online Energy Efficiency Rating Services (CHEERS) using information submitted by model sources not affiliated with or endorsed by the State of California. CHEERS is not responsible for, and cannot guarantee, the accuracy or completeness of the information contained on this document.

CA Building Energy Efficiency Standards - 2022 Residential Compliance

Registration Date/Time: 07/27/2024 15:31

Report Version: 2022.0.000

Schema Version: 20220901

HERS Provider: CHEERS

Report Generated: 2024-07-26 17:29:32

CERTIFICATE OF COMPLIANCE - RESIDENTIAL PERFORMANCE COMPLIANCE METHOD

CF1R-PRF-01-E

Project Name: 1413 Shoshone Residence

Calculation Date/Time: 2024-07-26T17:28:22-07:00

Calculation Description: Title 24 Analysis

Input File Name: 1413_Shoshone_residence_r1_v30.rbd22

(Page 10 of 13)

01	02	03	04	05	06	07	08	09	10	11	12	13
Name	Heating Element Type	Tank Type	# of Units	Tank Vol. (gal)	Heating Efficiency Type	Efficiency	Rated Input Type	Input Rating or Pilot	Tank Insulation R-value (Int/Ext)	Standby Loss or Recovery Eff	1st Hr. Rating or Flow Rate	Tank Location
EWIWH	Electric Resistance	Consumer Instantaneous	1	0	UEF	0.92	kW	12	0	99	2	

01	02	03	04	05	06	07	08
Name	# of Units	Tank Vol. (gal)	NEEA Heat Pump Brand	NEEA Heat Pump Model	Tank Location	Duct Inlet Air Source	Duct Outlet Air Source
WH HP	1	50	Rheem	XES0710H45U0 (50 gal, J413)	Outside	Outside	Outside

01	02	03	04	05	06	07
Name	Pipe Insulation	Parallel Piping	Compact Distribution	Compact Distribution Type	Recirculation Control	Shower Drain Water Heat Recovery
DHW new 1 - 1/2	Not Required	Not Required	Not Required	None	Not Required	Not Required
DHW new 2 - 1/2	Not Required	Not Required	Not Required	None	Not Required	Not Required

01	02	03	04	05	06	07	08	09
Name	System Type	Heating Unit Name	Heating Equipment Count	Cooling Unit Name	Cooling Equipment Count	Fan Name	Distribution Name	Required Thermostat Type
HVAC new 1	Heat pump heating cooling	MiniSplit HP 1	1	MiniSplit HP 1	1	n/a	n/a	Setback

Registration Number: 424-P010143833A-000-000-0000000-0000

Registration Date/Time: 07/27/2024 15:31

HERS Provider: CHEERS

NOTES: This document has been generated by California Home Energy Efficiency Rating Services (CHEERS) using information submitted by third parties not affiliated with or related to CHEERS. Therefore, CHEERS is not responsible for, and cannot guarantee, the accuracy or completeness of the information contained in this document.

CA Building Energy Efficiency Standards - 2022 Residential Compliance

Report Version: 2022.0.000

Report Generated: 2024-07-26 17:29:32

Schema Version: rev 20220901

CERTIFICATE OF COMPLIANCE - RESIDENTIAL PERFORMANCE COMPLIANCE METHOD

CF1R-PRF-01-E

Project Name: 1413 Shoshone Residence

Calculation Date/Time: 2024-07-26T17:28:22-07:00

Calculation Description: Title 24 Analysis

Input File Name: 1413_Shoshone_residence_r1_v30.rbd22

(Page 11 of 13)

01	02	03	04	05	06	07	08	09
Name	System Type	Heating Unit Name	Heating Equipment Count	Cooling Unit Name	Cooling Equipment Count	Fan Name	Distribution Name	Required Thermostat Type
HVAC new 2	Heat pump heating cooling	MiniSplit HP 2	1	MiniSplit HP 2	1	n/a	n/a	Setback
HVAC new 3	Heat pump heating cooling	MiniSplit HP 3	1	MiniSplit HP 3	1	n/a	n/a	Setback

01	02	03	04	05	06	07	08	09	10	11	12	13
Name	System Type	Number of Units	Heating Efficiency Type	HSPF/HSPF2/ECOP	Cap 47	Cap 17	Cooling Efficiency Type	SEER/SEER2	EER/EEER2/CEER	Zonality Controlled	Compressor Type	HERS Verification
MiniSplit HP 1	Ductless MiniSplit HP	1	HSPF2	7.5	16000	32800	EER2SEER2	14.3	11.7	Not Zonal	Single Speed	MiniSplit HP 1-herst-tump
MiniSplit HP 2	Ductless MiniSplit HP	1	HSPF2	7.5	12000	9600	EER2SEER2	14.3	11.7	Not Zonal	Single Speed	MiniSplit HP 2-herst-tump
MiniSplit HP 3	Ductless MiniSplit HP	1	HSPF2	7.5	28000	22400	EER2SEER2	14.3	11.7	Not Zonal	Single Speed	MiniSplit HP 3-herst-tump

01	02	03	04	05	06	07	08	09
Name	Verified Airflow	Airflow Target	Verified EER/CEER2	Verified SEER/SEER2	Verified Refrigerant Charge	Verified HSPF/HSPF2	Verified Heating Cap 47	Verified Heating Cap 17
MiniSplit HP 1-herst-tump	Not Required	0	Not Required	Not Required	No	No	Yes	Yes
MiniSplit HP 2-herst-tump	Not Required	0	Not Required	Not Required	No	No	Yes	Yes

Registration Number: 424-P010143833A-000-000-0000000-0000

Registration Date/Time: 07/27/2024 15:31

HERS Provider: CHEERS

NOTES: This document has been generated by California Home Energy Efficiency Rating Services (CHEERS) using information submitted by third parties not affiliated with or related to CHEERS. Therefore, CHEERS is not responsible for, and cannot guarantee, the accuracy or completeness of the information contained in this document.

CA Building Energy Efficiency Standards - 2022 Residential Compliance

Report Version: 2022.0.000

Report Generated: 2024-07-26 17:29:32

Schema Version: rev 20220901

CERTIFICATE OF COMPLIANCE - RESIDENTIAL PERFORMANCE COMPLIANCE METHOD

CF1R-PRF-01-E

Project Name: 1413 Shoshone Residence

Calculation Date/Time: 2024-07-26T17:28:22-07:00

Calculation Description: Title 24 Analysis

Input File Name: 1413_Shoshone_residence_r1_v30.rbd22

(Page 12 of 13)

01	02	03	04	05	06	07	08	09
Name	Verified Airflow	Airflow Target	Verified EER/CEER2	Verified SEER/SEER2	Verified Refrigerant Charge	Verified HSPF/HSPF2	Verified Heating Cap 47	Verified Heating Cap 17
MiniSplit HP 3-herst-tump	Not Required	0	Not Required	Not Required	No	No	Yes	Yes

01	02	03	04	05	06	07	08	09
Dwelling Unit	Airflow (CFM)	Fan Efficacy (W/CFM)	IAQ Fan Type	Includes Heat/Energy Recovery?	IAQ Recovery Effectiveness - SRE/ASRE	Includes Fault Indicator Display?	HERS Verification	Status
Sfarn IAQVentRpt	119	0.35	Exhaust	No	n/a / n/a	No	Yes	

Registration Number: 424-P010143833A-000-000-0000000-0000

Registration Date/Time: 07/27/2024 15:31

HERS Provider: CHEERS

NOTES: This document has been generated by California Home Energy Efficiency Rating Services (CHEERS) using information submitted by third parties not affiliated with or related to CHEERS. Therefore, CHEERS is not responsible for, and cannot guarantee, the accuracy or completeness of the information contained in this document.

CA Building Energy Efficiency Standards - 2022 Residential Compliance

Report Version: 2022.0.000

Report Generated: 2024-07-26 17:29:32

Schema Version: rev 20220901

CERTIFICATE OF COMPLIANCE - RESIDENTIAL PERFORMANCE COMPLIANCE METHOD

CF1R-PRF-01-E

Project Name: 1413 Shoshone Residence

Calculation Date/Time: 2024-07-26T17:28:22-07:00

Calculation Description: Title 24 Analysis

Input File Name: 1413_Shoshone_residence_r1_v30.rbd22

(Page 13 of 13)

01	02	03	04	05	06	07	08	09
Name	System Type	Heating Unit Name	Heating Equipment Count	Cooling Unit Name	Cooling Equipment Count	Fan Name	Distribution Name	Required Thermostat Type
HVAC new 1	Heat pump heating cooling	MiniSplit HP 1	1	MiniSplit HP 1	1	n/a	n/a	Setback

Registration Number: 424-P010143833A-000-000-0000000-0000

Registration Date/Time: 07/27/2024 15:31

HERS Provider: CHEERS

NOTES: This document has been generated by California Home Energy Efficiency Rating Services (CHEERS) using information submitted by third parties not affiliated with or related to CHEERS. Therefore, CHEERS is not responsible for, and cannot guarantee, the accuracy or completeness of the information contained in this document.

CA Building Energy Efficiency Standards - 2022 Residential Compliance

Report Version: 2022.0.000

Report Generated: 2024-07-26 17:29:32

Schema Version: rev 20220901

CERTIFICATE OF COMPLIANCE - RESIDENTIAL PERFORMANCE COMPLIANCE METHOD

CF1R-PRF-01-E

Project Name: 1413 Shoshone ADU

Calculation Date/Time: 2024-07-26T17:28:35-07:00

Calculation Description: Title 24 Analysis

Input File Name: 1413_Shoshone_ADU_v30.rbd22

(Page 1 of 10)

01	02	03	04	05	06	07	08	09
Name	System Type	Heating Unit Name	Heating Equipment Count	Cooling Unit Name	Cooling Equipment Count	Fan Name	Distribution Name	Required Thermostat Type
HVAC new 1	Heat pump heating cooling	MiniSplit HP 1	1	MiniSplit HP 1	1	n/a	n/a	Setback

Registration Number: 424-P010143833A-000-000-0000000-0000

Registration Date/Time: 07/27/2024 15:31

HERS Provider: CHEERS

NOTES: This document has been generated by California Home Energy Efficiency Rating Services (CHEERS) using information submitted by third parties not affiliated with or related to CHEERS. Therefore, CHEERS is not responsible for, and cannot guarantee, the accuracy or completeness of the information contained in this document.

CA Building Energy Efficiency Standards - 2022 Residential Compliance

Report Version: 2022.0.000

Report Generated: 2024-07-26 17:29:32

Schema Version: rev 20220901

CERTIFICATE OF COMPLIANCE - RESIDENTIAL PERFORMANCE COMPLIANCE METHOD

CF1R-PRF-01-E

Project Name: 1413 Shoshone ADU

Calculation Date/Time: 2024-07-26T17:28:35-07:00

Calculation Description: Title 24 Analysis

Input File Name: 1413_Shoshone_ADU_v30.rbd22

(Page 2 of 10)

01	02	03	04	05	06	07	08	09
Name	System Type	Heating Unit Name	Heating Equipment Count	Cooling Unit Name	Cooling Equipment Count	Fan Name	Distribution Name	Required Thermostat Type
HVAC new 1	Heat pump heating cooling	MiniSplit HP 1	1	MiniSplit HP 1	1	n/a	n/a	Setback

Registration Number: 424-P010143833A-000-000-0000000-0000

Registration Date/Time: 07/27/2024 15:31

HERS Provider: CHEERS

NOTES: This document has been generated by California Home Energy Efficiency Rating Services (CHEERS) using information submitted by third parties not affiliated with or related to CHEERS. Therefore, CHEERS is not responsible for, and cannot guarantee, the accuracy or completeness of the information contained in this document.

CA Building Energy Efficiency Standards - 2022 Residential Compliance

Report Version: 2022.0.000

Report Generated: 2024-07-26 17:28:49

Schema Version: rev 20220901

CERTIFICATE OF COMPLIANCE - RESIDENTIAL PERFORMANCE COMPLIANCE METHOD

CF1R-PRF-01-E

Project Name: 1413 Shoshone ADU

Calculation Date/Time: 2024-07-26T17:28:35-07:00

Calculation Description: Title 24 Analysis

Input File Name: 1413_Shoshone_ADU_v30.rbd22

(Page 3 of 10)

01	02	03	04	05	06	07	08	09
Name	System Type	Heating Unit Name	Heating Equipment Count	Cooling Unit Name	Cooling Equipment Count	Fan Name	Distribution Name	Required Thermostat Type
HVAC new 1	Heat pump heating cooling	MiniSplit HP 1	1	MiniSplit HP 1	1	n/a	n/a	Setback

Registration Number: 424-P010143833A-000-000-0000000-0000

Registration Date/Time: 07/27/2024 15:31

HERS Provider: CHEERS

NOTES: This document has been generated by California Home Energy Efficiency Rating Services (CHEERS) using information submitted by third parties not affiliated with or related to CHEERS. Therefore, CHEERS is not responsible for, and cannot guarantee, the accuracy or completeness of the information contained in this document.

CA Building Energy Efficiency Standards - 2022 Residential Compliance

Report Version: 2022.0.000

Report Generated: 2024-07-26 17:28:49

Schema Version: rev 20220901

CERTIFICATE OF COMPLIANCE - RESIDENTIAL PERFORMANCE COMPLIANCE METHOD

CF1R-PRF-01-E

Project Name: 1413 Shoshone ADU

Calculation Date/Time: 2024-07-26T17:28:35-07:00

Calculation Description: Title 24 Analysis

Input File Name: 1413_Shoshone_ADU_v30.rbd22

(Page 4 of 10)

01	02	03	04	05	06	07	08	09
Name	System Type	Heating Unit Name	Heating Equipment Count	Cooling Unit Name	Cooling Equipment Count	Fan Name	Distribution Name	Required Thermostat Type
HVAC new 1	Heat pump heating cooling	MiniSplit HP 1	1	MiniSplit HP 1	1	n/a	n/a	Setback

Registration Number: 424-P010143833A-000-000-0000000-0000

Registration Date/Time: 07/27/2024 15:31

HERS Provider: CHEERS

NOTES: This document has been generated by California Home Energy Efficiency Rating Services (CHEERS) using information submitted by third parties not affiliated with or related to CHEERS. Therefore, CHEERS is not responsible for, and cannot guarantee, the accuracy or completeness of the information contained in this document.

CA Building Energy Efficiency Standards - 2022 Residential Compliance

Report Version: 2022.0.000

Report Generated: 2024-07-26 17:28:49

Schema Version: rev 20220901

CERTIFICATE OF COMPLIANCE - RESIDENTIAL PERFORMANCE COMPLIANCE METHOD

CF1R-PRF-01-E

Project Name: 1413 Shoshone ADU

Calculation Date/Time: 2024-07-26T17:28:35-07:00

Calculation Description: Title 24 Analysis

Input File Name: 1413_Shoshone_ADU_v30.rbd22

(Page 5 of 10)

01	02	03	04	05	06	07	08	09
Name	System Type	Heating Unit Name	Heating Equipment Count	Cooling Unit Name	Cooling Equipment Count	Fan Name	Distribution Name	Required Thermostat Type
HVAC new 1	Heat pump heating cooling	MiniSplit HP 1	1	MiniSplit HP 1	1	n/a	n/a	Setback

Registration Number: 424-P010143833A-000-000-0000000-0000

Registration Date/Time: 07/27/2024 15:31

HERS Provider: CHEERS

NOTES: This document has been generated by California Home Energy Efficiency Rating Services (CHEERS) using information submitted by third parties not affiliated with or related to CHEERS. Therefore, CHEERS is not responsible for, and cannot guarantee, the accuracy or completeness of the information contained in this document.

CA Building Energy Efficiency Standards - 2022 Residential Compliance

Report Version: 2022.0.000

Report Generated: 2024-07-26 17:28:49

Schema Version: rev 20220901



7-1-2025
Geotechnical information only

SHEET

T24-2



2022 Single-Family Residential Mandatory Requirements Summary

NOTE: Single-family residential buildings subject to the Energy Codes must comply with all applicable mandatory measures, regardless of the compliance approach used. Review the respective section for more information.

(04/02/22)

Building Envelope:

§ 110.6(a)(1)	Air Leakage. Manufactured fenestration, exterior doors, and exterior pet doors must limit air leakage to 0.3 CFM per square foot or less when tested per NFRC-400, ASTM E283, or AAMA/WDMA/CSA 1011.5.2/A440-2011.*
§ 110.6(a)(5)	Labeling. Fenestration products and exterior doors must have a label meeting the requirements of § 10-11(a).
§ 110.6(b)	Field fabricated exterior doors and fenestration products must use U-factors and solar heat gain coefficient (SHGC) values from Tables 110.6.A, 110.6.B, or J44.5 for exterior doors. They must be caulked and/or weatherstripped.
§ 110.7	Air Leakage. All joints, penetrations, and other openings in the building envelope that are potential sources of air leakage must be caulked, gasketed, or weather stripped.
§ 110.8(a)	Insulation Certification by Manufacturers. Insulation must be certified by the Department of Consumer Affairs, Bureau of Household Goods and Services (BHSGS).
§ 110.8(g)	Insulation Requirements for Heated Slab Floors. Heated slab floors must be insulated per the requirements of § 110.8(g).
§ 110.8(h)	Roofing Products Solar Reflectance and Thermal Emittance. The thermal emittance and aged solar reflectance values of the roofing material must meet the requirements of § 110.8(h) and be labeled per §10-113 when the installation of a cool roof is specified on the CFI-R.
§ 110.8(i)	Radiant Barrier. When required, radiant barriers must have an emittance of 0.05 or less and be certified to the Department of Consumer Affairs.
§ 150.0(a)	Roof Deck, Ceiling and Rafters Roof Insulation. Roof decks in newly constructed attics in climate zones 4 and 8-16 area-weighted average U-factor not exceeding U-0.184. Ceiling and rafter cavity minimum R-22 insulation in wood frame ceiling, or area-weighted average U-factor must not exceed 0.043. Rafter roof alterations minimum R-19 or area-weighted average U-factor of 0.054 or less. Attic access doors must have permanently attached insulation using adhesive or mechanical fasteners. The attic access must be gasketed to prevent air leakage. Insulation must be installed in direct contact with a roof or ceiling which is sealed to limit infiltration and exfiltration, as specified in § 110-17, including but not limited to placing insulation either above or below the roof deck or on top of a drywall ceiling.
§ 150.0(b)	Loose-fill Insulation. Loose fill insulation must meet the manufacturer's required density for the labeled R-value.
§ 150.0(c)	Wall Insulation. Minimum R-13 insulation in 2x4 inch wood framing wall or have a U-factor of 0.102 or less, or R-20 in 2x6 inch wood framing or have a U-factor of 0.071 or less. Opaque non-framed assemblies must have an overall assembly U-factor not exceeding 0.102. Masonry walls must meet Tables 150-1.A or B.*
§ 150.0(d)	Raised-floor Insulation. Minimum R-19 insulation in raised wood framed floor or 0.037 maximum U-factor.*
§ 150.0(f)	Slab Edge Insulation. Slab edge insulation must meet all of the following: have a water absorption rate, for the insulation material alone without findings, no greater than 0.3 percent; have a water vapor permeance no greater than 2.0 perm per inch; be protected from physical damage and UV light deterioration; and, when installed as part of a heated slab floor, meet the requirements of § 110.8(g).
§ 150.0(g)(1)	Vapor Retarder. In climate zones 1 through 16, the earth floor of unvented crawl space must be covered with a Class I or Class II vapor retarder. This requirement also applies to controlled ventilation crawl space for buildings complying with the exception to §150.0(d).
§ 150.0(g)(2)	Vapor Retarder. In climate zones 14 and 16, a Class I or Class II vapor retarder must be installed on the conditioned space side of all insulation in all exterior walls, vented attics, and unvented attics with air-permeable insulation.
§ 150.0(i)	Fenestration Products. Fenestration, including skylights, separating conditioned space from unconditioned space or outdoors must have a maximum U-factor of 0.45; or area-weighted average U-factor of all fenestration must not exceed 0.45.*

Fireplaces, Decorative Gas Appliances, and Gas Log:

§ 110.5(e)	Pilot Light. Continuously burning pilot lights are not allowed for indoor and outdoor fireplaces.
§ 150.0(e)(1)	Closable Doors. Masonry or factory-built fireplaces must have a closable metal or glass door covering the entire opening of the firebox.
§ 150.0(e)(2)	Combustion Intake. Masonry or factory-built fireplaces must have a combustion outside air intake, which is at least 6 square inches in area and is equipped with a readily accessible, operable, and light-fitting damper or combustion-air control device.
§ 150.0(i)(3)	Flue Damper. Masonry or factory-built fireplaces must have a flue damper with a readily accessible control.*

Space Conditioning, Water Heating, and Plumbing System:

§ 110.0-§ 110.3	Certification. Heating, ventilation, and air conditioning (HVAC) equipment, water heaters, showerheads, faucets, and all other regulated appliances must be certified by the manufacturer to the California Energy Commission.
§ 110.2(a)	HVAC Efficiency. Equipment must meet the applicable efficiency requirements in Table 110.2.A through Table 110.2.H.*
§ 110.2(b)	Controls for Heat Pumps with Supplementary Electric Resistance Heaters. Heat pumps with supplementary electric resistance heaters must have controls that prevent supplementary heater operation when the heating load can be met by the heat pump alone; and in which the out-on-temperature for compression heating is higher than the out-on-temperature for supplementary heating, and the out-off-temperature for compression heating is higher than the out-off-temperature for supplementary heating.
§ 110.2(c)	Thermostats. All heating or cooling systems not controlled by a certified energy management control system (EMCS) must have a setback thermostat.
§ 110.3(c)(3)	Insulation. Unfired service water heater storage tanks and solar water-heating backup tanks must have adequate insulation, or tank surface heat loss rating.
§ 110.3(c)(6)	Isolation Valves. Instantaneous water heaters with an input rating greater than 6.8 kBtu per hour (2 kW) must have isolation valves with hose bibbs or other fittings on both cold and hot water lines to allow for flushing the water heater when the valves are closed.

5/6/22



2022 Single-Family Residential Mandatory Requirements Summary

§ 110.5	Pilot Lights. Continuously burning pilot lights are prohibited for natural gas, fan-type central furnaces, household cooking appliances (except appliances without an electrical supply voltage connection with pilot lights that consume less than 150 Btu per hour), and pool and spa heaters.*
§ 150.0(h)(1)	Building Cooling and Heating Loads. Heating and/or cooling loads are calculated in accordance with the ASHRAE Handbook, Equipment Volume, Applications Volume, and Fundamentals Volume, the SMACNA Residential Comfort System Installation Standards Manual, or the ACCA Manual J using design conditions specified in § 150.0(h)(2).
§ 150.0(h)(3A)	Cleanances. Air conditioner and heat pump outdoor condensing units must have a clearance of at least five feet from the outlet of any dryer.
§ 150.0(h)(3B)	Liquid Line Drier. Air conditioners and heat pump systems must be equipped with liquid line filter driers if required, as specified by the manufacturer's instructions.
§ 150.0(i)(1)	Water Piping, Solar Water-heating System Piping, and Space Conditioning System Line Insulation. All domestic hot water piping must be insulated as specified in § 609.11 of the California Plumbing Code.*
§ 150.0(i)(2)	Insulation Protection. Piping insulation must be protected from damage, including that due to sunlight, moisture, equipment maintenance, and wind as required by § 120.3(b). Insulation exposed to weather must be water resistant and protected from UV light (no adhesive tapes). Insulation covering chilled water piping and refrigerant suction piping located outside the conditioned space must include, or be protected by, a Class I or Class II vapor retarder. Pipe insulation buried below grade must be installed in a waterproof and non-crushable casing or sleeve.
§ 150.0(n)(1)	Gas or Propane Water Heating Systems. Systems using gas or propane water heaters to serve individual dwelling units must designate a space at least 2.5' x 2.5' x 7' suitable for the future installation of a heat pump water heater, and meet electrical and plumbing requirements, based on the distance between this designated space and the water heater location, and a condensate drain no more than 2" higher than the base of the water heater.
§ 150.0(h)(3)	Solar Water-heating Systems. Solar water-heating systems and collectors must be certified and rated by the Solar Rating and Certification Corporation (SRCC), the International Association of Plumbing and Mechanical Officials, Research and Testing (IAPMO R&T), or by a listing agency that is approved by the executive director.

Ducts and Fans:

§ 110.8(d)(3)	Ducts. Insulation installed on an existing space conditioning duct must comply with § 604.0 of the California Mechanical Code (CMC). If a contractor installs the insulation, the contractor must certify to the customer, in writing, that the insulation meets this requirement.
§ 150.0(m)(1)	CMC Compliance. All air-distribution system ducts and plenums must meet CMC §§ 601.0-605.0 and ANSI/SMACNA-006-2006 HVAC Duct Construction Standards Metal and Flexible 3rd Edition. Portions of supply-air and return-air ducts and plenums must be insulated to R-6.0 or higher; ducts located entirely in conditioned space as confirmed through field verification and diagnostic testing (RA3.1.4.3.8) do not require insulation. Connections of metal ducts and inner cores of flexible ducts must be mechanically fastened. Openings must be sealed with mastic, tape, or other duct-closure system that meets the applicable UL requirements, or aerosol sealant that meets UL 723. The combination of mastic and either mesh or tape must be used to seal openings greater than 1/4". If mastic or tape is used, Building cavities, air handler support platforms, and plenums designed or constructed with materials other than sealed sheet metal, duct board or flexible duct must not be used to convey conditioned air. Building cavities and support platforms may contain ducts, ducts installed in these spaces must not be compressed.*
§ 150.0(m)(2)	Factory-Fabricated Duct Systems. Factory-fabricated duct systems must comply with applicable requirements for duct construction, connections, and closures; joints and seams of duct systems and their components must not be sealed with cloth back rubber adhesive duct tapes unless such tape is used in combination with mastic and draw bands.
§ 150.0(m)(3)	Field-Fabricated Duct Systems. Field-fabricated duct systems must comply with applicable requirements for: pressure-sensitive tapes, mastics, sealants, and other requirements specified for duct construction.
§ 150.0(m)(7)	Backdraft Damper. Fan systems that exchange air between the conditioned space and outdoors must have backdraft or automatic dampers.
§ 150.0(m)(8)	Gravity Ventilation Dampers. Gravity ventilating systems serving conditioned space must have either automatic or readily accessible manually operated dampers in all openings to the outside, except combustion inlet; and outlet air openings and elevator shaft vents.
§ 150.0(m)(9)	Protection of Insulation. Insulation must be protected from damage due to sunlight, moisture, equipment maintenance, and wind. Insulation exposed to weather must be suitable for outdoor service (e.g., protected by aluminum, sheet metal, painted canvas, or plastic cover). Cellular foam insulation must be protected as above or painted with a water resistant and solar radiation-resistant coating.
§ 150.0(m)(10)	Porous Inner Core Flex Duct. Porous inner cores of flex ducts must have a non-porous layer or air barrier between the inner core and outer vapor barrier.
§ 150.0(m)(11)	Duct System Sealing and Leakage Test. When space conditioning systems use forced air duct systems to supply conditioned air to an occupiable space, the ducts must be sealed and duct leakage tested, as confirmed through field verification and diagnostic testing, in accordance with Reference Residential Appendix RA3.1.
§ 150.0(m)(12)	Air Filtration. Space conditioning systems with ducts exceeding 10 feet and the supply side of ventilation systems must have MERV 13 or equivalent filters. Filters for space conditioning systems must have a two inch depth or can be one inch if sized per Equation 150.0-A. Clean-filter pressure drop and labeling must meet the requirements in §150.0(m)(12). Filters must be accessible for regular service. Filter racks or grilles must use gaskets, sealing, or other means to close gaps around the inserted filters to and prevents air from bypassing the filter.*

5/6/22



2022 Single-Family Residential Mandatory Requirements Summary

§ 150.0(e)	Energy Storage System (ESS) Ready. All single-family residences must meet all of the following: Either ESS-ready interconnection equipment with backed up capacity of 60 amps or more and four or more ESS supplied branch circuits; 2x a dedicated raceway from the main service to a subpanel that supplies the branch circuits in § 150.0(e); at least four branch circuits must be identified and have their source collected at a single panelboard suitable to be supplied by the ESS; with one circuit supplying the refrigerator, one lighting circuit near the primary exit, and one circuit supplying a sleeping room receptacle outlet; main panelboard must have a minimum busbar rating of 225 amps, sufficient space must be reserved to allow future installation of a system isolation equipment/transfer switch within 3' of the main panelboard, with raceways installed between the panelboard and the switch location to allow the connection of backup power source.
§ 150.0(f)	Heat Pump Space Heater Ready. Systems using gas or propane furnaces to serve individual dwelling units must include: A dedicated unobstructed 240V branch circuit wiring installed within 3' of the furnace with circuit conductors rated at least 30 amps with the blank cover identified as "240V ready"; and a reserved main electrical service panel space to allow for the installation of a double pole circuit breaker permanently marked as "For Future 240V use."
§ 150.0(g)	Electric Cooktop Ready. Systems using gas or propane cooktop to serve individual dwelling units must include: A dedicated unobstructed 240V branch circuit wiring installed within 3' of the cooktop with circuit conductors rated at least 50 amps with the blank cover identified as "240V ready"; and a reserved main electrical service panel space to allow for the installation of a double pole circuit breaker permanently marked as "For Future 240V use."
§ 150.0(h)	Electric Clothes Dryer Ready. Clothes dryer locations with gas or propane plumbing to serve individual dwelling units must include: A dedicated unobstructed 240V branch circuit wiring installed within 3' of the dryer location with circuit conductors rated at least 30 amps with the blank cover identified as "240V ready"; and a reserved main electrical service panel space to allow for the installation of a double pole circuit breaker permanently marked as "For Future 240V use."

*Exceptions may apply.

5/6/22



2022 Single-Family Residential Mandatory Requirements Summary

§ 150.0(m)(3)	Space Conditioning System Airflow Rate and Fan Efficacy. Space conditioning systems that use ducts to supply cooling must have a hole for the placement of a static pressure probe, or a permanently installed static pressure probe in the supply plenum. Airflow must be ≥ 350 CFM per ton of nominal cooling capacity, and an air-handling unit fan efficacy ≤ 0.45 watts per CFM for gas furnace air handlers and ≤ 0.58 watts per CFM for all others. Small duct high velocity systems must provide an airflow ≥ 250 CFM per ton of nominal cooling capacity, and an air-handling unit fan efficacy ≤ 0.62 watts per CFM. Field verification testing is required in accordance with Reference Residential Appendix RA3.3.*
---------------	--

Ventilation and Indoor Air Quality:

§ 150.0(o)(1)	Requirements for Ventilation and Indoor Air Quality. All dwelling units must meet the requirements of ASHRAE Standard 62.2, Ventilation and Acceptable Indoor Air Quality in Residential Buildings subject to the amendments specified in § 150.0(o)(1).*
§ 150.0(o)(1B)	Central Fan Integrated (CFI) Ventilation Systems. Continuous operation of CFI air handlers is not allowed to provide the whole-dwelling unit ventilation airflow required per §150.0(o)(1C). A motorized damper(s) must be installed on the ventilation duct(s) that prevents all airflow through the space conditioning duct system when the damper(s) is closed and uncontrolled per §150.0(o)(1)Bii.iv. CFI ventilation systems must have controls that track outdoor air ventilation run time, and either open or close the motorized damper(s) for compliance with §150.0(o)(1C).
§ 150.0(o)(1C)	Whole-Dwelling Unit Mechanical Ventilation for Single-Family Detached and townhouses. Single-family detached dwelling units, and attached dwelling units not sharing ceilings or floors with other dwelling units, occupiable spaces, public garages, or commercial spaces must have mechanical ventilation airflow specified in § 150.0(o)(1C)-ii.
§ 150.0(o)(1G)	Local Mechanical Exhaust. Kitchens and bathrooms must have local mechanical exhaust, nonrecirculating exhaust fans must have demand-controlled exhaust system meeting requirements of §150.0(o)(1)Gii.ii enclosed kitchens and bathrooms can use demand-controlled or continuous exhaust meeting §150.0(o)(1)Gii-iv. Airflow must be measured by the installer per §150.0(o)(1)Gv, and rated for sound per §150.0(o)(1)Gvi.*
§ 150.0(o)(1H)(i)	Airflow Measurement and Sound Ratings of Whole-Dwelling Unit Ventilation Systems. The airflow required per § 150.0(o)(1C) must be measured by using a flow hood, flow grid, or other airflow measuring device at the fan's inlet or outlet terminals/grilles per Reference Residential Appendix RA3.7. Whole-Dwelling unit ventilation systems must be rated for sound per ASHRAE 62.2 §7.2 at no less than the minimum airflow rate required by §150.0(o)(1C).
§ 150.0(o)(2)	Field Verification and Diagnostic Testing. Whole-Dwelling Unit ventilation airflow, vented range hood airflow and sound rating, and HRV and ERV fan efficacy must be verified in accordance with Reference Residential Appendix RA3.7. Vented range hoods must be verified per Reference Residential Appendix RA3.7.4.3 to confirm if it is rated by HVI or AHAM to comply with the airflow rates and sound requirements per §150.0(o)(1G).

Pool and Spa Systems and Equipment:

§ 110.4(a)	Certification by Manufacturers. Any pool or spa heating system or equipment must be certified to have all of the following: compliance with the Appliance Efficiency Regulations and listing in MAEDS; an on-off switch mounted outside of the heater that allows shutting off the heater without adjusting the thermostat setting; a permanent weatherproof plate or card with operating instructions; and must not use electric resistance heating.*
§ 110.4(b)(1)	Piping. Any pool or spa heating system or equipment must be installed with at least 36 inches of pipe between the filter and the heater, or dedicated suction and return lines, or built-in or built-up connections to allow for future solar heating.
§ 110.4(b)(2)	Covers. Outdoor pools or spas that have a heat pump or gas heater must have a cover.
§ 110.4(b)(3)	Directional Inlets and Time Switches for Pools. Pools must have directional inlets that adequately mix the pool water, and a time switch that will allow all pumps to be set or programmed to run only during off-peak electric demand periods.
§ 110.5	Pilot Light. Natural gas pool and spa heaters must not have a continuously burning pilot light.
§ 150.0(p)	Pool Systems and Equipment Installation. Residential pool systems or equipment must meet the specified requirements for pump sizing, flow rate, piping, filters, and valves.

Lighting:

§ 110.9	Lighting Controls and Components. All lighting control devices and systems, ballasts, and luminaires must meet the applicable requirements of § 110.9.*
§ 150.0(k)(1A)	Luminaire Efficacy. All installed luminaires must meet the requirements in Table 150.0-A, except lighting integral to exhaust fans, kitchen range hoods, bath vanity mirrors, and garage door openers, navigation lighting less than 5 watts, and lighting internal to drawers, cabinets, and linen closets with an efficacy of at least 45 lumens per watt.
§ 150.0(k)(1B)	Screw-based luminaires. Screw-based luminaires must contain lamps that comply with Reference, Joint Appendix JAB.*
§ 150.0(k)(1C)	Recessed Downlight Luminaires in Ceilings. Luminaires recessed into ceilings must not contain screw-based sockets, must be airtight, and must be sealed with a gasket or caulk. California Electrical Code § 410.116 must also be met.
§ 150.0(k)(1D)	Light Sources in Enclosed or Recessed Luminaires. Lamps and other separable light sources that are not compliant with the JAB elevated temperature requirements, including marking requirements, must not be installed in enclosed or recessed luminaires.
§ 150.0(k)(1E)	Blank Electrical Boxes. The number of electrical boxes that are more than five feet above the finished floor and do not contain a luminaire or other device shall be no more than the number of bedrooms. These boxes must be served by a dimmer, vacancy sensor control, low voltage wiring, or fan speed control.
§ 150.0(k)(1F)	Lighting Integral to Exhaust Fans. Lighting integral to exhaust fans (except when installed by the manufacturer in kitchen exhaust hoods) must meet the applicable requirements of § 150.0(k).

5/6/22



2022 Single-Family Residential Mandatory Requirements Summary

§ 150.0(k)(1G)	Screw-based luminaires. Screw-based luminaires must contain lamps that comply with Reference Joint Appendix JAB.*
§ 150.0(k)(1H)	Light Sources in Enclosed or Recessed Luminaires. Lamps and other separable light sources that are not compliant with the JAB elevated temperature requirements, including marking requirements, must not be installed in enclosed or recessed luminaires.
§ 150.0(k)(1I)	Light Sources in Drawers, Cabinets, and Linen Closets. Light sources internal to drawers, cabinetry or linen closets are not required to comply with Table 150.0-A or be controlled by vacancy sensors provided that they are rated to consume no more than 5 watts of power, emit no more than 150 lumens, and are equipped with controls that automatically turn the lighting off when the drawer, cabinet or linen closet is closed.
§ 150.0(k)(2A)	Interior Switches and Controls. All forward phase out dimmers used with LED light sources must comply with NEMA SSL 7A.
§ 150.0(k)(2B)	Interior Switches and Controls. Exhaust fans must be controlled separately from lighting systems.*
§ 150.0(k)(2A)	Accessible Controls. Lighting must have readily accessible wall-mounted controls that allow the lighting to be manually turned on and off.*
§ 150.0(k)(2B)	Multiple Controls. Controls must not bypass a dimmer, occupant sensor, or vacancy sensor function if the dimmer or sensor is installed to comply with § 150.0(k).
§ 150.0(k)(2C)	Mandatory Requirements. Lighting controls must comply with the applicable requirements of § 110.9.
§ 150.0(k)(2D)	Energy Management Control Systems. An energy management control system (EMCS) may be used to comply with dimming, occupancy, and control requirements if it provides the functionality of the specified control per § 110.9 and the physical controls specified in § 150.0(k)(2A).
§ 150.0(k)(2E)	Automatic Shutoff Controls. In bathrooms, garages, laundry rooms, utility rooms and walk-in closets, at least one installed luminaire must be controlled by an occupancy or vacancy sensor providing automatic off functionality. Lighting inside drawers and cabinets with opaque fronts or doors must have controls that turn the light off when the drawer or door is closed.
§ 150.0(k)(2F)	Dimmers. Lighting in habitable spaces (e.g., living rooms, dining rooms, kitchens, and bedrooms) must have readily accessible wall-mounted dimming controls that allow the lighting to be manually adjusted up and down. Forward phase out dimmers controlling LED light sources in these spaces must comply with NEMA SSL 7A.
§ 150.0(k)(2K)	Independent controls. Integrated lighting of exhaust fans shall be controlled independently from the fans. Lighting under cabinets or shelves, lighting in display cabinets, and switched outlets must be controlled separately from ceiling-installed lighting.
§ 150.0(p)(3A)	Residential Outdoor Lighting. For single-family residential buildings, outdoor lighting permanently mounted to a residential building, or to other buildings on the same lot, must have a manual on/off switch and either a photocell and motion sensor or automatic time switch control) or an astronomical time clock. An energy management control system that provides the specified control functionality and meets all applicable requirements may be used to meet these requirements.
§ 150.0(k)(4)	Internally illuminated address signs. Internally illuminated address signs must either comply with § 140.8 or consume no more than 5 watts of power.
§ 150.0(k)(5)	Residential Garages for Eight or More Vehicles. Lighting for residential parking garages for eight or more vehicles must comply with the applicable requirements for nonresidential garages in §§ 110.9, 130.0, 130.1, 130.4, 140.6, and 141.0.

Solar Readiness:

§ 110.10(a)(1)	Single-family Residences. Single-family residences located in subdivisions with 10 or more single-family residences and where the application for a tentative subdivision map for the residences has been deemed complete and approved by the enforcement agency, which do not have a photovoltaic system installed, must comply with the requirements of § 110.10(b)-(e).
§ 110.10(b)(1A)	Minimum Solar Zone Area. The solar zone must have a minimum total area as described below. The solar zone must comply with access, pathway, smoke ventilation, and spacing requirements as specified in Title 24, Part 9 or other parts of Title 24 or in any requirements adopted by a local jurisdiction. The solar zone total area must be comprised of areas that have no dimension less than 5 feet and are no less than 80 square feet each for buildings with roof areas less than or equal to 10,000 square feet or no less than 160 square feet each for buildings with roof areas greater than 10,000 square feet. For single-family residences, the solar zone must be located on the roof or overhang of the building and have a total area no less than 250 square feet.*
§ 110.10(b)(2)	Azimuth. All sections of the solar zone located on steep-sloped roofs must have an azimuth between 90-300° of true north.
§ 110.10(b)(3A)	Shading. The solar zone must not contain any obstructions, including but not limited to: vents, chimneys, architectural features, and roof-mounted equipment.
§ 110.10(b)(3B)	Shading. Any obstruction located on the roof or any other part of the building that projects above a solar zone must be located at least twice the horizontal distance of the height difference between the highest point of the obstruction and the horizontal projection of the nearest point of the solar zone, measured in the vertical plane.*
§ 110.10(b)(4)	Structural Design Loads on Construction Documents. For areas of the roof designated as a solar zone, the structural design loads for roof dead load and roof live load must be clearly indicated on the construction documents.
§ 110.10(c)	Interconnection Pathways. The construction documents must indicate a location reserved for inverters and metering equipment and a pathway reserved for routing of conduit from the solar zone to the point of interconnection with the electrical service, and for single-family residences and central water heating systems, a pathway reserved for routing plumbing from the solar zone to the water-heating system.
§ 110.10(d)	Documentation. A copy of the construction documents or a comparable document indicating the information from § 110.10(b)-(c) must be provided to the occupant.
§ 110.10(e)(1)	Main Electrical Service Panel. The main electrical service panel must have a minimum busbar rating of 200 amps.
§ 110.10(e)(2)	Main Electrical Service Panel. The main electrical service panel must have a reserved space to allow for the installation of a double pole circuit breaker for a future solar electric installation. The reserved space must be permanently marked as "For Future Solar Electric."

Electric and Energy Storage Ready:

5/6/22

7-1-2025

Geotechnical information only

SHEET

T24-M

[illegible]

DISCLAIMER: THIS DOCUMENT IS PROVIDED AND INTENDED TO BE USED AS A MEANS TO INDICATE AREAS OF COMPLIANCE WITH THE CALIFORNIA GREEN BUILDING STANDARDS (CALGREEN) CODE. DUE TO THE VARIABLES BETWEEN BUILDING DEPARTMENT JURISDICTIONS, THIS CHECKLIST IS TO BE USED ON AN INDIVIDUAL PROJECT BASIS AND MAY BE MODIFIED BY THE END USER TO MEET THOSE INDIVIDUAL NEEDS. THE END USER ASSUMES ALL RESPONSIBILITY ASSOCIATED WITH THE USE OF THIS DOCUMENT, INCLUDING VERIFICATION WITH THE FULL CODE.

- A. General**
- Applicable codes.** All projects will comply with the following building codes and associated County of San Diego amendment.
- 2022 California Building Code (CBC) and/or California Residential Code (CRC)
 - 2022 California Green Building Standards Code (CalGreen)
 - 2022 California Electrical Code (CEC)
 - 2022 California Mechanical Code (CMC)
 - 2022 California Plumbing Code (CPC)
 - 2022 California Fire Code (CFC)
 - 2022 California Building Energy Efficiency Standards (CEES)

B. Electrical, Plumbing, and Mechanical

- Exterior lighting.** All projects shall comply with the County of San Diego lighting ordinance.
- GFCI outlets.** Ground Fault Circuit Interrupter (GFCI) outlets are required in bathrooms, at kitchen countertops, at laundry and wet bar sinks, in garages, in crawlspaces, in unfinished basements and outdoors. (CEC 410.3)
- AFCI outlets.** Electrical circuits in bedrooms, living rooms, dining rooms, dens, closets, hallways, or similar rooms must be protected by Arc Fault Circuit Interrupters (AFCI). (CEC 210.12)
- Luminaire requirements.** Installed luminaires shall meet the efficacy and fixture requirements of CEES 150.0(k).
- Smoke detectors in building remodels.** Smoke detectors are required in each existing sleeping room, outside each separate sleeping area in the immediate vicinity of sleeping rooms, and on each story of a dwelling including basements. Battery-operated detectors are acceptable in existing areas with no construction taking place and in alterations not resulting in removal of interior wall or ceiling finishes and without access via an attic, crawl space, or basement. (CRC R314.3)
- Carbon monoxide detectors in building remodels.** Carbon monoxide detectors are required outside each separate sleeping area in the immediate vicinity of sleeping rooms and on each story of a dwelling including basements. Battery-operated detectors are acceptable in existing areas with no construction taking place and in alterations not resulting in removal of interior wall or ceiling finishes and without access via an attic, crawl space, or basement. (CRC R315.3)
- Water heater seismic strapping.** Minimum two 3/4-inch-by-24-gauge straps required around water heaters, with 1/4-inch-by-3-inch lag bolts attached directly to framing. Straps shall be at points within upper third and lower third of water heater vertical dimension. Lower connection shall occur minimum 4 inches above controls. (CPC 507.2)
- Gas appliances in garages.** Water heaters and heating/cooling equipment capable of igniting flammable vapors shall be placed on minimum 18-inch-high platform unless listing report number provided showing ignition source protection. (CPC 507.13 and CMC 305.1)
- Impact protection of appliances.** Water heaters and heating/cooling equipment subject to vehicular impact shall be protected by bollards or an equivalent measure. (CPC 507.13.1 and CMC 305.1.1)
- Water closet clearance.** Minimum 30-inch-wide by 24-inch-deep clearance required at front of water closets. (CRC 402.5)
- Show size.** Shower compartments shall have minimum area of 1024 square inches and be able to encompass a 36-inch-diameter circle. Shower doors shall have a minimum 22-inch unobstructed width. (CPC 408.5 and CPC 408.6)
- Fireplace appliances.** Fireplaces with gas appliances are required to have the fire damper permanently fixed in the open position and fireplaces with LPG appliances are to have no "pit" or "lump" configurations. (CMC 303.1.1)
- Chimney clearance.** Minimum 2-foot chimney clearance required above building within 10-foot horizontally of chimney. The chimney shall extend minimum 3 feet above highest point where chimney passes through roof. (CRC R1003.9)

C. Mechanical Ventilation and Indoor Air Quality (ASHRAE 62.2-2010)

- Transfer air.** Ventilation air shall be provided directly from the outdoors and not as transfer air from adjacent dwelling units or other spaces, such as garages, unconditioned crawlspaces, or unconditioned attics. (CEES 150.0(i))
 - Instructions and labeling.** Ventilation system controls shall be labeled, and the homeowner shall be provided with instructions on how to operate the system. (CEES 150.0(i))
 - Combustion and solid-fuel burning appliances.** Combustion appliances shall be properly vented and air systems shall be designed to prevent back drafting. (CEES 150.0(i))
 - Garages.** The wall and openings between occupiable spaces and the garage shall be sealed. HVAC systems that include air handlers or return ducts located in garages shall have total air leakage of no more than 6% of total face area when measured at 0.1 in. w.c. using California Title 24 or equivalents. (CEES 150.0(i))
 - Minimum filtration.** Mechanical systems supplying air to occupiable space through ductwork shall be provided with a filter having a minimum efficiency of MERV 6 or better. (CEES 150.0(i))
 - Air inlets.** Air inlets (not exhaust) shall be located away from known contaminants. (CEES 150.0(i))
 - Air moving equipment.** Air moving equipment used to meet either the whole-building ventilation requirement or the local ventilation exhaust requirement shall be rated in terms of airflow and sound. (CEES 150.0(i))
- a. All continuously operated fans shall be rated at a maximum of 1.0 sone.
- b. Intermittently operated whole-building ventilation fans shall be rated at a maximum of 1.0 sone.
- c. Intermittently operated local exhaust fans shall be rated at maximum of 3.0 sone.
- d. Remotely located air-moving equipment (mounted outside of habitable spaces) need not meet sound requirements if at least 4 feet of ductwork between fan and intake grill.

D. Foundation and Underfloor

- Foundation reinforcement.** Continuous footings and stem walls shall be provided with a minimum two longitudinal No. 4 bars, one at the top and one at the bottom of the footing. (CRC R403.1.3.3)
- Shear wall foundation support.** Shear walls shall be supported by continuous foundations. (CRC 403.1.2)
- Concrete slabs-on-grade.** Slabs-on-grade shall be minimum 3-1/2-inches thick. (CRC R506.1)
- Vapor retarder.** A 10-mil polyethylene or approved vapor retarder with joints lapped minimum 6 inches shall be placed between a concrete slab-on-grade and the base course or subgrade. (CRC 506.2.3)
- Anchor bolts and sills.** Foundation plates or sills shall be bolted or anchored to the foundation or foundation wall per the following (CRC R403.1.6 and CRC R602.11.1):
 - Minimum 1/2-inch-diameter steel bolts
 - Bolts embedded at least 7 inches into concrete or masonry
 - Bolts spaced maximum 6 feet on center
 - Minimum two bolts per plate/sill piece with one bolt located maximum 12 inches and minimum 7 bolt diameters from each end of each sill plate/plate
 - Minimum 3-inch by 3-inch by 1/299-inch steel plate washer between sill and nut on each bolt
- Hold-downs.** All hold-downs must be tied in place prior to foundation inspection.

- Celling joists and rafter connections.** Ceiling joists and rafters shall be nailed to each other per CRC Table R802.5.1(9), and the rafter shall be nailed to the wall top plate per CRC Table R802.3(1). Ceiling joists shall be continuous or securely joined per CRC Table R802.5.1(9) where they meet over interior partitions and are nailed to adjacent rafters to provide a continuous tie across the building when such joists are parallel to rafters. Where ceiling joists are not connected to the rafters at the wall top plate, joists connected higher in the attic shall be installed as rafter ties, or rafter ties shall be installed to provide a continuous tie. Where ceiling joists are not parallel to rafters, rafter ties shall be installed. Rafter ties shall be minimum 2 inches by 4 inches nominal, installed per CRC Table R802.5.1(9), or connections of equivalent capacities shall be provided. Where ceiling joists or rafter ties are not provided, the ridge formed by these rafters shall be supported by a wall or engineer designed girder. (CRC R802.3.1)
- Collar ties.** Collar ties or ridge straps to resist wind uplift shall be connected in the upper third of the attic space. Collar ties shall be a minimum 1 inch by 4 inches nominal and spaced at maximum 4 feet on center. (CRC R802.3.1)
- Purins.** Purins installed to reduce the span of rafters shall be sized not less than the required size of the rafters they support. Purins shall be continuous and shall be supported by 2-inch by 4-inch nominal braces installed to bearing walls at a minimum 45-degree slope from horizontal. The braces shall be spaced maximum 4 feet on center with a maximum 8-foot unbraced length. (CRC R802.3.1)
- Roofing member blocking.** The ends of each rafter or ceiling joist shall have not less than 1-1/2 inches of bearing on wood or metal and not less than 3 inches of bearing on masonry or concrete. (CRC R802.6)
- Roofblocking member lateral support.** Roof framing members and ceiling joists with a nominal depth-thickness ratio exceeding 5:1 shall be provided with lateral support at points of bearing to prevent rotation. (CRC R802.8)
- Roofblocking member blocking.** Rafters and ceiling joists with a nominal depth-thickness ratio exceeding 6:1 shall be supported laterally by solid blocking, diagonal bracing (wood or metal), or a continuous 1-inch-by-3-inch wood strip nailed across the rafters or ceiling joists at maximum 8-foot intervals. (CRC R802.8)

E. Wood Framing

- Fastener requirements.** The number, size, and spacing of fasteners connecting wood members/elements shall not be less than that set forth in CRC Table R602.3.1, (CRC R802.9, CRC R802.3, and CRC R802.2)
- Stud size, height, and spacing.** The size, height, and spacing of studs shall be in accordance with CRC Table R602.3.5(1) and CRC R602.3.1

E. Wood Framing (Continued)

- Sill plate.** Studs shall have full bearing on nominal 2-inch thick or larger sill plate with width at least equal to the stud width. (CRC R602.3.4)
- Bearing studs.** Where joists, trusses, or rafters are spaced more than 16 inches on center and the bearing studs beneath are spaced 24 inches on center, such members shall bear within 5 inches of the studs below. (CRC R602.3.3)
- Drilling and notching of studs.** Any stud in an exterior wall or bearing partition may be cut or notched to a depth not exceeding 25% of its width. Studs in nonbearing partitions may be notched to a depth not to exceed 40% of a single stud width. Any stud may be bored or drilled, provided the diameter of the resulting hole is no more than 60% of the stud width, the edge of the hole is no more than 5/8 inch to the edge of the stud, and the hole is not located in the same section as a cut or notch. Studs located in exterior wall or bearing partitions drilled over 40% and up to 60% shall also be doubled with not more than two successive studs bored. (CRC R602.6)
- Top plate.** Wood stud walls shall be capped with a double top plate installed to provide overlapping at corners and at intersections with other partitions. End joints in double top plates shall be offset at least 24 inches. Joints in plates need not occur over studs. Plates shall be minimum nominal 2 inches thick and have width at least equal to width of studs. (CRC R602.3.2)
- Top plate splices.** Top plate lap splices shall be face-nailed with minimum 8 16d nails on each side of splice. (CRC R602.10.8.1)
- Drilling and notching of top plate.** When piping or ductwork is placed in or partly in an exterior wall or interior load-bearing wall, necessitating cutting, drilling, or notching of the top plate by more than 50% of its width, a galvanized metal tie not less than 0.054-inch thick and 1-1/2 inches wide shall be fastened across and to the plate at each side of the opening with not less than 8 16d nails having a minimum length of 1-1/2 inches at each side or equivalent. The metal tie must extend minimum 6 inches past the opening. (CRC R602.6.1)
- Cripple walls.** Foundation cripple walls shall be framed of studs not less in size than the stud above. Cripple walls more than 4 feet in height shall have studs sized as required for an additional story. Cripple walls less than 14 inches high shall have studs sized as required for at least one side with a wood structural panel fastened to both the top and bottom plates in accordance with Table R602.3(1), or the cripple walls shall be constructed of solid blocking. Cripple walls shall be supported on continuous foundations. (CRC R602.9)
- Wall bracing.** Buildings shall be braced in accordance with the methods allowed per CRC R602.10.2 (32) for seismic loads, CRC R602.10.4, and/or CRC R602.10.5.
- Braced wall line spacing.** Spacing between braced wall lines shall not exceed 20 feet or alternate provisions of CRC R602.10.3.1.
- Shear wall cumulative length.** The cumulative length of shear walls within each braced wall line shall meet the provisions of CRC Table R602.10.3(1) for wind loads and CRC Table R602.10.3(2) for seismic loads. (CRC R602.10.1)
- Shear wall spacing.** Shear walls shall be located not more than 25 feet on center. (CRC R602.10.2.2)
- Shear wall offset.** Shear walls may be offset out-of-plan not more than 4 feet from the designated braced wall line and not more than 8 feet from any other offset wall considered part of the same braced wall line. (CRC R602.10.1.2)
- Shear wall location.** Shear walls shall be located at the ends of each braced wall line or meet at the alternate provisions of CRC R602.10.2.2.
- Individual shear wall length.** Shear walls shall meet minimum length requirements of CRC R602.10.6.5.1.
- Cripple wall bracing.** Cripple walls shall be braced per CRC R602.10.11.
- Shear wall and diaphragm nailing.** All shear walls, roof diaphragms, and floor diaphragms shall be nailed to supporting construction per CRC Table R602.3(1), (CRC R604.3)
- Shear wall joints.** All vertical joints in shear wall sheathing shall occur over, and be fastened to, common studs. Horizontal joints in shear wall sheathing shall occur over, and be fastened to, 1-1/2-inch-thick blocking. (CRC R602.10.10)
- Framing over openings.** Headers, double joists, or trusses of adequate size to transfer loads to vertical members shall be provided over window and door openings in load-bearing walls and partitions. (CRC 2304.3.2)
- Joists under bearing partitions.** Joists under parallel bearing partitions shall be of adequate size to support the load. Double joists, sized to adequately support the load, that are spaced to permit the installation of piping or vents shall be full-depth solid-blocked with minimum 2-inch nominal lumber spaced at maximum 4 feet on center. Bearing partitions perpendicular to joists shall be offset from supporting girders, walls, or partitions more than 4 inches below the joist depth unless such joists are of sufficient size to carry the additional load. (CRC R502.4)
- Joists above or below shear walls.** Where joists are perpendicular to a shear wall above or below, a rim joint, band joint, or blocking shall be provided along the entire length of the shear wall. Where joists are parallel to a shear wall above or below, a rim joint, end joint, or parallel framing shall be provided along the shear wall above and/or below the shear wall. Where a parallel framing member cannot be located directly above and/or below the shear wall, full-depth blocking at 16-inch spacing shall be provided between the parallel framing members to each 150 lb/ft. (CRC R502.4)
- Floor member bearing.** The ends of each floor joist, beam, or girder shall have minimum 1-1/2 inches of bearing on wood or metal and minimum 3 inches of bearing on masonry or concrete except where supported on a 1-inch-by-4-inch ribbed strip and nailed to the adjoining stud or by the use of approved joist hangers. (CRC R502.6)
- Floor joist lap.** Floor joists spanning opposite sides over a bearing support shall lap minimum 3 inches and shall be nailed together within minimum 3 10d face nails. A wood or metal splice with strength equal to or greater than that provided by the lap is permitted. (CRC R502.6.1)
- Floor joist-to-girder support.** Floor joists framing into the side of a wood girder shall be supported by approved framing anchors or on ledger strips minimum 2 inches by 2 inches. (CRC R502.6.2)
- Floor joist lateral restraint.** Floor joists shall be supported laterally at ends and each intermediate support by minimum 2-inch full-depth blocking, by attachment to full-depth header, band joint, or rim joint, to an adjoining stud, or shall be otherwise provided with lateral support to prevent rotation. (CRC R502.7)
- Band joist bridging.** Floor joists exceeding nominal 2 inches by 12 inches shall be supported laterally by solid blocking, diagonal bridging (wood or metal), or a continuous 1-inch-by-3-inch strip nailed across the bottom of joists perpendicular to joists at maximum 8-foot intervals. (CRC R502.7)
- Framing of floor openings.** Openings in floor framing shall be framed with a header and trimmer joists. When the header joist span does not exceed 4 feet, the header joist may be a single member the same size as the floor joist. Single trimmer joists may be used to carry a single header joist located within 3 feet of the trimmer joist bearing. When the header joist span exceeds 4 feet, the trimmer joists and header joist shall be doubled and of sufficient cross section to support the floor joists framing into the header. Approved hangers shall be used for the header-joist-to-trimmer-joist connections when the header joist span exceeds 6 feet. Tail joists over 12 feet long shall be supported at the header by framing anchors or on ledger strips minimum 2 inches by 2 inches. (CRC R502.10)
- Girders.** Girders for single-story construction or girders supporting loads from a single floor shall be not less than 4 inches by 6 inches for spans 6 feet and less, provided that girders are spaced not more than 8 feet on center. Other girders to support the loads of two or more floors shall be in the CBC. Girder end joints shall occur over supports. When a girder is spliced over a support, an adequate tie shall be provided. The ends of beams or girders supported on masonry or concrete shall not have less than 3 inches of bearing. (CRC 2308.7)
- Ridges, hips, and valleys.** Rafters shall be framed to a ridge board or to each other with a gusset plate as a tie. Ridge boards shall be minimum 1-inch nominal thickness and not less in depth than the cut end of the rafter. At all valleys and hips, there shall be a valley or hip rafter not less than 2-inch nominal thickness and not less in depth than the cut end of the rafter. Hip and valley rafters shall be supported the ridge by a brace to a bearing partition or be designed to carry and distribute the specific load at that point. Where the roof pitch is less than 3:12 slope (25% gradient), structural members that support rafters and ceilings joists, such as ridges, hips, and valleys, shall be designed as beams. (CRC R802.3)
- Celling joist and rafter connections.** Ceiling joists and rafters shall be nailed to each other per CRC Table R802.5.1(9), and the rafter shall be nailed to the wall top plate per CRC Table R802.3(1). Ceiling joists shall be continuous or securely joined per CRC Table R802.5.1(9) where they meet over interior partitions and are nailed to adjacent rafters to provide a continuous tie across the building when such joists are parallel to rafters. Where ceiling joists are not connected to the rafters at the wall top plate, joists connected higher in the attic shall be installed as rafter ties, or rafter ties shall be installed to provide a continuous tie. Where ceiling joists are not parallel to rafters, rafter ties shall be installed. Rafter ties shall be minimum 2 inches by 4 inches nominal, installed per CRC Table R802.5.1(9), or connections of equivalent capacities shall be provided. Where ceiling joists or rafter ties are not provided, the ridge formed by these rafters shall be supported by a wall or engineer designed girder. (CRC R802.3.1)
- Celling joists lapped.** Ends of ceiling joists shall be lapped minimum 3 inches or butted overbearing partitions or beams and toenailed to the bearing element. Where ceiling joists provide resistance to rafter thrust, lapped joists shall be nailed together per CRC Table R602.3(1) and butted joists shall be tied together in a manner to resist such thrust. (CRC R802.3.1)
- Collar ties.** Collar ties or ridge straps to resist wind uplift shall be connected in the upper third of the attic space. Collar ties shall be a minimum 1 inch by 4 inches nominal and spaced at maximum 4 feet on center. (CRC R802.3.1)
- Purins.** Purins installed to reduce the span of rafters shall be sized not less than the required size of the rafters they support. Purins shall be continuous and shall be supported by 2-inch by 4-inch nominal braces installed to bearing walls at a minimum 45-degree slope from horizontal. The braces shall be spaced maximum 4 feet on center with a maximum 8-foot unbraced length. (CRC R802.3.1)
- Roofing member blocking.** The ends of each rafter or ceiling joist shall have not less than 1-1/2 inches of bearing on wood or metal and not less than 3 inches of bearing on masonry or concrete. (CRC R802.6)
- Roofblocking member lateral support.** Roof framing members and ceiling joists with a nominal depth-thickness ratio exceeding 5:1 shall be provided with lateral support at points of bearing to prevent rotation. (CRC R802.8)
- Roofblocking member blocking.** Rafters and ceiling joists with a nominal depth-thickness ratio exceeding 6:1 shall be supported laterally by solid blocking, diagonal bracing (wood or metal), or a continuous 1-inch-by-3-inch wood strip nailed across the rafters or ceiling joists at maximum 8-foot intervals. (CRC R802.8)

E. Wood Framing (Continued)

- Framing of roofceiling openings.** Openings in roof and ceiling framing shall be framed with a header and trimmer joists. When the header joist span does not exceed 4 feet, the header joist may be a single member the same size as the ceiling joist or rafter. Single trimmer joists may be used to carry a single header joist located within 3 feet of the trimmer joist bearing. When the header joist span exceeds 4 feet, the trimmer joists and header joist shall be doubled and of sufficient cross section to support the ceiling joists or rafters framing into the header. Approved hangers shall be used for the header-joist-to-trimmer-joist connections when the header joist span exceeds 6 feet. Tail joists over 12 feet long shall be supported at the header by framing anchors or on ledger strips minimum 2 inches by 2 inches. (CRC R502.10)
- Roof framing above shear walls.** Rafters or roof trusses shall be connected to top plates of shear walls with blocking between the rafters or trusses. (CRC R602.10.8)
- Roof diaphragm under fill framing.** Roof plywood shall be continuous under California fill framing.
- Roof diaphragm at ridges.** Minimum 2-inch nominal blocking required for roof diaphragm nailing at ridges. (CRC R602.10.8)
- Blocking of roof trusses.** Minimum 2-inch nominal blocking required between trusses at ridge lines and at points of bearing at exterior walls.
- Truss clearance.** Minimum 1/2-inch clearance required between top plates of interior non-bearing partitions and bottom chords of trusses.
- Drilling, cutting, and notching of roof/rafter framing.** Notches in solid lumber joists, rafters, blocking, and beams shall not exceed one-sixth the member depth, shall be not longer than one-third the member depth, and shall not be located in the middle one-third of the span. Notches at member ends shall not exceed one-fourth the member depth. The tension side of members 4 inches or greater in nominal thickness shall not be notched except at member ends. Holes shall not be closer than 2 inches to the top or bottom of the member or to any other hole located in the member. Where the member is also notched, the hole shall not be closer than 2 inches to the notched area. (CRC R406.1)
- Exterior landings, decks, balconies, and stairs.** Such elements shall be positively anchored to the primary structure to resist both vertical and lateral forces or shall be designed to be self-supporting. Attachment shall not be accomplished by use of toenails or nails subject to withdrawal. (CRC R311.3)
- Fireblocking.** Fireblocking shall be provided in the following locations (CRC R302.11 and CRC R1003.19):
 - In concealed spaces of stud walls and partitions, including furred spaces, and parallel rows of studs or staggered studs, as follows:
 - Vertically at the ceiling and floor levels
 - Horizontally at intervals not exceeding 10 feet
 - At all intersections between concealed vertical and horizontal spaces such as occur at soffits, drop ceilings, and cove ceilings
 - In concealed spaces between stair stringers at the top and bottom of the run
 - At openings around vents, pipes, ducts, cables and wires at ceiling and floor level, with an approved material to resist the free passage of flame and products of combustion
 - At chimneys and fireplaces per Item E49
 - Coronies of a two-family dwelling at the line of dwelling-unit separation
- Fireblocking materials.** Except as otherwise specified in Items E48 and E49, fireblocking shall consist of the following materials with the integrity maintained (CRC R302.11.1):
 - Two-inch nominal lumber
 - Two thicknesses of one-inch nominal lumber with broken lap joints
 - One thickness of 2/3-inch wood structural panel with joints backed by 2/3-inch wood structural panel
 - One thickness of 3/4-inch particleboard with joints backed by 3/4-inch particleboard
 - 1/2-inch gypsum board
 - 1/4-inch cement-based millboard
 - Batts or blankets of mineral or glass fiber of approved materials installed in such a manner as to be securely retained in place. Batts or blankets of mineral or glass fiber or other approved non-rigid materials shall be permitted for compliance with the 10-foot horizontal fireblocking in walls constructed using parallel rows of studs or staggered studs. Unfaced fiberglass batt insulation used as fireblocking shall fill the entire cross-section of the wall cavity to a minimum height of 16 inches measured vertically. When piping, conduit, or similar obstructions are encountered, the insulation shall be packed tightly around the obstruction. Loose-fill insulation material shall not be used as a fireblock unless specifically tested in the form of fire and fire intended for use to demonstrate its ability to remain in place and to retard the spread of flame and hot gases.
- Fireblocking at openings around vents, pipes, ducts, cables, and wires at ceiling and floor level.** Such openings shall be fireblocked with an approved material to resist the free passage of flame and products of combustion. (CRC R302.11)
- Fireblocking of chimneys and fireplaces.** All spaces between chimneys and floors and ceilings through which chimneys pass shall be fireblocked with noncombustible material in accordance with the manufacturer's instructions. (CRC R302.11.1)
- Fireblocking of chimneys and fireplaces.** All spaces between chimneys and floors and ceilings through which chimneys pass shall be fireblocked with noncombustible material

RETAINING WALL NOTES

GENERAL WALL HEIGHT IS MEASURED FROM TOP OF THE FOOTING TO THE TOP OF THE WALL. THERE SHALL BE NO BUILDING FOUNDATION, DRIVEWAY, OR OTHER LOADING ON THE UPPER LEVEL WITHIN A DISTANCE EQUAL TO THE HEIGHT OF THE WALL UNLESS OTHERWISE NOTED. DESIGN SHALL NOT BE USED FOR CURVED RETAINING WALLS UNLESS NOTED. PROVIDE CONSTRUCTION JOINT FOR EVERY 50' OF WALL. CONTINUOUS INSPECTION REQUIRED; U.N.O.

- CONCRETE MIX:** MIN. COMPRESSIVE STRENGTH = 2500 P.S.I. AT 28 DAYS
BLOCK TYPE: ASTM C90 TYPE I U. N. O.
MORTAR MIX: ASTM C270 TYPE S, 2500 P.S.I. AT 28 DAYS.
GROUT MIX: ASTM C150. MINIMUM COMPRESSIVE STRENGTH = 2500 P.S.I. AT 28 DAYS. ALL CELLS SHALL BE FILLED SOLID WITH GROUT. VIBRATE GROUT WITHIN 10 MINUTES OF POURING TO ENSURE SOLID CONSOLIDATION. BRING GROUT TO A POINT 2" FROM TOP OF MASONRY UNITS WHEN GROUTING OF SECOND LIFT IS TO CONTINUE AT ANOTHER TIME.
MORTAR KEY: PROVIDE MORTAR KEY BETWEEN THE FOOTING AND THE FIRST COARSE OF BLOCK. MORTAR KEY SHALL BE FORMED BY EMBEDDING A FLAT 2X4 FLUSH WITH AND AT THE TOP OF THE FRESHLY POURED FOOTING. IT SHOULD BE REMOVED AFTER THE CONCRETE HAS HARDENED (APPROX. 1 HOUR.) A MORTAR KEY MAY BE OMITTED IF THE FIRST COURSE OF BLOCK IS SET INTO THE FRESH CONCRETE WHEN THE FOOTING IS POURED AND A GOOD BOND IS OBTAINED.
FOOTING: ALL FOOTINGS SHALL EXTEND AT LEAST 12" INTO UNDISTURBED NATURAL SOIL. SOIL SHOULD BE DAMPENED PRIOR TO PLACING CONCRETE IN FOOTINGS. PROVIDE THREE INCHES OF COVER FOR ALL FOOTING STEEL.
STEEL: ASTM "615" GRADE 40 DEFORMED REINFORCING BAR FOR #5 BAR AND UNDER. GRADE 60 DEFORMED REINFORCING BAR FOR #6 AND LARGER UNLESS NOTED OTHERWISE. WHEN ONE CONTINUOUS BAR CANNOT BE USED, A LAP SPLICE OF 40 BAR DIAMETERS FOR GRADE 40 BARS AND 48 BAR DIAMETERS FOR GRADE 60 BARS SHALL BE USED UNLESS OTHERWISE NOTED.
BACK FILL: BACK FILL WITH GRANULAR (SANDY) SOIL FOR A MINIMUM DISTANCE OF ONE FOOT BEHIND WALL. EXPANSIVE OR CLAYEY SOILS SHALL NOT BE USED AS BACK FILL. ALL BACK FILL SOILS ASSOCIATED WITH WALL CONSTRUCTION SHOULD BE COMPACTED TO AT LEAST 90% RELATIVE COMPACTION BASED UPON ASTM: D1557-00. THE WALL SHOULD NOT BE BACK FILLED UNTIL THE GROUT HAS REACHED AN ADEQUATE STRENGTH.
WATER: USE APPROVED WATERPROOFING UNLESS OTHERWISE NOTED. THE DESIGNER
PROOFING: AND ENGINEER DO NO REPRESENT THEMSELVES TO BE EXPERTS IN THE FIELD OF WATERPROOFING. IT SHALL BE THE RESPONSIBILITY OF THE CONTRACTOR TO PROVIDE THE WORKMANSHIP AND MATERIALS NECESSARY TO PROVIDE THE STANDARD OF CARE TO COMPLETE THE WALL IN A WATERTIGHT CONDITION.
SUB DRAIN: PROVIDE 4" MIN. PERFORATED PIPE, SDR35 OR EQUIVALENT, HOLES DOWN, 1% FALL TO OUTLET. PROVIDE SOLID OUTLET PIPE AT SUITABLE LOCATION. TOP OF PIPE SHOULD BE BELOW TOP OF SLAB TO BE ENCASED IN 3/4" CRUSHED ROCK EQUAL TO 2/3 OF WALL HEIGHT AND PROVIDE MIRADRAIN 6000 OR EQUIVALENT. CRUSHED ROCK TO BE SURROUNDED BY FILTER FABRIC (MIRAFI 140N OR EQUIVALENT) WITH 6" MIN. OVERLAP.


FOLLOW ALL RECOMMENDATIONS OF APPLICABLE SOILS REPORT. NOTIFY ENGINEER OF ANY CHANGES IN PLANS OR FIELD CONDITIONS.

FOUNDATION NOTES

- FOUNDATION DESIGN IS BASED ON 2500 P.S.F. PER CONSTRUCTION TESTING & ENGINEERING, INC.(CTE) PER JOB # 4830.2200109
- IF THE BUILDING INSPECTOR SUSPECTS FILL, EXPANSIVE SOILS OR ANY GEOLOGIC INSTABILITY BASED UPON OBSERVATION OF THE FOUNDATION EXCAVATION, A SOILS OR GEOLOGICAL REPORT, AND SUBMITTAL OF PLANS TO PLAN CHECK TO VERIFY THAT THE REPORT RECOMMENDATIONS HAVE BEEN INCORPORATED, MAY BE REQUIRED.
- TYPICAL FOOTING TO BE 12" X 12" @ 1 STORY; 15" X 18" @ 2 STORY CONDITIONS INTO FIRM NATIVE SOIL UNLESS OTHERWISE SPECIFIED BY SOILS REPORT OR ON FOUNDATION DETAILS.
- HORIZONTAL DISTANCE FROM EDGE OF FOOTING TO DAYLIGHT SHALL BE 11'-0" MINIMUM TO EXISTING GRADE OR AS RECOMMENDED BY SOILS REPORT.
- NO PLUMBING PIPES OVER 1 1/2" DIAMETER IN 2X4 SHEAR WALLS AND 3" DIAMETER IN 2X6 SHEAR WALLS.
- ALL HOLD-DOWNS ON 2X2 STUDS WITH 2-16D @ 6" O.C. OR 4X POST U.N.O.
- ALL HOLD-DOWN ANCHORS MUST BE TIED IN PLACE PRIOR TO FOUNDATION INSPECTION.
- HOLD-DOWN ANCHOR BOLTS SHALL BE RETIGHTENED JUST PRIOR TO COVERING THE WALL FRAMING.
- CONCRETE TO REACH 2500 P. S. I. AT 28 DAYS.
- ALL CONCRETE BUILDING SLABS SHALL BE A MIN. 4" THICK WITH #3 REBARS AT 18" O.C. MAX. E.W. @ MIDDLE THIRD OF SLAB, TURNDOWN INTO FOOTING WITH 4" MIN. SAND FILL AND 10 MIL. VISQUEEN IN BETWEEN U.N.O..
- PROVIDE 1" DEEP SAW CUT X 1/8" THK. @ 10'-0" MAX O.C. EACH WAY FOR THE ALL INTERIOR SLABS. CUT AS SOON AS THE SLAB WILL SUPPORT THE WEIGHT OF THE SAW AND OPERATE WITHOUT DISTURBING THE FINAL FINISH FOR ALL NEW SLABS OVER 1000 SQ. FT. PER ACI OR AS DESCRIBED BY SOILS REPORT.
- THE CONCRETE SLAB IS TO BE POURED MONOLITHICALLY UNO.
- WOOD TO BE MIN. 8" ABOVE ADJACENT NATURAL OR FINISHED GRADE & 2" ABOVE CONCRETE SLAB.
- FOUNDATION PLATES OR SILLS SHALL BE BOLTED OR ANCHORED TO THE FOUNDATION WITH 5/8" X 10" LONG ON 2X SILL AND 12" LONG ON 3X SILL. EMBEDDED @ LEAST 7" INTO CONCRETE WITH ONE BOLT LOCATED WITHIN 12" OF EACH END OF EACH PIECE AT 6'-0" O.C. MAX. OR LESS. PER SHEAR TRANSFER SCHEDULE. THERE SHALL BE A MINIMUM OF TWO BOLTS OR ANCHOR STRAPS PER PIECE WITH ONE BOLT OR ANCHOR BOLT OR ANCHOR STRAP LOCATED NOT MORE THAN 12" OR LESS THAN 4" FROM EACH END OF EACH PIECE. A PROPERLY SIZED NUT AND WASHER SHALL BE TIGHTENED ON EACH BOLT TO PLATE.
- FASTENERS IN CONTACT WITH PRESERVATIVE-TREATED WOOD SHALL BE OF HOT DIPPED ZINC-COATED GALVANIZED STEEL, STAINLESS STEEL, SILICON BRONZE OR COPPER. FASTENERS OTHER THAN NAILS, TIMBER RIVETS, WOOD SCREWS AND LAG SCREWS SHALL BE PERMITTED TO BE OF MECHANICALLY DEPOSITED ZINC-COATED STEEL WITH COATING WEIGHTS IN ACCORDANCE WITH ASTM B 695, CLASS 55 MINIMUM. CONNECTORS THAT ARE USED IN EXTERIOR APPLICATIONS AND IN CONTACT WITH PRESERVATIVE-TREATED WOOD SHALL HAVE COATING TYPES AND WEIGHTS IN ACCORDANCE WITH TREATED WOOD OR CONNECTOR MANUFACTURER'S RECOMMENDATIONS. IN THE ABSENCE OF MANUFACTURER'S RECOMMENDATIONS, A MINIMUM OF ASTM A 653, TYPE G185 ZINC-COATED GALVANIZED STEEL, OR EQUIVALENT, SHALL BE USED. EXCEPTION: PLAIN CARBON STEEL FASTENERS IN SBX/DOT AND ZINC BORATE PRESERVATIVE-TREATED WOOD IN AN INTERIOR, DRY ENVIRONMENT SHALL BE PERMITTED. CBC 2304.10.5.1, CRC R317.3.1
- FIELD-CUT ENDS, NOTCHES AND DRILLED HOLES OF PRESERVATIVE-TREATED WOOD SHALL BE TREATED IN THE FIELD IN ACCORDANCE WITH AWPA M4, CRC: R317.1.1
- PROVIDE A MINIMUM OF 2 ANCHOR BOLTS PER SHEAR PANEL.
- FOR INTERIOR SLAB, NON-BEARING WALLS, USE RAMSET POWDER DRIVEN PIN @ 24" O.C. PER ESR 2690
- PLATE WASHERS, A MINIMUM OF 3" X 3" X .225" IN SIZE, SHALL BE PROVIDED BETWEEN THE FOUNDATION SILL PLATE AND THE NUT EXCEPT WHERE APPROVED ANCHOR STRAPS ARE USED. THE HOLE IN THE PLATE WASHER IS PERMITTED TO BE DIAGONALLY SLOTTED WITH A WIDTH OF UP TO 3/16" LARGER THAN THE BOLT DIAMETER AND SLOT LENGTH NOT TO EXCEED 1 3/4", PROVIDED A STANDARD CUT WASHER IS PLACED BETWEEN THE PLATE WASHER AND THE NUT.
- IF A SHEAR WALL OCCURS ON BOTH SIDES OF A FOOTING THEN THE ANCHOR BOLT SPACING IS TO BE REDUCED BY 1/2.
- INTERIOR BEARING WALL SOLE PLATES SHALL HAVE ANCHOR BOLTS SPACED AT NOT MORE THAN 6 FT. ON CENTER AND LOCATED WITHIN 12" OF THE ENDS OF EACH PLATE SECTION WHEN SUPPORTED ON A CONTINUOUS FOUNDATION. R403.1.6.1
- THE MAXIMUM ANCHOR BOLT SPACING SHALL BE 4FT. FOR BUILDINGS OVER TWO STORIES IN HEIGHT. CRC R403.1.6.1.4
- PROVIDE SOLID 4X POST OR DBL 2X POST WITH SOLID BLOCK UNDER ALL POST ABOVE.
- VERIFY TYP. EXISTING POST-TENSION SLAB PRIOR TO CONSTRUCTION.


Footing Depth and location within native soil is to be verified by a geotechnical engineer. Report of verification is to be provided to the building inspector at footing inspection.

City of Oceanside Building Division
Reviewed for code compliance with the California Building Standards Codes and applicable City of Oceanside Codes and Ordinances
L.Bolton 07/17/2025 1:31:55 PM

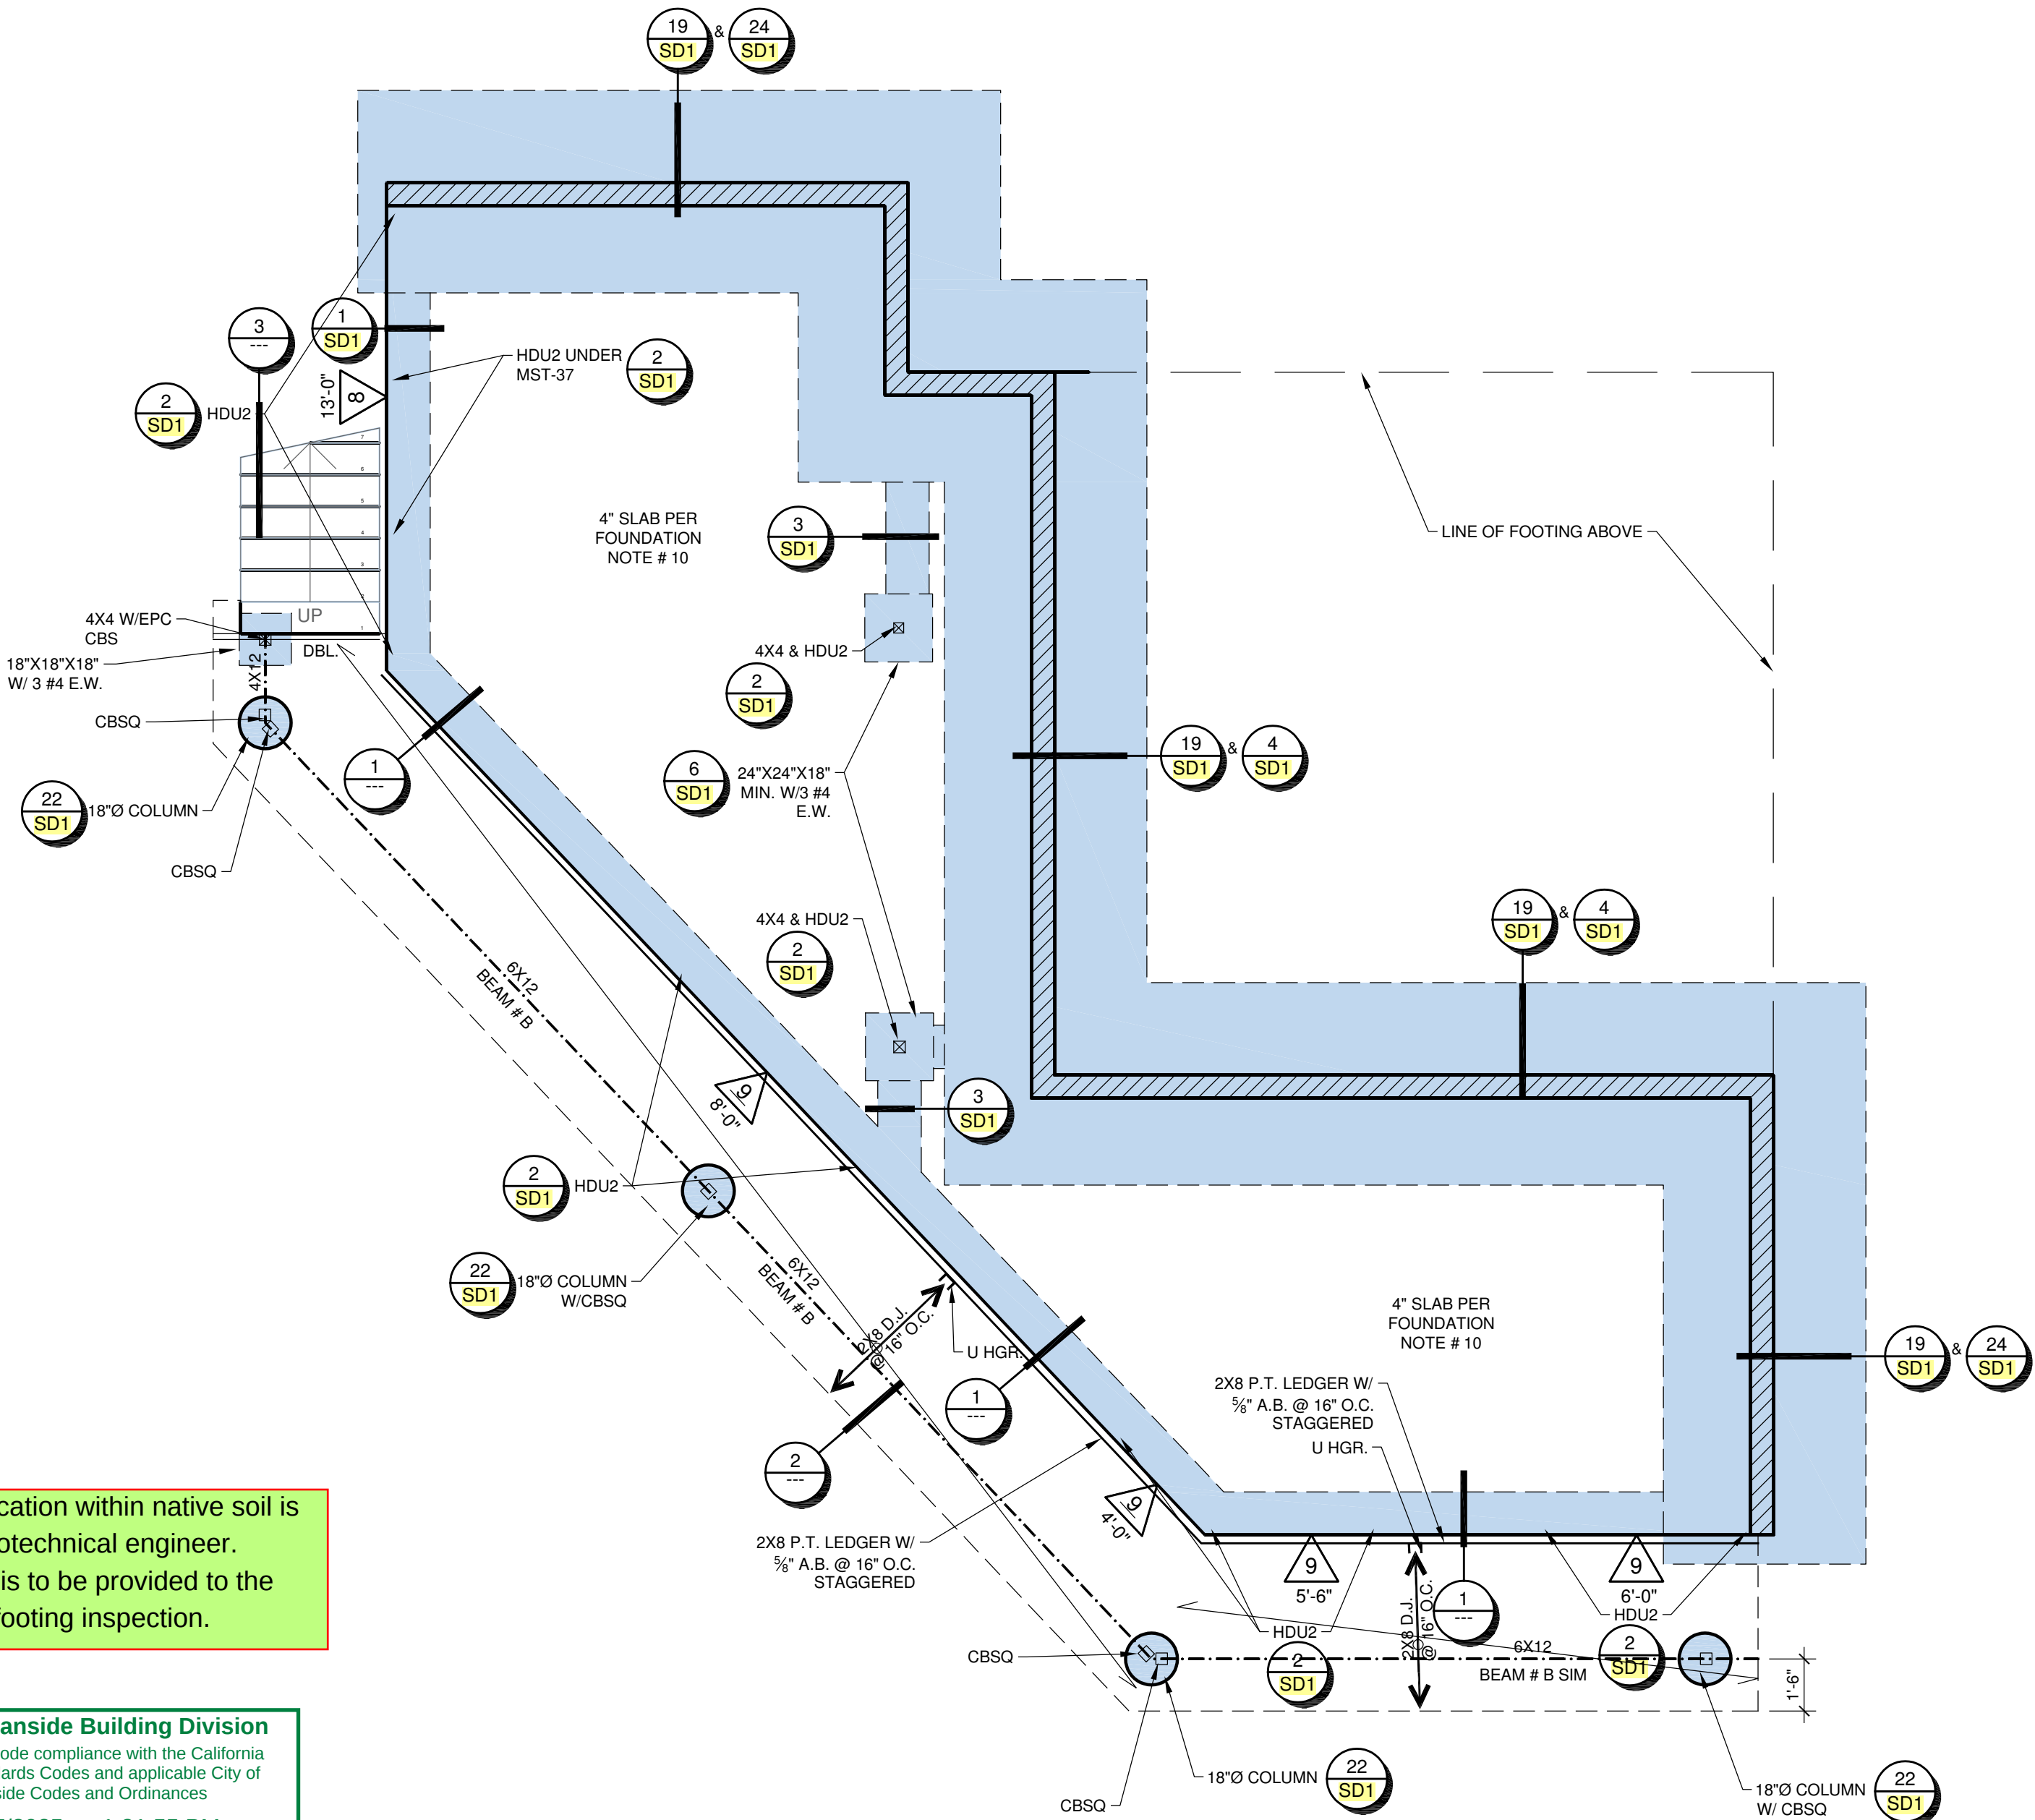


FOUNDATION PLAN


SCALE 1/4" = 1'

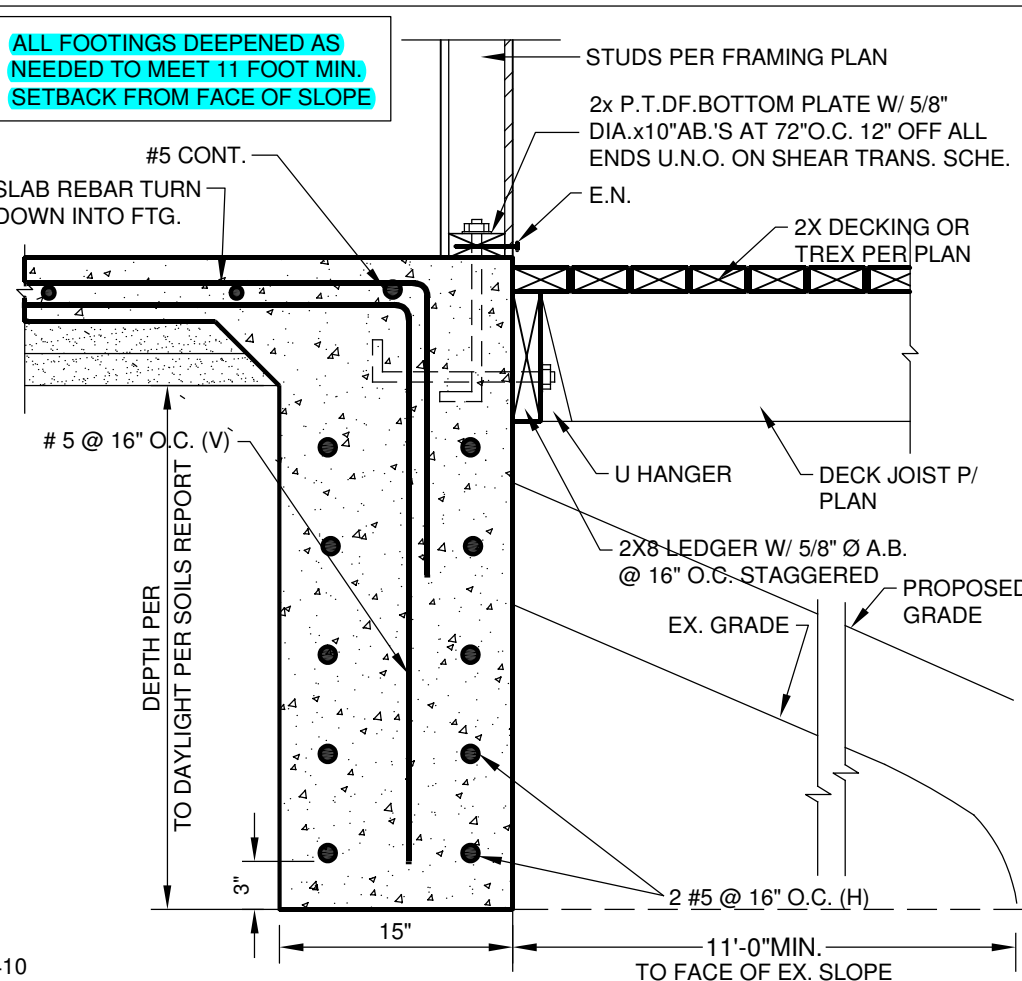

1 INTERIOR FOOTING

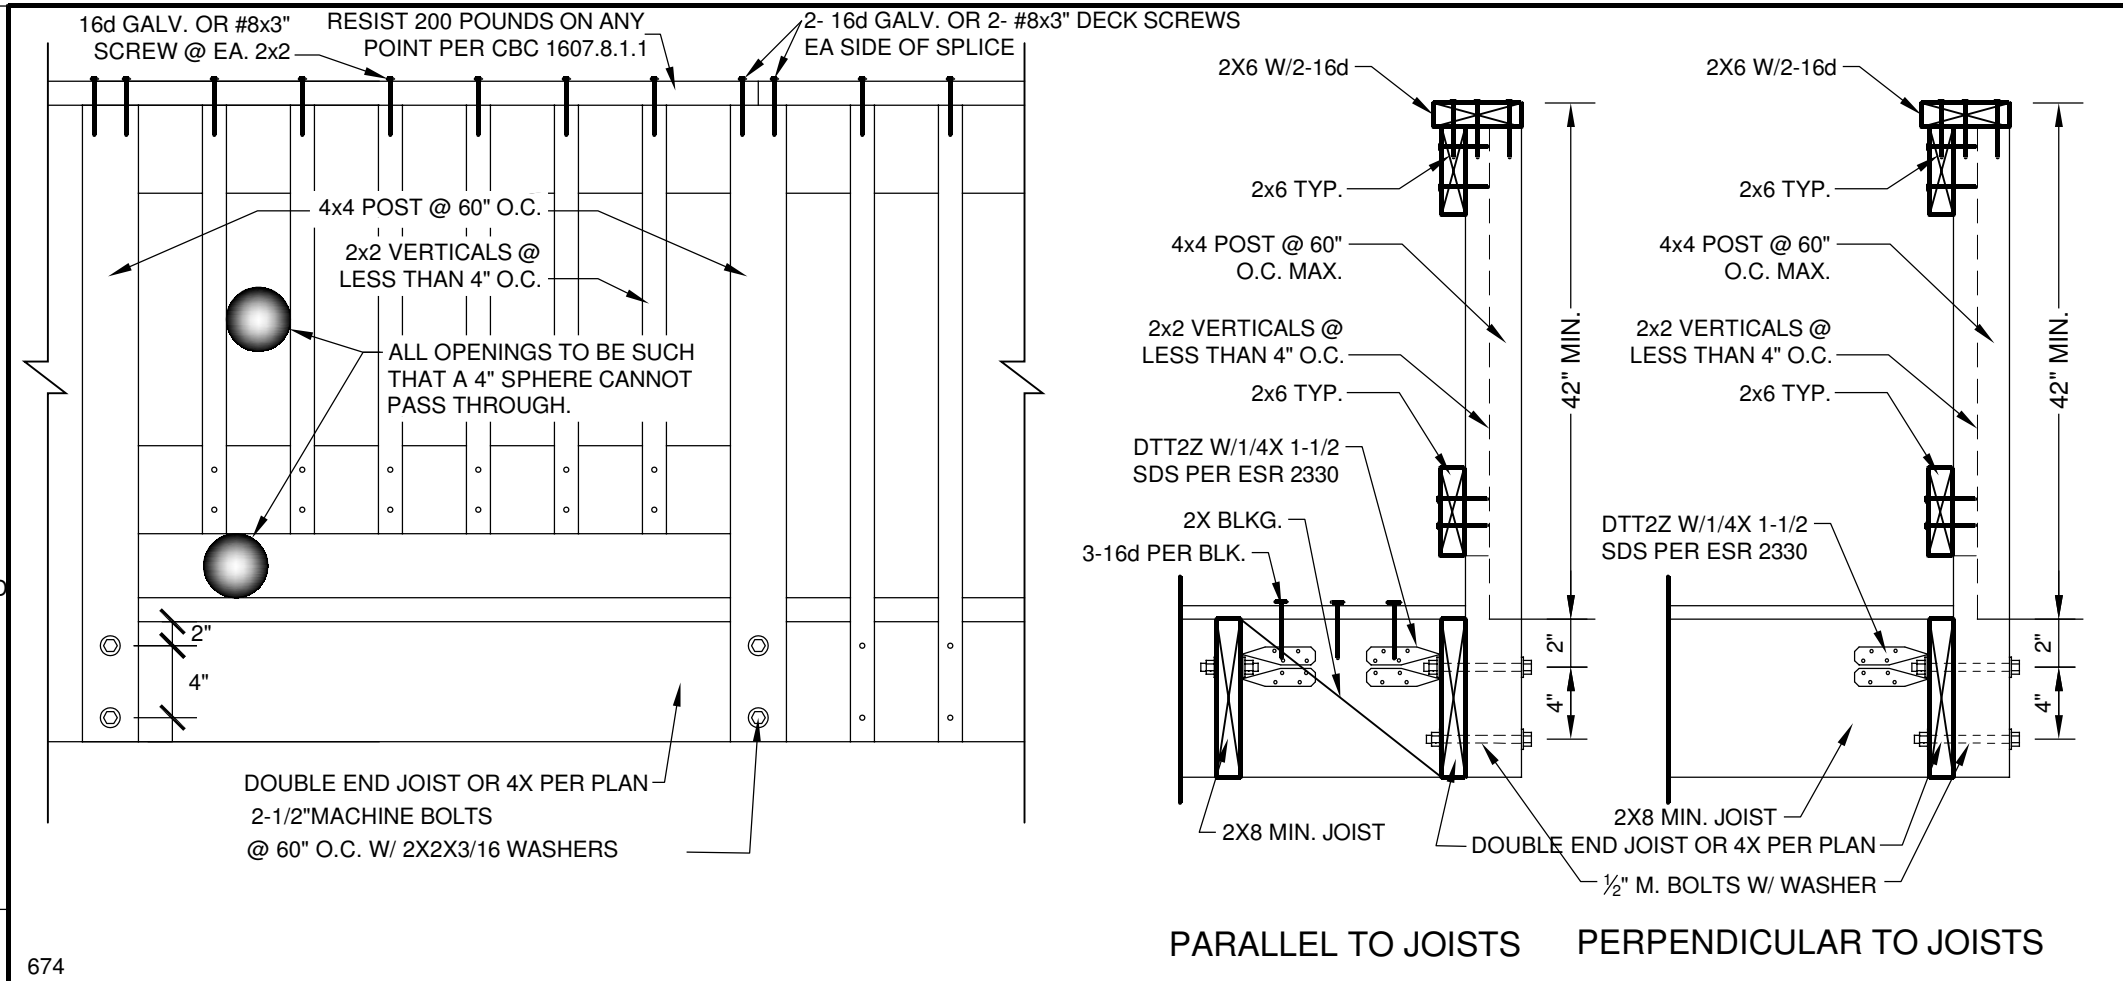

2 GUARDRAIL

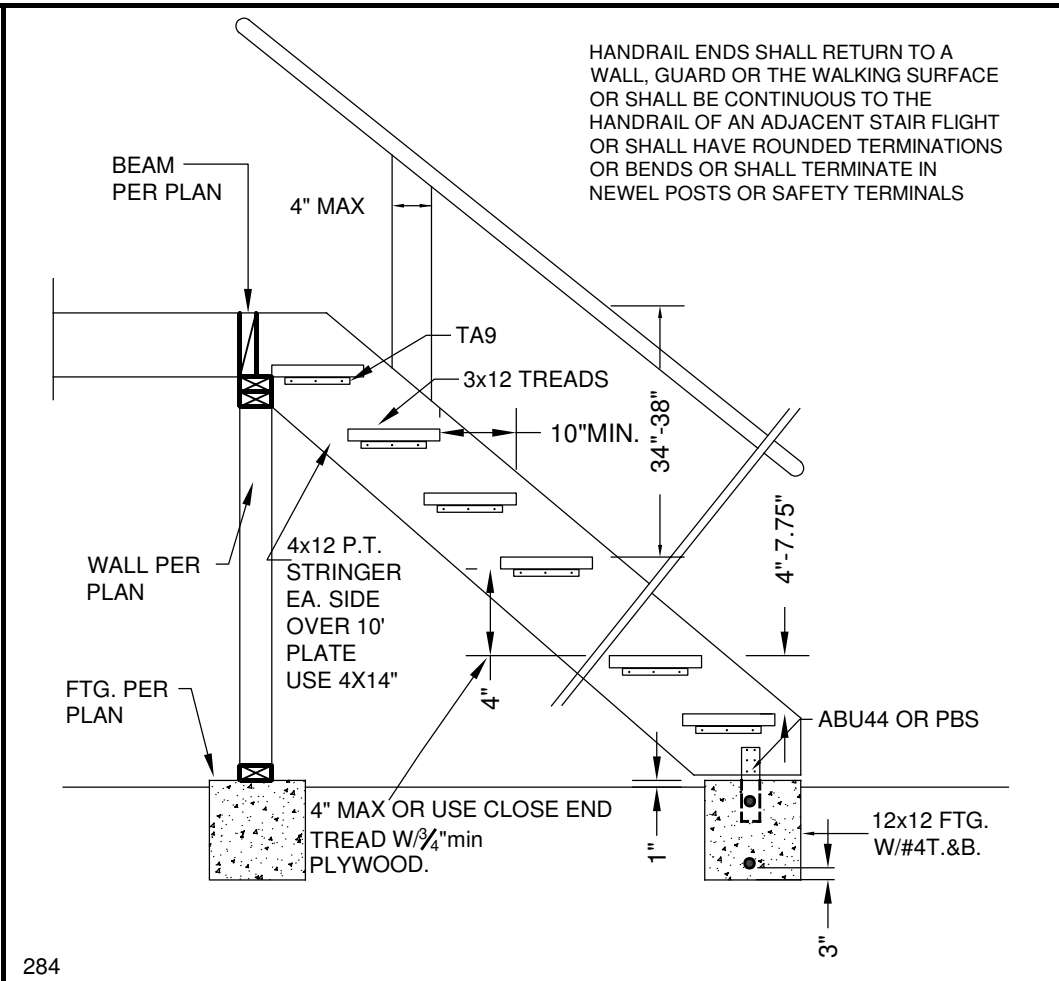

3 DECK STAIRS

FOUNDATION LEGEND

- RAISE CONCRETE FOUNDATION
- SLAB ON GRADE FOUNDATION
- SHEAR PANEL DESIGNATION
- SHEAR PANEL LENGTH
- STRONG WALL FOOTING
- NEW MASONRY FOOTING & WALL



Geotechnical information only



June 27, 2025

REVISIONS

DATE

NDC

NADER'S DESIGN CONSULTING, INC.

SHORELINE ST., OCEANSIDE, CA. 92068

PHONE: (619) 241-1848, FAX: (619) 241-1857, email: design_eng@nadc.com

PROJECT TYPE

2 STORY DWELLING W/ ATTACHED GARAGE

OWNER

JESSICA BRANDT

ADDRESS

SHORELINE ST., OCEANSIDE, CA. 92068

CONTRACTOR

FOUNDATION PLAN

SHEET TITLE

CONTRACT DATE

4/5/2023

DATE

6/27/2025

DRAWN

MARIA G.

SHEET

S1

NO PART OF THESE PLANS AND ANY WRITTEN MATERIALS APPEARING HEREIN, MAY BE COPY, REPRINTED, ALTERED OR RE-USED WITHOUT CONSENT OF NADER'S DESIGN CONSULTING, INC. DRAWINGS AND SPECIFICATIONS ARE INSTRUMENTS OF SERVICE AND SHALL REMAIN THE PROPERTY OF NADER'S DESIGN CONSULTING, INC. USE IS RESTRICTED TO THE WORK FOR WHICH THEY ARE PREPARED.

FOUNDATION NOTES

- FOUNDATION DESIGN IS BASED ON 2500 P.S.F. PER CONSTRUCTION TESTING & ENGINEERING, INC.(CTE) PER JOB # 4830.2200109
- IF THE BUILDING INSPECTOR SUSPECTS FILL, EXPANSIVE SOILS OR ANY GEOLOGIC INSTABILITY BASED UPON OBSERVATION OF THE FOUNDATION EXCAVATION, A SOILS OR GEOLOGICAL REPORT, AND SUBMITTAL OF PLANS TO PLAN CHECK TO VERIFY THAT THE REPORT RECOMMENDATIONS HAVE BEEN INCORPORATED, MAY BE REQUIRED.
- TYPICAL FOOTING TO BE 12" X 12" @ 1 STORY; 15" X 18" @ 2 STORY CONDITIONS INTO FIRM NATIVE SOIL UNLESS OTHERWISE SPECIFIED BY SOILS REPORT OR ON FOUNDATION DETAILS.
- HORIZONTAL DISTANCE FROM EDGE OF FOOTING TO DAYLIGHT SHALL BE 7'-0" MINIMUM OR AS RECOMMENDED BY SOILS REPORT.
- NO PLUMBING PIPES OVER 1 1/2" DIAMETER IN 2X4 SHEAR WALLS AND 3" DIAMETER IN 2X6 SHEAR WALLS.
- ALL HOLDOWNS ON 2-2X STUDS WITH 2-16D @ 6" O.C. OR 4X POST U.N.O.
- ALL HOLDOWN ANCHORS MUST BE TIED IN PLACE PRIOR TO FOUNDATION INSPECTION.
- HOLDOWN ANCHOR BOLTS SHALL BE RETIGHTENED JUST PRIOR TO COVERING THE WALL FRAMING.
- CONCRETE TO REACH 2500 P. S. I. AT 28 DAYS.
- ALL CONCRETE BUILDING SLABS SHALL BE A MIN. 4" THICK WITH #3 REBARS AT 18" O.C. MAX. E.W. @ MIDDLE THIRD OF SLAB, TURNDOWN INTO FOOTING WITH 4" MIN. SAND FILL AND 10 MIL. VISQUEEN IN BETWEEN U.N.O.
- PROVIDE 1"DEEP SAW CUT X 1/8" THK. @ 10'-0" MAX O.C. EACH WAY FOR THE ALL INTERIOR SLABS. CUT AS SOON AS THE SLAB WILL SUPPORT THE WEIGHT OF THE SAW AND OPERATE WITHOUT DISTURBING THE FINAL FINISH FOR ALL NEW SLABS OVER 1000 SQ. FT. PER ACI OR AS DESCRIBED BY SOILS REPORT.
- THE CONCRETE SLAB IS TO BE POURED MONOLITHICALLY UNO.
- WOOD TO BE MIN. 8" ABOVE ADJACENT NATURAL OR FINISHED GRADE & 2" ABOVE CONCRETE SLAB.
- FOUNDATION PLATES OR SILLS SHALL BE BOLTED OR ANCHORED TO THE FOUNDATION WITH 5/8" X 10" LONG ON 2X SILL AND 12" LONG ON 3X SILL EMBEDDED @ LEAST 7" INTO CONCRETE WITH ONE BOLT LOCATED WITHIN 12" OF EACH END OF EACH PIECE AT 6'-0" O.C. MAX. OR LESS, PER SHEAR TRANSFER SCHEDULE. THERE SHALL BE A MINIMUM OF TWO BOLTS OR ANCHOR STRAPS PER PIECE WITH ONE BOLT OR ANCHOR STRAP LOCATED NOT MORE THAN 12" OR LESS THAN 4" FROM EACH END OF EACH PIECE. A PROPERLY SIZED NUT AND WASHER SHALL BE TIGHTENED ON EACH BOLT TO PLATE.
- FASTENERS IN CONTACT WITH PRESERVATIVE-TREATED WOOD SHALL BE OF HOT DIPPED ZINC-COATED GALVANIZED STEEL, STAINLESS STEEL, SILICON BRONZE OR COPPER. FASTENERS OTHER THAN NAILS, TIMBER RIVETS, WOOD SCREWS AND LAG SCREWS SHALL BE PERMITTED TO BE OF MECHANICALLY DEPOSITED ZINC-COATED STEEL WITH COATING WEIGHTS IN ACCORDANCE WITH ASTM B 695, CLASS 55 MINIMUM. CONNECTORS THAT ARE USED IN EXTERIOR APPLICATIONS AND IN CONTACT WITH PRESERVATIVE-TREATED WOOD SHALL HAVE COATING TYPES AND WEIGHTS IN ACCORDANCE WITH TREATED WOOD OR CONNECTOR MANUFACTURER'S RECOMMENDATIONS. IN THE ABSENCE OF MANUFACTURER'S RECOMMENDATIONS, A MINIMUM OF ASTM A 653, TYPE G185 ZINC-COATED GALVANIZED STEEL, OR EQUIVALENT, SHALL BE USED. EXCEPTION: PLAIN CARBON STEEL FASTENERS IN SBX/DOT AND ZINC BORATE PRESERVATIVE-TREATED WOOD IN AN INTERIOR, DRY ENVIRONMENT SHALL BE PERMITTED. CBC 2304.10.5.1, CRC R317.3.1
- FIELD-CUT ENDS, NOTCHES AND DRILLED HOLES OF PRESERVATIVE-TREATED WOOD SHALL BE TREATED IN THE FIELD IN ACCORDANCE WITH AWWA M4. CRC. R317.1.1
- PROVIDE A MINIMUM OF 2 ANCHOR BOLTS PER SHEAR PANEL.
- FOR INTERIOR SLAB, NON-BEARING WALLS, USE RIMSET POWDER DRIVEN PIN @ 24" O.C. PER ESR 2690
- PLATE WASHERS, A MINIMUM OF 3" X 9" X .225" IN SIZE, SHALL BE PROVIDED BETWEEN THE FOUNDATION SILL PLATE AND THE NUT EXCEPT WHERE APPROVED ANCHOR STRAPS ARE USED. THE HOLE IN THE PLATE WASHER IS PERMITTED TO BE DIAGONALLY SLOTTED WITH A WIDTH OF UP TO 3/16" LARGER THAN THE BOLT DIAMETER AND SLOT LENGTH NOT TO EXCEED 1 1/2", PROVIDED A STANDARD CUT WASHER IS PLACED BETWEEN THE PLATE WASHER AND THE NUT.
- IF A SHEAR WALL OCCURS ON BOTH SIDES OF A FOOTING THEN THE ANCHOR BOLT SPACING IS TO BE REDUCED BY 1/2.
- INTERIOR BEARING WALL SOLE PLATES SHALL HAVE ANCHOR BOLTS SPACED AT NOT MORE THAN 6 FT. ON CENTER AND LOCATED WITHIN 12" OF THE ENDS OF EACH PLATE SECTION WHEN SUPPORTED ON A CONTINUOUS FOUNDATION. R403.1.6.1
- THE MAXIMUM ANCHOR BOLT SPACING SHALL BE 4FT. FOR BUILDINGS OVER TWO STORIES IN HEIGHT. CRC R403.1.6.1.4
- PROVIDE SOLID 4X POST OR DBL 2X POST WITH SOLID BLOCK UNDER ALL POST ABOVE.
- VERIFY TYP. EXISTING POST-TENSION SLAB PRIOR TO CONSTRUCTION.

FLOOR FRAMING NOTES


- FLOOR DIAPHRAGM TO BE 5/8" A.P.A. RATED SHEATHING STURD-I-FLOOR 32/16 T & G NAIL 10D COMMON AT 6" O.C. EDGE NAILING AND BOUNDARY NAILING, 10" O.C. FIELD NAILING (USE COMMON WIRE NAILS)
- FLOOR HEADERS:
 - L ≤ 5' 4 X 6 OR: 6 X 6 U.N.O.
 - L ≤ 6' 4 X 8 OR: 6 X 8 U.N.O.
 - L ≤ 8' 4 X 10 OR: 6 X 10 U.N.O.
- ALL HOLDOWNS ON 2-2X STUDS WITH 2-16D @ 6" O.C. OR 4X POST U.N.O.
- ALL STRAPS, COLUMN CAPS, HANGERS, CLIPS, ETC. TO BE PRODUCED BY "SIMPSON STRONG TIE," OR EQUAL.
 - a) ALL SPECIFIED FASTENERS MUST BE INSTALLED ACCORDING TO THE INSTRUCTIONS IN THEIR CATALOG. INCORRECT FASTENER QUANTITY, SIZE, TYPE, MATERIAL, OR FINISH MAY CAUSE THE CONNECTION TO FAIL. 16D FASTENERS ARE COMMON NAILS (8 GA X 3 1/2") AND CANNOT BE REPLACED WITH 16D SINKERS (9 GA X 3 1/4") UNLESS OTHERWISE SPECIFIED.
 - b) BOLT HOLES SHALL BE A MINIMUM OF 1/32" AND A MAXIMUM OF 1/16" LARGER THAN THE BOLT DIAMETER.
 - c) UNLESS OTHERWISE NOTED, BOLTS AND NAILS CANNOT BE COMBINED. 8D, 10D, AND 16D SPECIFY COMMON NAILS.
 - d) FILL ALL FASTENER HOLES WITH FASTENER TYPES SPECIFIED, WITH TABLES FOR HIGHEST CAPACITY.
- MAXIMUM ALLOWABLE STUD HEIGHTS: (U.N.O.) BEARING WALL: 2X4 AND 2X6 MAXIMUM 10 FT NONBEARING WALL: 2X4 MAXIMUM 14 FT.; 2X6 MAXIMUM 20 FT.
- PLASTER APPLIED OVER WOOD BASED SHEATHING SHALL INCLUDE TWO LAYERS OF GRADE D PAPER.
- ALL TJ'S TO BE MANUFACTURED BY "WEYERHAEUSER COMPANY," PER ESR 1153, ESR 1387. FOR MORE DETAIL SEE SPEC SHEET. OR "BOISENGINEERD WOOD PRODUCTS" PER ESR-1336, 1040. FOR MORE DETAIL SEE SPEC. SHEET.
- PROVIDE FIRESTOPS, VERTICAL AND HORIZONTAL, IN ENCLOSED SPACES AT 10'-0" INTERVALS MAXIMUM.
- DO NOT CUT, NOTCH, BORE, SHAVE, TAPER OR FOR ANY REASON MODIFY PRE-ENGINEERED / MANUFACTURED STRUCTURAL ELEMENTS SUCH AS GLUED LAMINATED MEMBERS, PARALLAMS, MICROLAMBS, I-JOISTS, LIGHT GAUGE METAL MEMBERS AND OTHER SIMILAR TIMBER OR STEEL PRODUCTS UNLESS SUCH MODIFICATIONS ARE WITHIN THE WRITTEN PARAMETERS SET FORTH BY THE MANUFACTURER OF THAT PRODUCT OR A LETTER OF CERTIFICATION FROM THE MANUFACTURER'S ENGINEER WITH DETAIL SIGNED AND STAMPED IS ISSUED AND AUTHORIZED BY THE PROJECT ENGINEER OF RECORD AND APPROVED BY THE BUILDING OFFICIAL.
- DO NOT USE TJI AS BLOCKING AND RIM JOIST, USE 1 3/4" TIMBER STRAND LSL OR EQUAL.

BASEMENT FRAMING PLAN

SCALE 1/4" = 1'

FOUNDATION LEGEND

- | | |
|----------------------------|-------|
| RAISE CONCRETE FOUNDATION | |
| SLAB ON GRADE FOUNDATION | |
| SHEAR PANEL DESIGNATION | |
| SHEAR PANEL LENGTH | 4'-0" |
| STRONG WALL FOOTING | |
| NEW MASONRY FOOTING & WALL | |

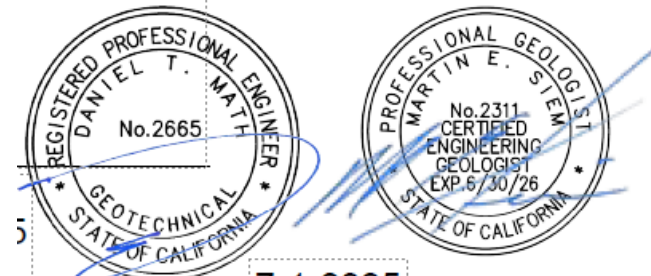

Geotechnical information only



March 4, 2024

REVISIONS	DATE

NDC
NADER'S DESIGN CONSULTING, INC.

CONTRACTOR

JESSICA BRANDT
SHOSHONE ST., OCEANSIDE, CA. 92058
ADDRESS

PROJECT TYPE

2 STORY DWELLING W/ ATTACHED GARAGE

OWNER

SHEET TITLE

BASEMENT FRAMING PLAN

CONTRACT DATE

4/5/2023

DATE

4/5/2023

DRAWN

MARIA G.

SHEET

S2


NO PART OF THESE PLANS AND ANY WRITTEN MATERIALS APPEARING HEREIN MAY BE COPY, REPRINTED, ALTERED OR RE-USED WITHOUT CONSENT OF NADER'S DESIGN CONSULTING, INC. DRAWINGS AND SPECIFICATIONS ARE INSTRUMENTS OF SERVICE AND SHALL REMAIN THE PROPERTY OF NADER'S DESIGN CONSULTING, INC. USE IS RESTRICTED TO THE WORK FOR WHICH THEY ARE PREPARED.

COPYRIGHT © 2018 BY NDC

FLOOR FRAMING NOTES

- FLOOR DIAPHRAGM TO BE 5/8" A.P.A. RATED SHEATHING STURD-I-FLOOR 32/16 T & G NAIL 10D COMMON AT 6" O.C. EDGE NAILING AND BOUNDARY NAILING, 10" O.C. FIELD NAILING (USE COMMON WIRE NAILS)
- FLOOR HEADERS:
L ≤ 5' 4 X 6 OR: 6 X 6 U.N.O.
L ≤ 6' 4 X 8 OR: 6 X 8 U.N.O.
L ≤ 8' 4 X 10 OR: 6 X 10 U.N.O.
- ALL HOLDDOWNS ON 2-2X STUDS WITH 2-16D @ 6" O.C. OR 4X POST U.N.O.
- ALL STRAPS, COLUMN CAPS, HANGERS, CLIPS, ETC. TO BE PRODUCED BY "SIMPSON STRONG TIE," OR EQUAL.
a) ALL SPECIFIED FASTENERS MUST BE INSTALLED ACCORDING TO THE INSTRUCTIONS IN THEIR CATALOG. INCORRECT FASTENER QUANTITY, SIZE, TYPE, MATERIAL, OR FINISH MAY CAUSE THE CONNECTION TO FAIL. 16D FASTENERS ARE COMMON NAILS (6 GA X 3 1/2") AND CANNOT BE REPLACED WITH 16D SINKERS (9 GA X 3 1/4") UNLESS OTHERWISE SPECIFIED.
b) BOLT HOLES SHALL BE A MINIMUM OF 1/32" AND A MAXIMUM OF 1/16" LARGER THAN THE BOLT DIAMETER.
c) UNLESS OTHERWISE NOTED, BOLTS AND NAILS CANNOT BE COMBINED. 8D, 10D, AND 16D SPECIFY COMMON NAILS.
d) FILL ALL FASTENER HOLES WITH FASTENER TYPES SPECIFIED, WITH TABLES FOR HIGHEST CAPACITY.
- MAXIMUM ALLOWABLE STUD HEIGHTS: (U.N.O.) BEARING WALL: 2X4 AND 2X6 MAXIMUM 10 FT NONBEARING WALL: 2X4 MAXIMUM 14 FT.; 2X6 MAXIMUM 20 FT.
- PLASTER APPLIED OVER WOOD BASED SHEATHING SHALL INCLUDE TWO LAYERS OF GRADE D PAPER.
- ALL TJ'S TO BE MANUFACTURED BY "WEYERHAEUSER COMPANY," PER ESR 1153, ESR 1387. FOR MORE DETAIL SEE SPEC SHEET. OR "BOISEENGINEERD WOOD PRODUCTS" PER ESR-1336, 1040. FOR MORE DETAIL SEE SPEC. SHEET.
- PROVIDE FIRESTOPS, VERTICAL AND HORIZONTAL IN ENCLOSED SPACES AT 10'-0" INTERVALS MAXIMUM.
- DO NOT CUT, NOTCH, BORE, SHAVE, TAPER OR FOR ANY REASON MODIFY PRE-ENGINEERED / MANUFACTURED STRUCTURAL ELEMENTS SUCH AS GLUED LAMINATED MEMBERS, PARALLAMS, MICROLLAMS, I-JOISTS, LIGHT GAUGE METAL MEMBERS AND OTHER SIMILAR TIMBER OR STEEL PRODUCTS UNLESS SUCH MODIFICATIONS ARE WITHIN THE WRITTEN PARAMETERS SET FORTH BY THE MANUFACTURER OF THAT PRODUCT OR A LETTER OF CERTIFICATION FROM THE MANUFACTURER'S ENGINEER WITH DETAIL SIGNED AND STAMPED IS ISSUED AND AUTHORIZED BY THE PROJECT ENGINEER OF RECORD AND APPROVED BY THE BUILDING OFFICIAL.
- DO NOT USE TJ AS BLOCKING AND RIM JOIST, USE 1 3/4" TIMBER STRAND LSL OR EQUAL.

TJ: 22

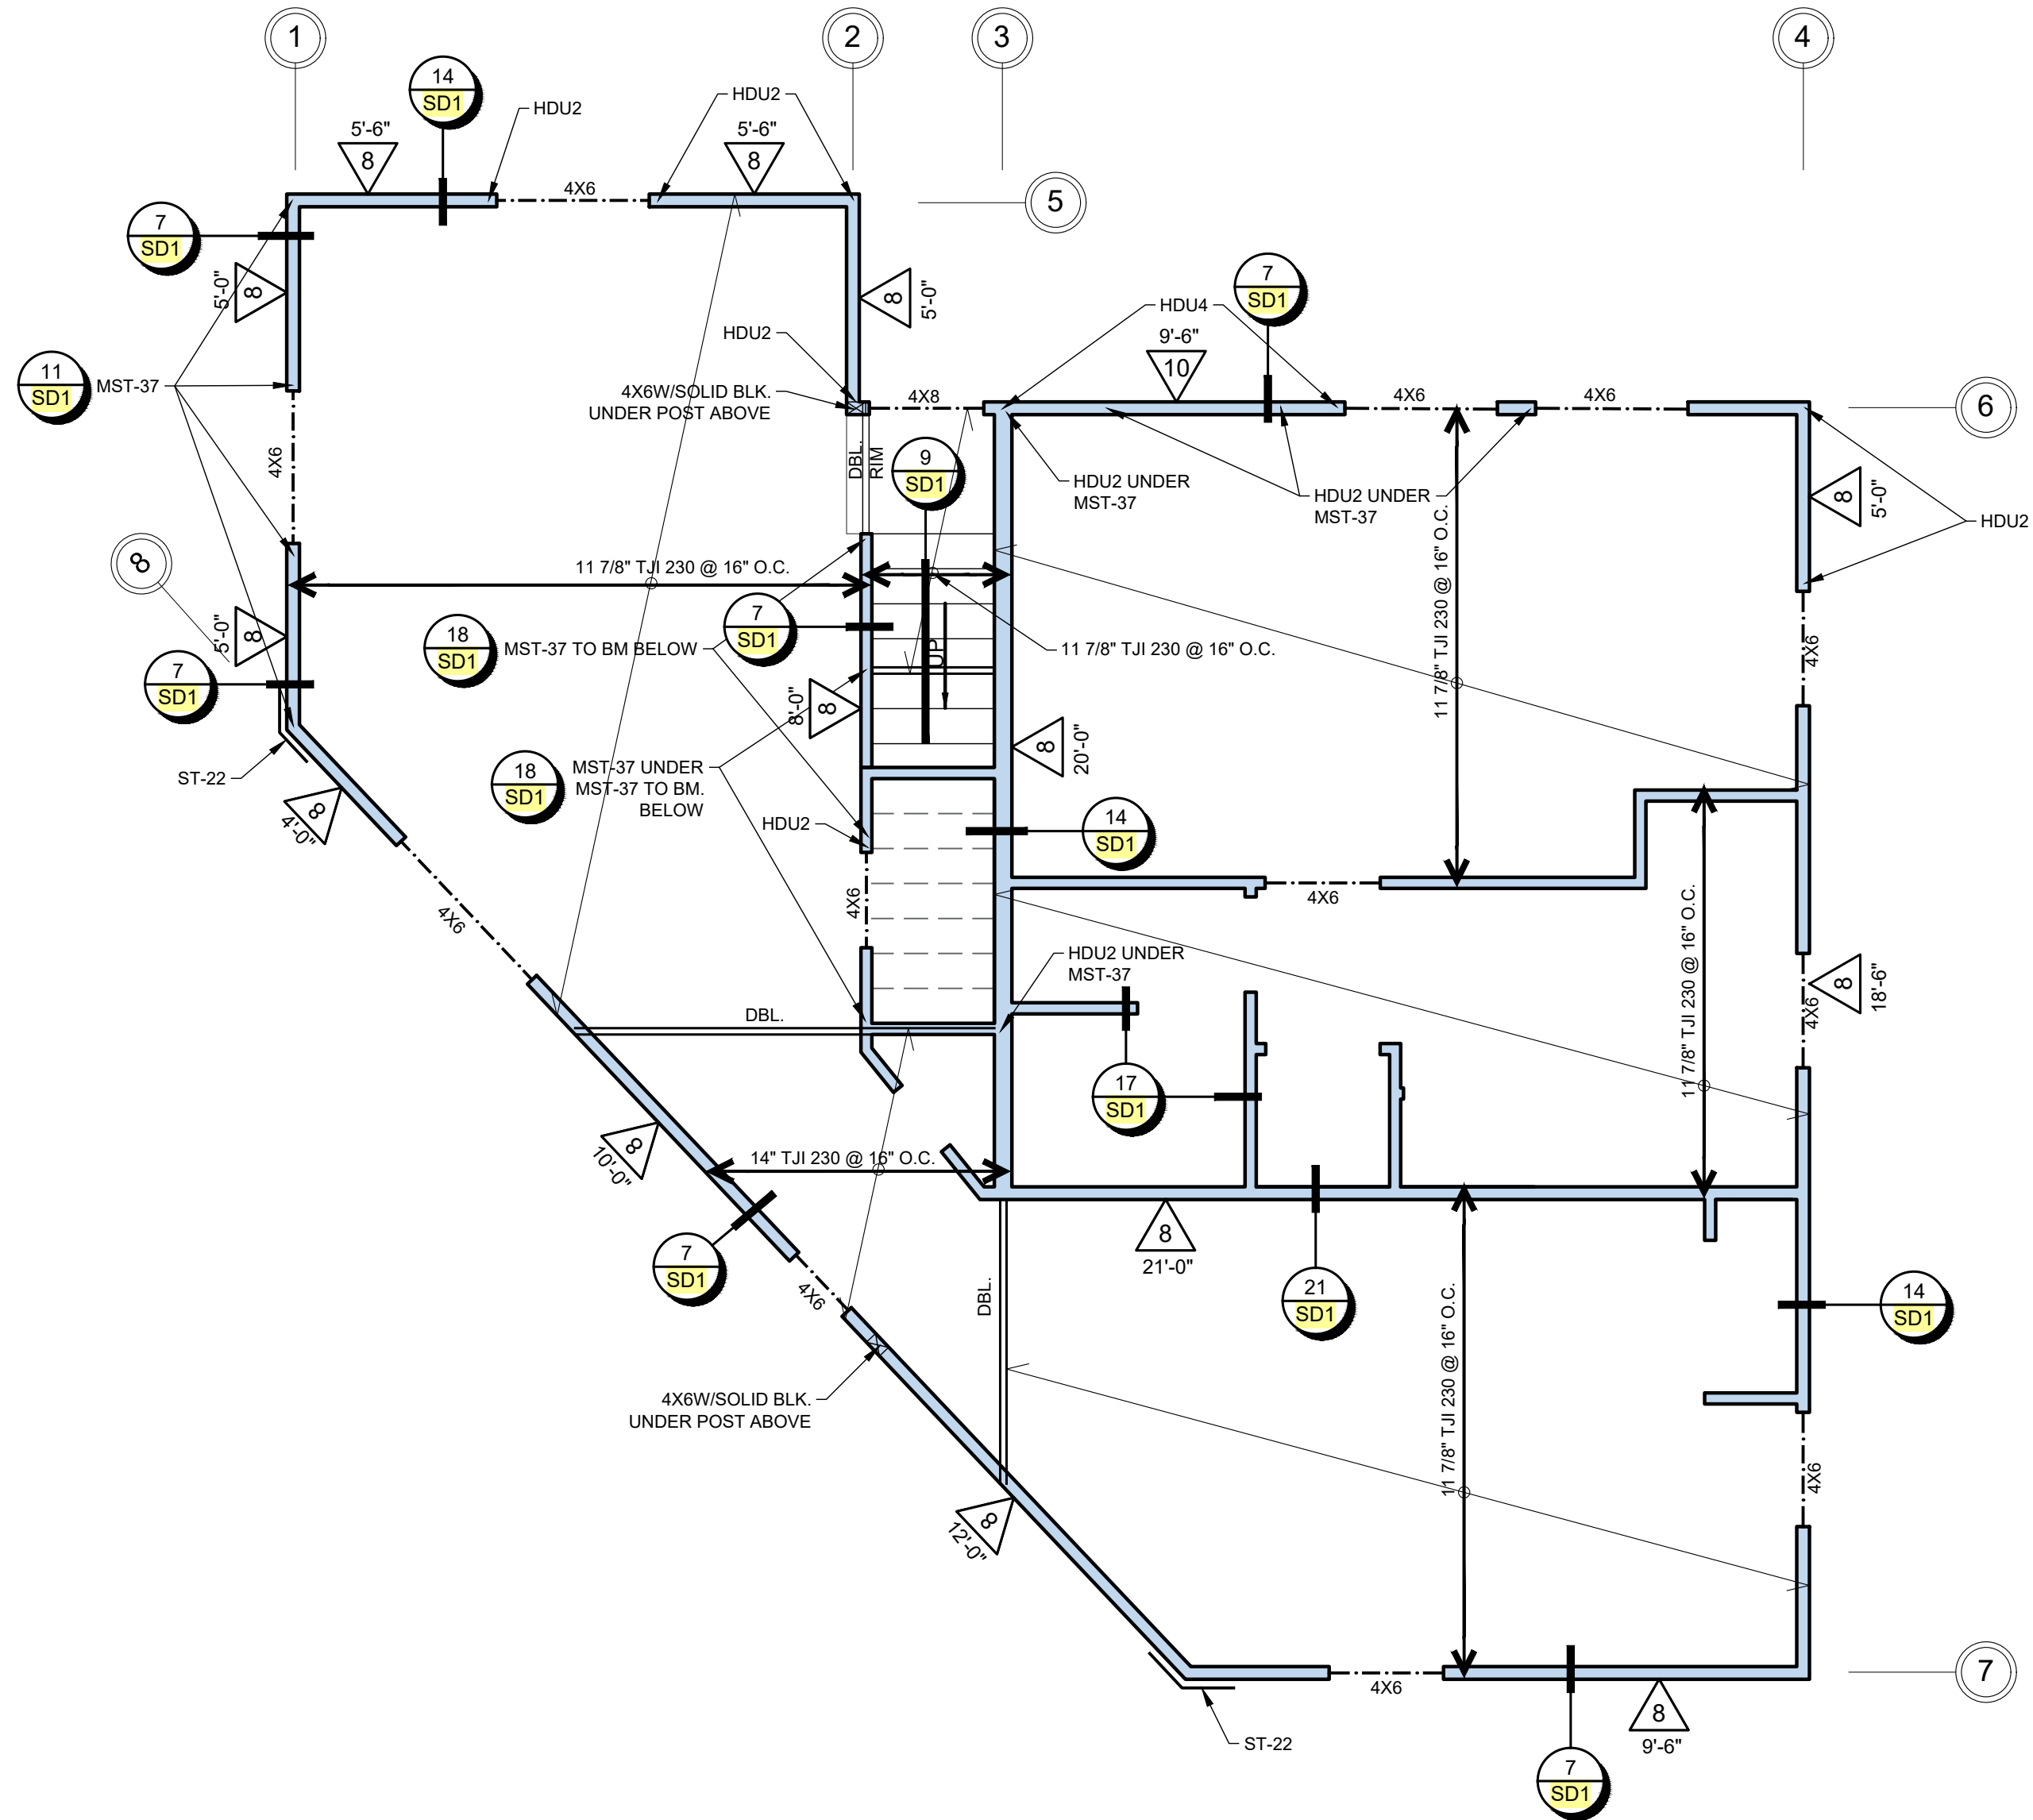


FLOOR FRAMING PLAN

SCALE 1/4" = 1'



WALL LEGEND

2x4 STUDS WALLS	
2x4 LOW WALLS	
2x6 STUDS WALLS	
2x6 BALLOON FRAME WALLS	
NEW MASONRY WALLS	
CALIF. FILL @ FRAMING PLAN	
STRONG WALL	

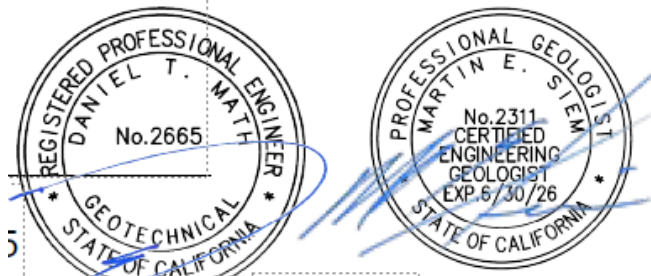

March 4, 2024

REVISIONS	DATE



CONTRACTOR


PROJECT TYPE
2 STORY DWELLING W/ATTACHED GARAGE
OWNER
JESSICA BRANDT
ADDRESS
SHOSHONE ST., OCEANSIDE, CA. 92038

SHEET TITLE
FLOOR FRMG. PLAN

CONTRACT DATE	4/5/2023
DATE	4/5/2023
DRAWN	MARIA G.
SHEET	

S3

NO PART OF THESE PLANS AND ANY WRITTEN MATERIALS APPEARING HEREIN, MAY BE COPY, REPRINTED, ALTERED OR REUSED WITHOUT CONSENT OF NADER'S DESIGN CONSULTING, INC. DRAWINGS AND SPECIFICATIONS ARE INSTRUMENTS OF SERVICE AND SHALL REMAIN THE PROPERTY OF NADER'S DESIGN CONSULTING, INC. USE IS RESTRICTED TO THE WORK FOR WHICH THEY ARE PREPARED.
COPYRIGHT © 2018 BY NDC

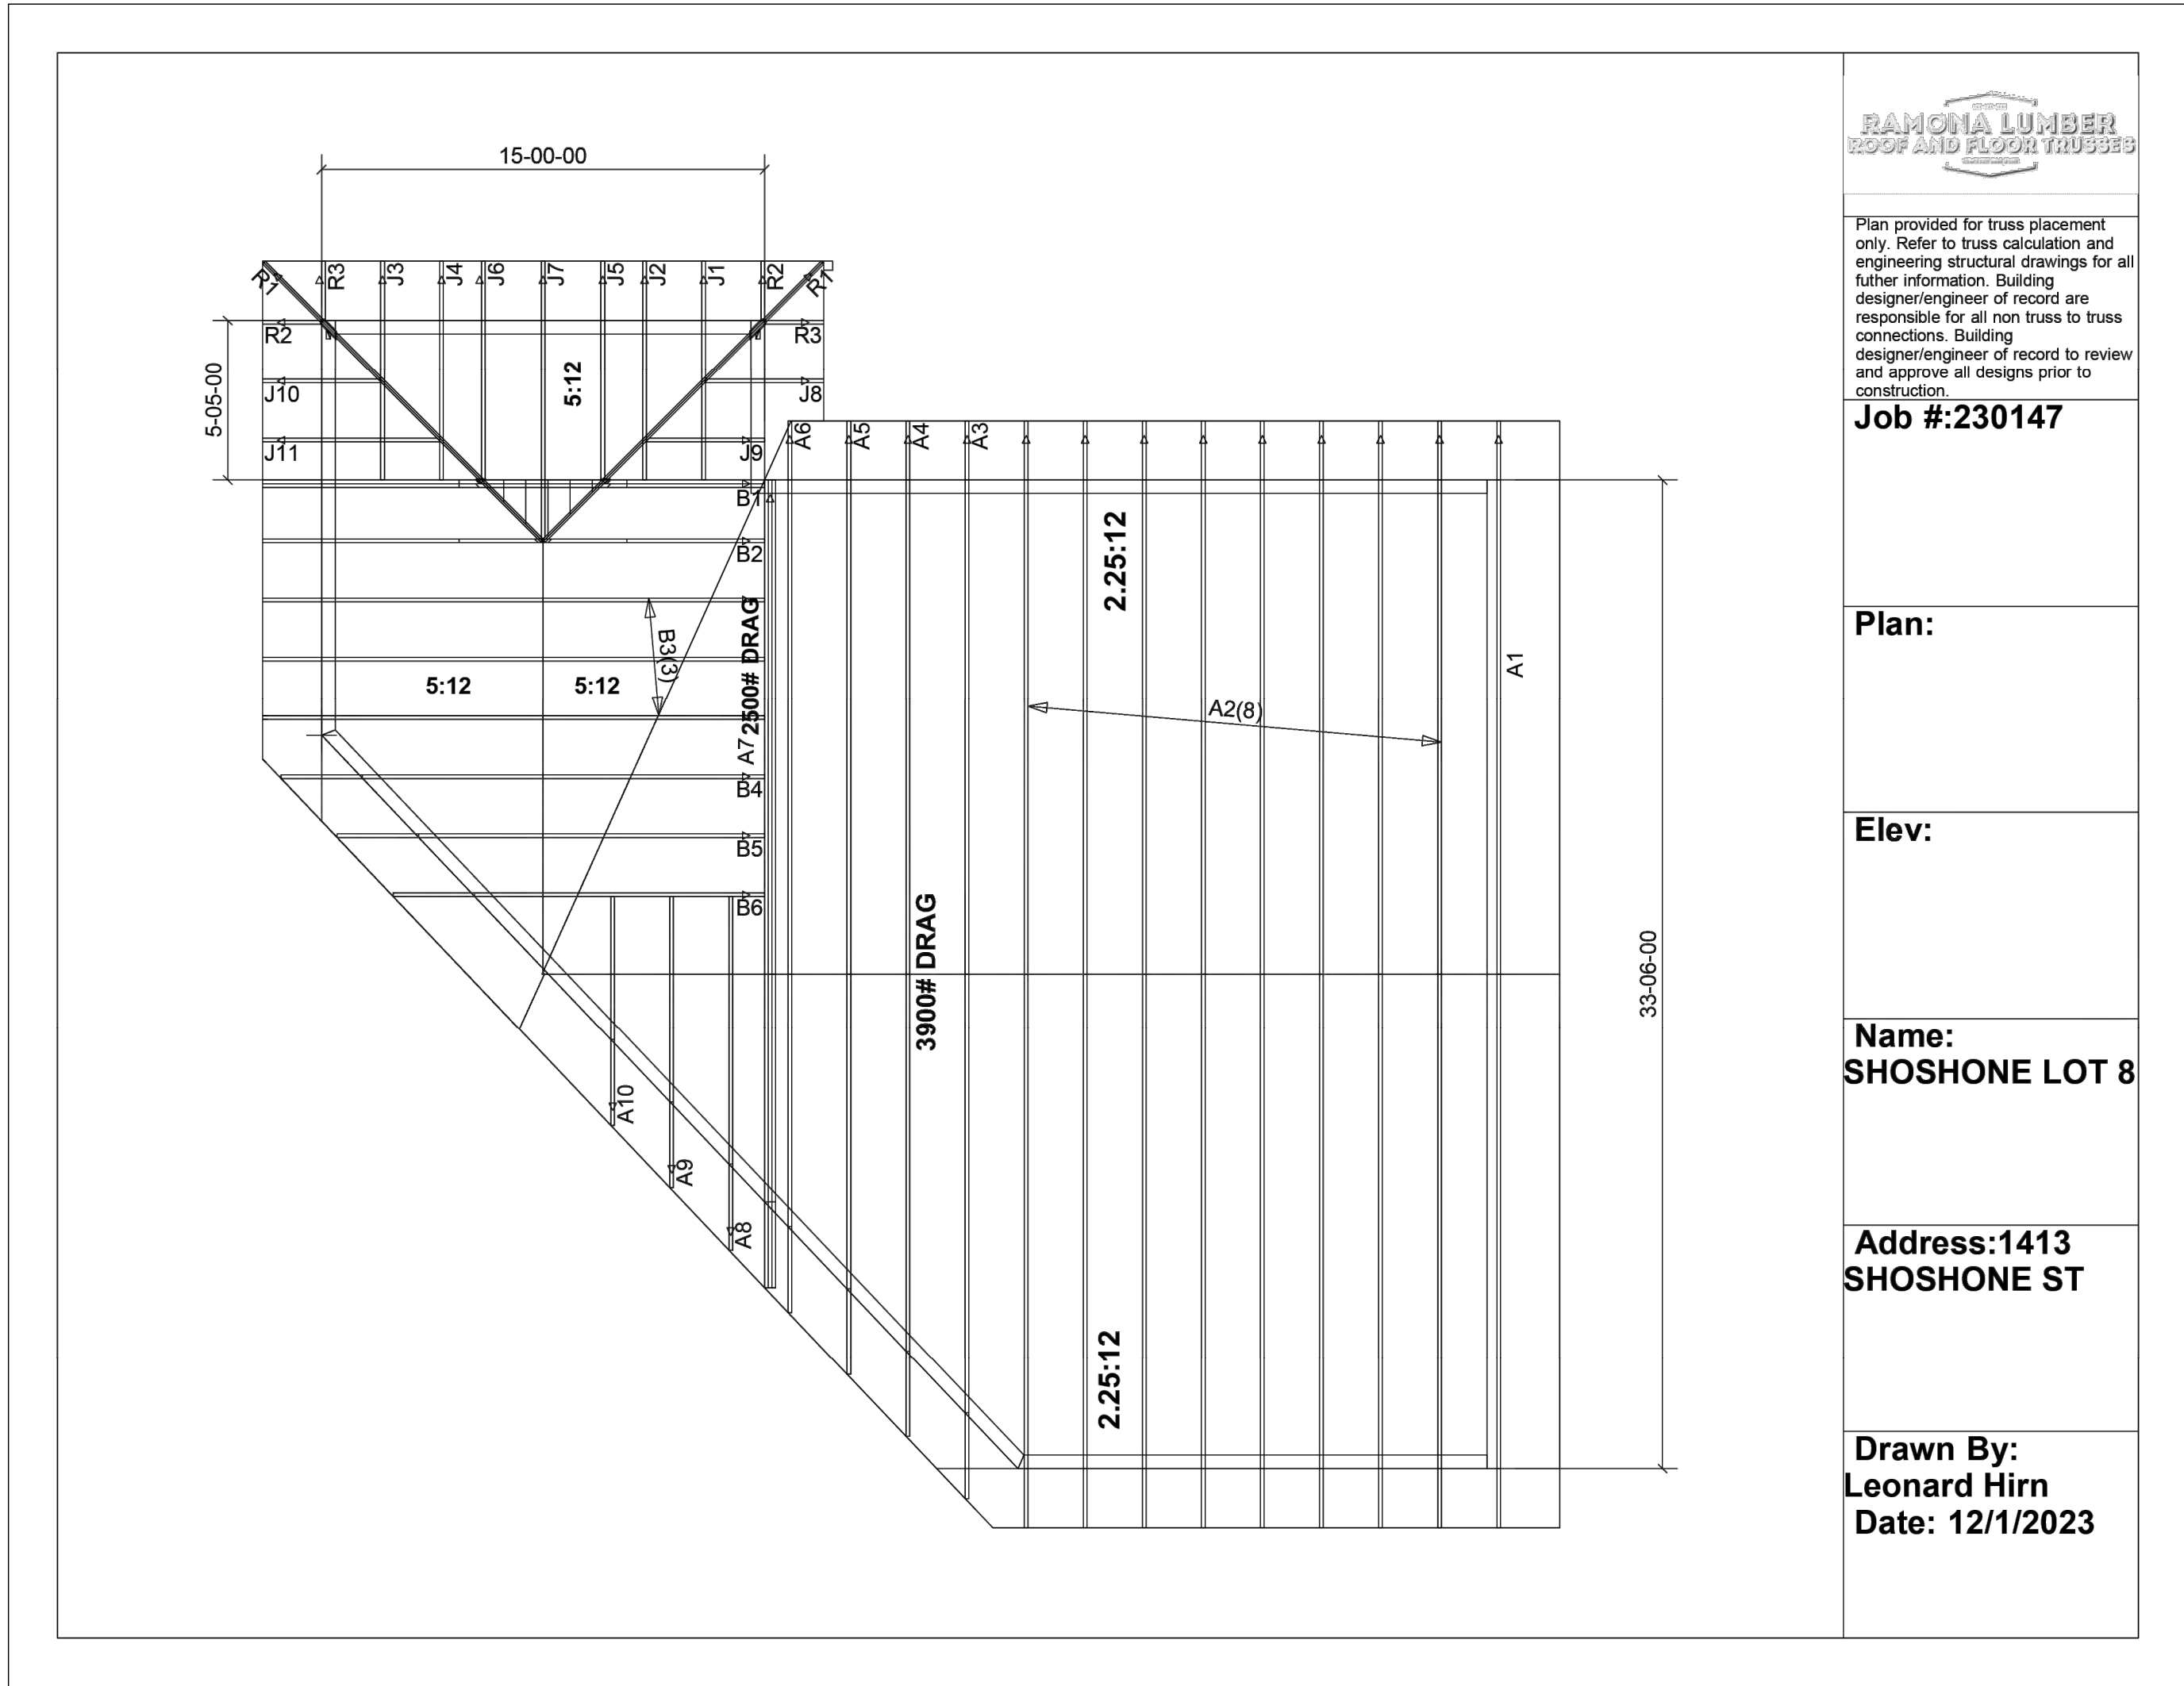

TRUSSES LAYOUT


ROOF FRAMING NOTES

- ROOF FRAMING DIAPHRAGM TO BE 1/2" A.P.A. RATED SHEATHING 32/16 OR 24/0, NAIL 8D COMMON AT 6" O.C. EDGE NAILING AND BOUNDARY, 12" O.C. FIELD NAILING.
- ROOF HEADERS:
 - L ≤ 5' 4 X 6 OR: 6 X 6 U.N.O.
 - L < 6' 4 X 8 OR: 6 X 8 U.N.O.
- ALL HIP FILL AND HIP OVER TRUSS FRAMING MUST BE BRACED AND SUPPORTED PER CALIFORNIA FILL DETAILS.
- BALLOON FRAME WALLS OF ROOMS WITH SLOPING CEILINGS.
- MAXIMUM ALLOWABLE STUD HEIGHTS: U.N.O.
- BEARING WALL: 2X4 AND 2X6 MAXIMUM 10 FT. U.N.O.
- NONBEARING WALL: 2X4 MAXIMUM 14 FT., 2X6 MAXIMUM 20 FT.
- ALL HOLDDOWNS ON 2-2X STUDS WITH 2-16D @ 6" O.C. OR 4X POST U.N.O.
- ALL STRAPS, COLUMN CAPS, HANGERS, CLIPS, ETC. TO BE PRODUCED BY "SIMPSON STRONG TIE," OR EQUAL.
 - a) ALL SPECIFIED FASTENERS MUST BE INSTALLED ACCORDING TO THE INSTRUCTIONS IN THEIR CATALOG. INCORRECT FASTENER QUANTITY, SIZE, TYPE, MATERIAL, OR FINISH MAY CAUSE THE CONNECTION TO FAIL. 16D FASTENERS ARE COMMON NAILS (8 GA X 3 1/2") AND CANNOT BE REPLACED WITH 16D SINKERS (9 GA. X 3 1/4") UNLESS OTHERWISE SPECIFIED.
 - b) BOLT HOLES SHALL BE A MINIMUM OF 1/32" AND A MAXIMUM OF 1/16" LARGER THAN THE BOLT DIAMETER.
 - c) UNLESS OTHERWISE NOTED, ALLOWABLE, BOLTS AND NAILS CANNOT BE COMBINED. 8D, 10D AND 16D SPECIFY COMMON NAILS.
 - d) FILL ALL FASTENER HOLES WITH FASTENER TYPES SPECIFIED, WITH TABLES FOR HIGHEST CAPACITY.
- THIS PLAN DOES NOT PROVIDE COMPLETE FLASHING AND WATERPROOFING DETAILS. THE DESIGNER AND ENGINEER DO NOT REPRESENT THEMSELVES TO BE EXPERTS IN THE FIELD OF WATERPROOFING. IT SHALL BE THE RESPONSIBILITY OF THE ROOFING/DECKING CONTRACTOR TO PROVIDE THE WORKMANSHIP AND MATERIALS NECESSARY TO PROVIDE THE STANDARD OF CARE TO COMPLETE THE ROOF AND DECKS IN A WATERTIGHT CONDITION. ROOF OR DECK DRAINAGE SHALL NOT BE ALLOWED TO RUN BEHIND ANY FASCIA BOARDS OR ON THE STUCCO EXTERIOR FINISH.
- ALL PLUMBING WALLS TO BE 2" X 6" STUDS. NO PLUMBING PIPES OVER 1 1/2" DIAMETER IN 2X4 SHEAR WALLS AND 3" DIAMETER IN 2X6 SHEAR WALLS.
- PLASTER APPLIED OVER WOOD BASED SHEATHING SHALL INCLUDE TWO LAYERS OF GRADE D PAPER.
- MEASUREMENTS AND WALL THICKNESS MAY VARY FROM DRAWINGS. EXPOSE EXISTING FRAMING AND FIELD VERIFY EXACT STRUCTURAL FRAMING SIZE, LAYOUT, AND DIMENSIONS PRIOR TO CONSTRUCTION.
- EACH TRUSS SHALL BE LEGIBLE BRANDED, MARKED OR OTHERWISE HAVE PERMANENTLY AFFIXED THERE TO THE FOLLOWING INFORMATION LOCATED WITHIN 2 FEET OF THE CENTER OF THE SPAN ON THE FACE OF THE BOTTOM CHORD:
 - a) IDENTITY OF THE COMPANY MANUFACTURING THE TRUSS.
 - b) THE DESIGN LOAD.
 - c) THE SPACING OF THE TRUSS.
- PROVIDE BRACING FOR TRUSSES TO PREVENT ROTATION AND PROVIDE LATERAL STABILITY IN ACCORDANCE ON THE INDIVIDUAL TRUSS DESIGN DRAWING. (CRC502.11.2)





ROOF FRAMING PLAN

SCALE 1/4" = 1'

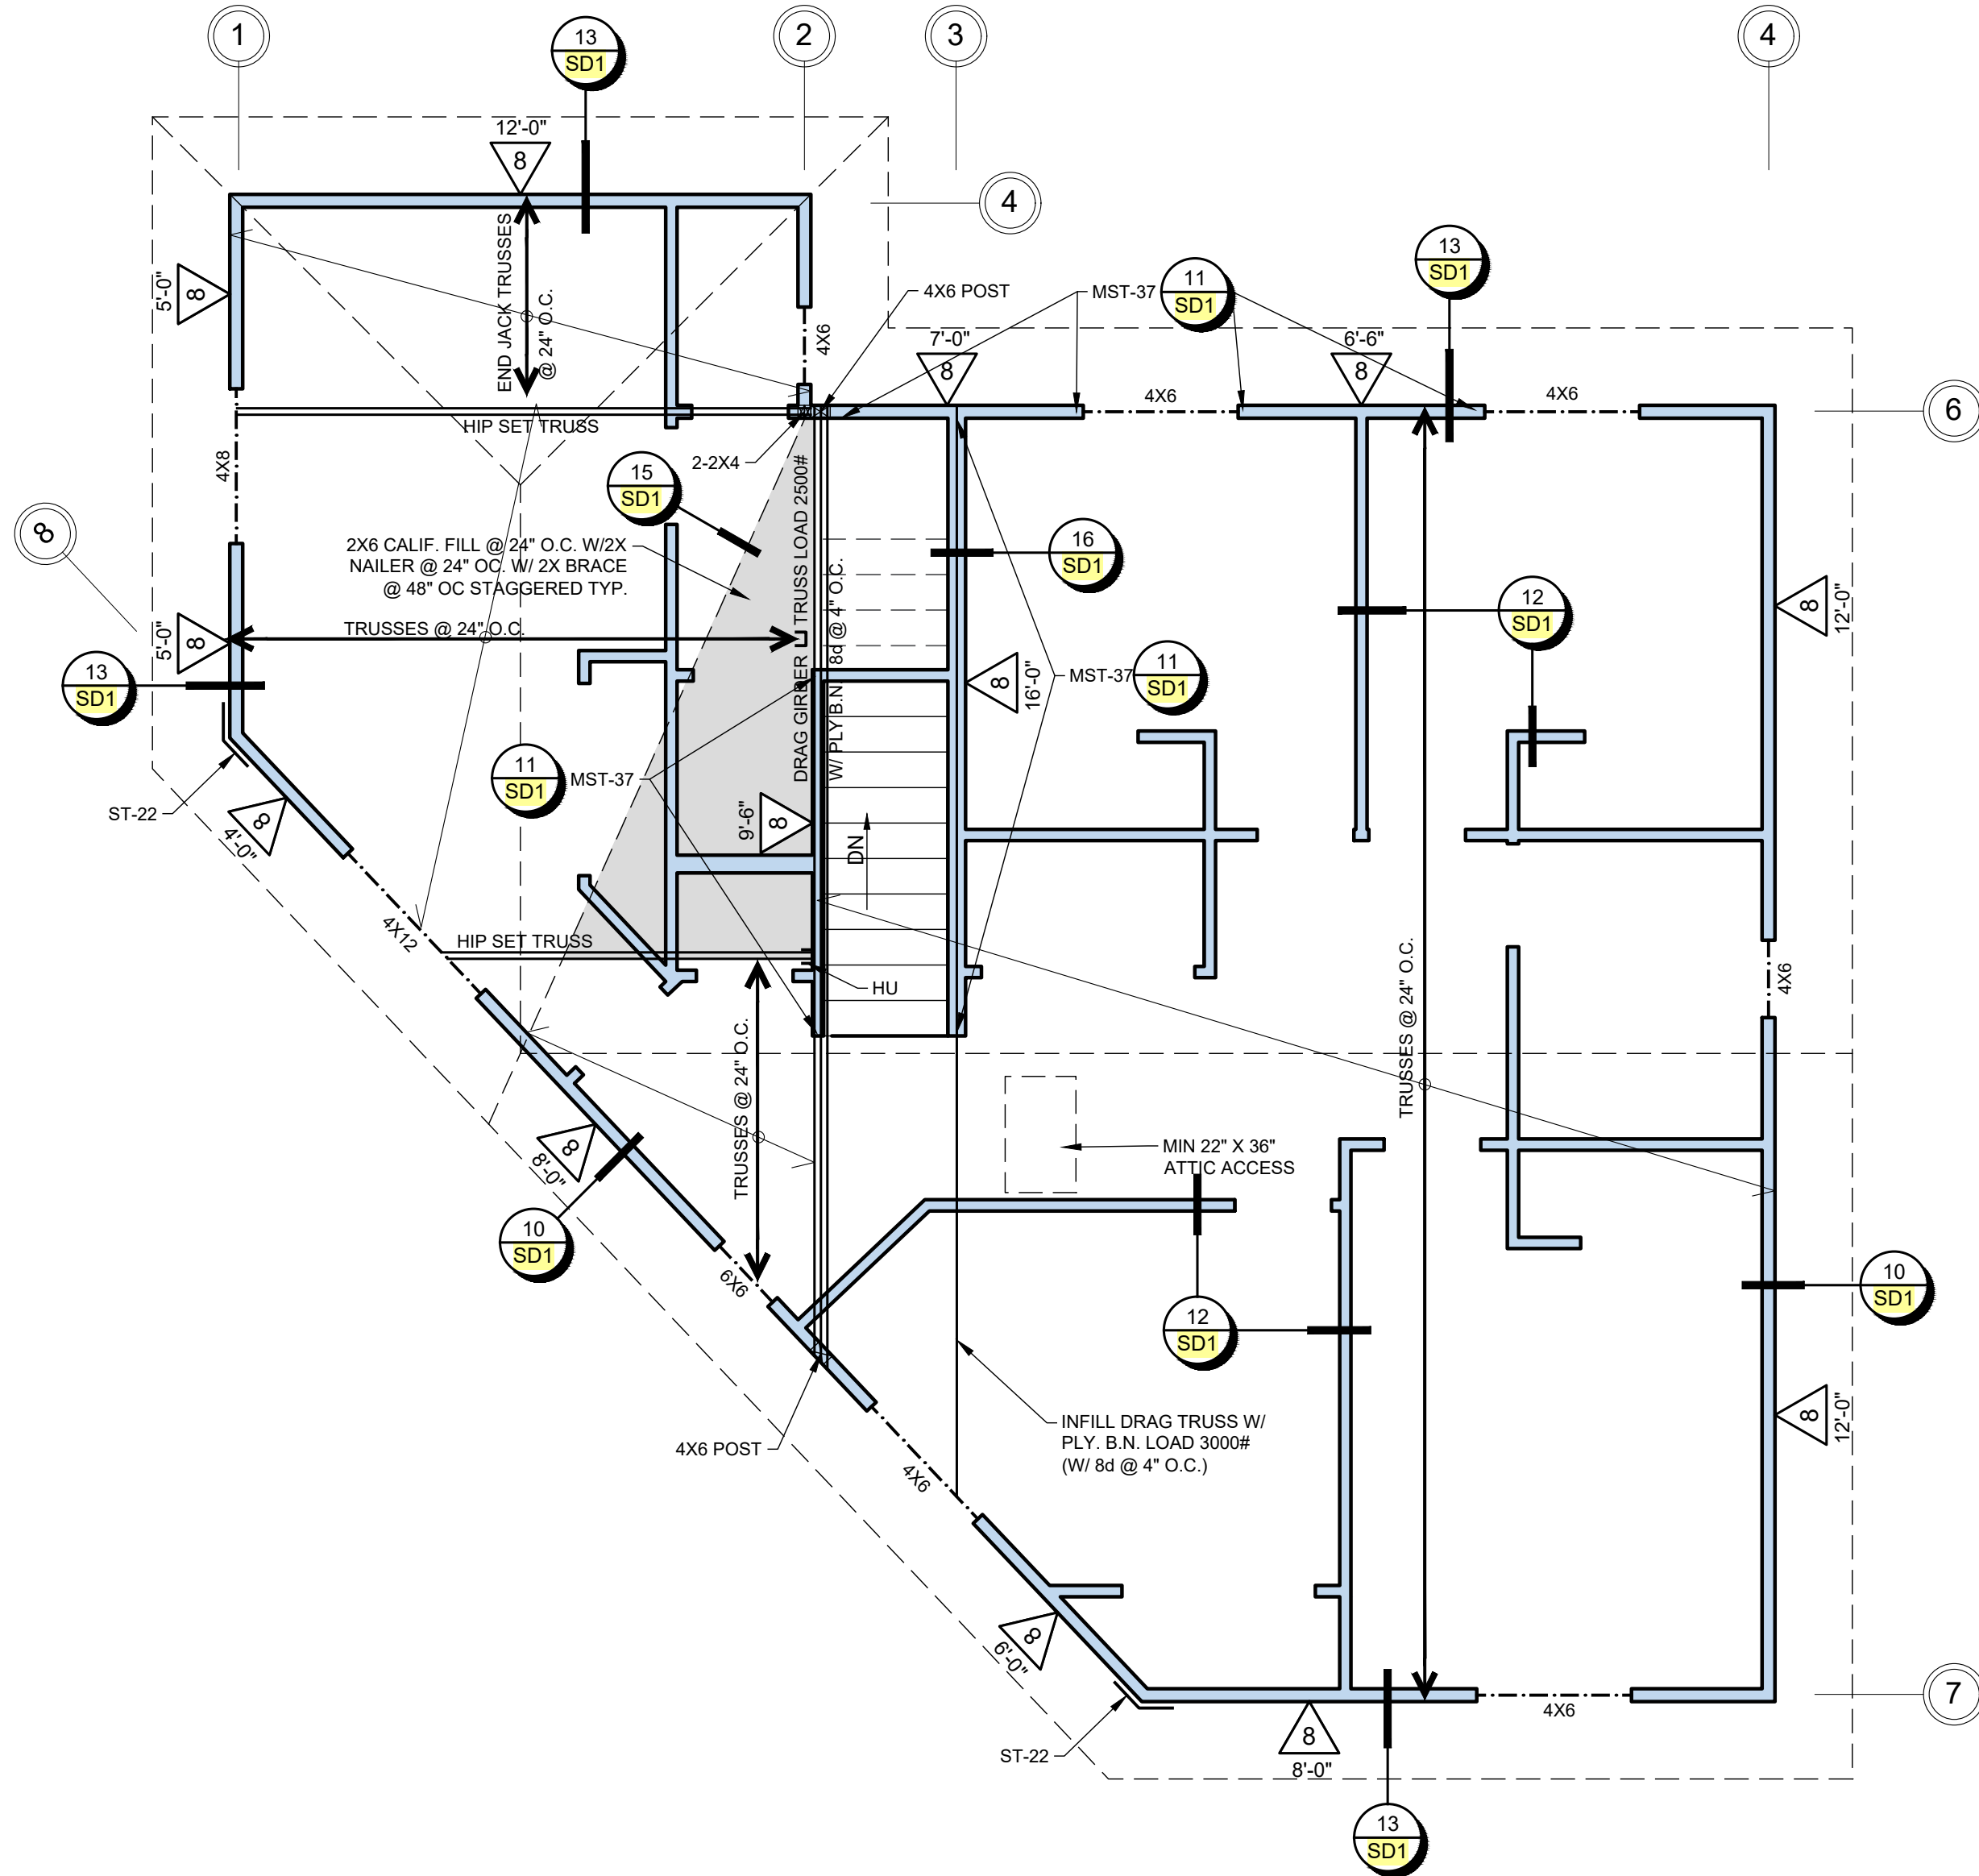

WALL LEGEND

2x4 STUDS WALLS	
2x4 LOW WALLS	
2x6 STUDS WALLS	
2x6 BALLOON FRAME WALLS	
NEW MASONRY WALLS	
CALIF. FILL @ FRAMING PLAN	
STRONG WALL	

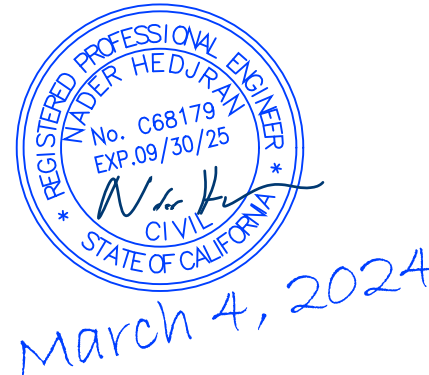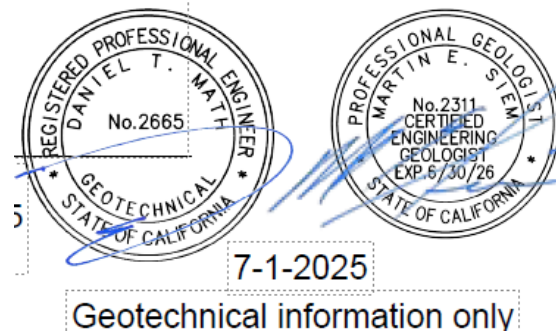

REVISIONS	DATE



CONTRACTOR


PROJECT TYPE

2 STORY DWELLING W/ ATTACHED GARAGE
OWNER
JESSICA BRANDT
ADDRESS
SHOSHONE ST., OCEANSIDE, CA. 92058



CONTRACT DATE	4/5/2023
DATE	4/5/2023
DRAWN	MARIA G.
SHEET	

S4


NO PART OF THESE PLANS AND ANY WRITTEN MATERIALS APPEARING HEREIN, MAY BE COPY, REPRINTED, ALTERED OR RE-USED WITHOUT CONSENT OF NADER'S DESIGN CONSULTING, INC. DRAWINGS AND SPECIFICATIONS ARE INSTRUMENTS OF SERVICE AND SHALL REMAIN THE PROPERTY OF NADER'S DESIGN CONSULTING, INC. USE IS RESTRICTED TO THE WORK FOR WHICH THEY ARE PREPARED.
COPYRIGHT © 2018 BY NDC

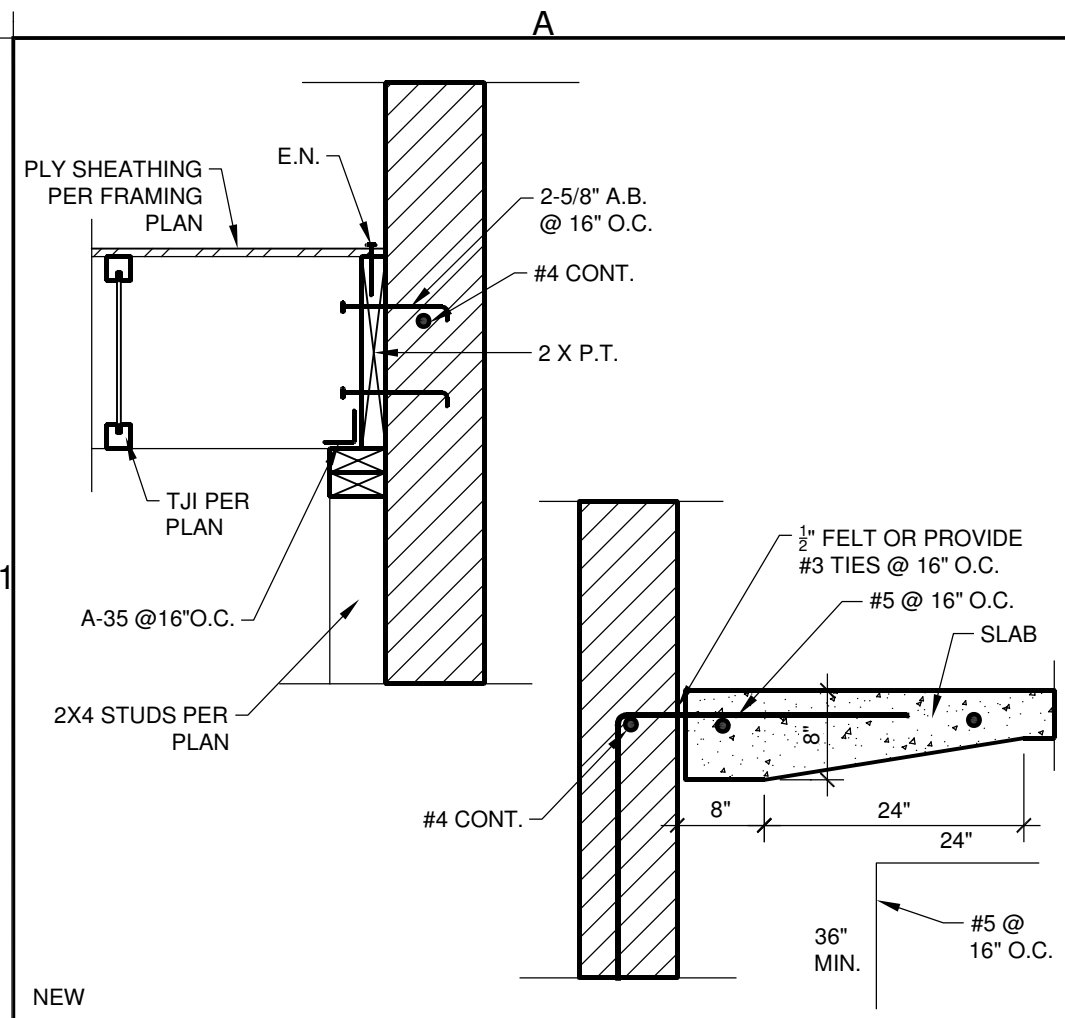


24 RETAINING WALL CONN.

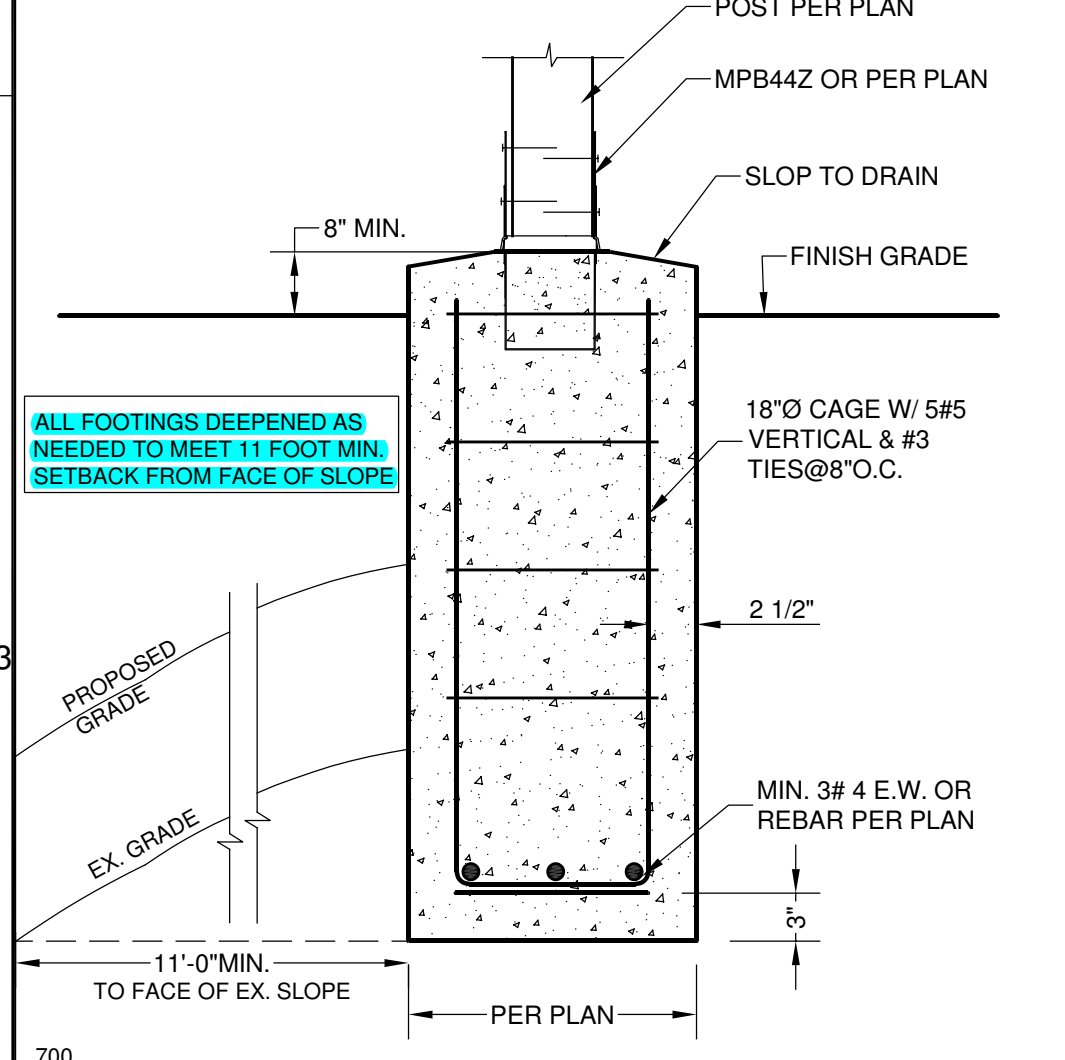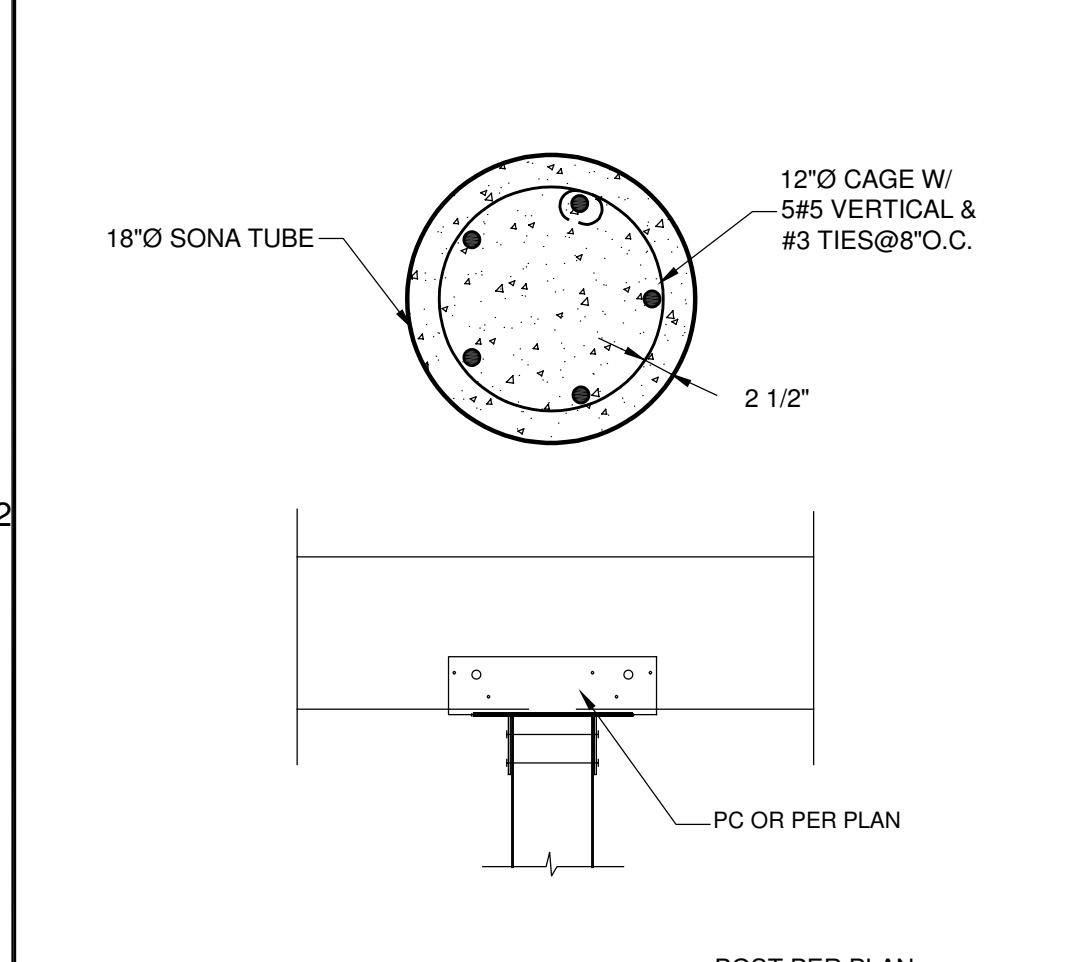


22 FLAG POLE FTG.

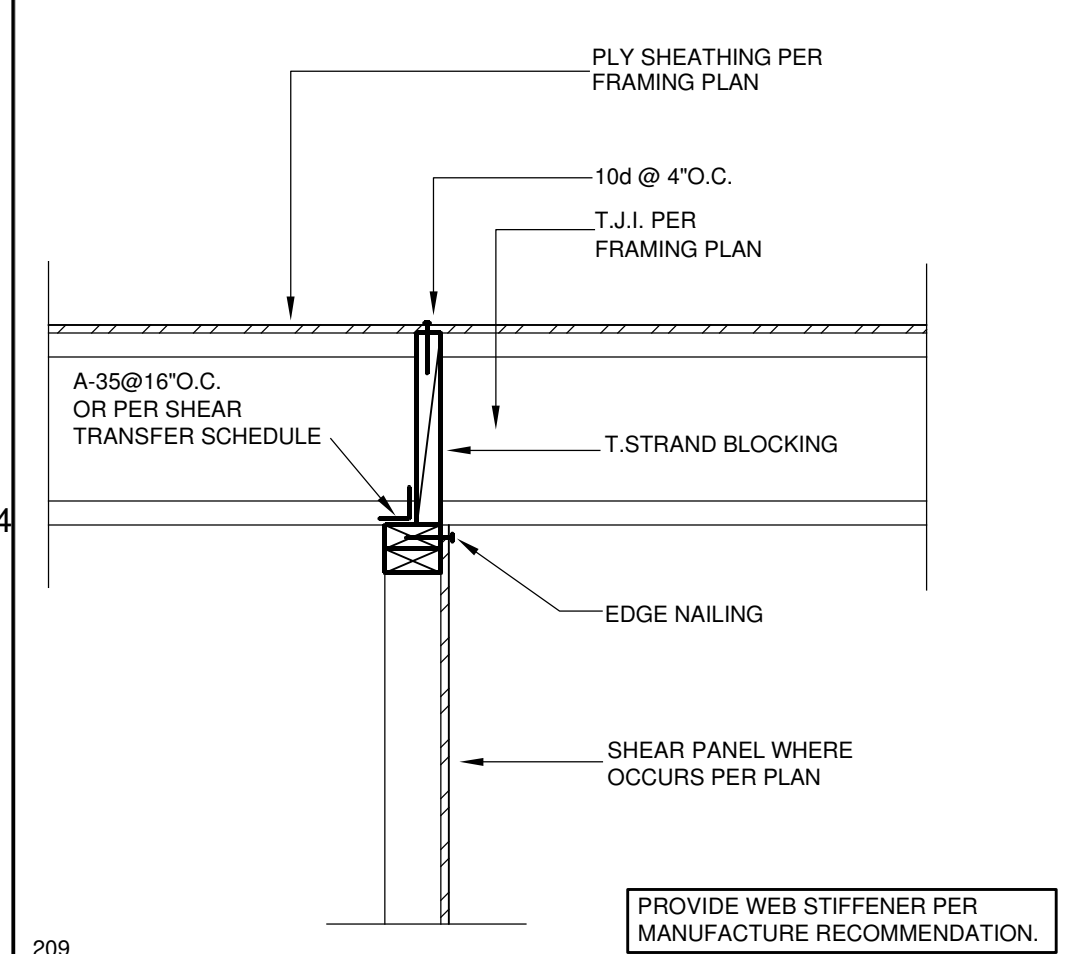


21 SHEAR TRANSFER

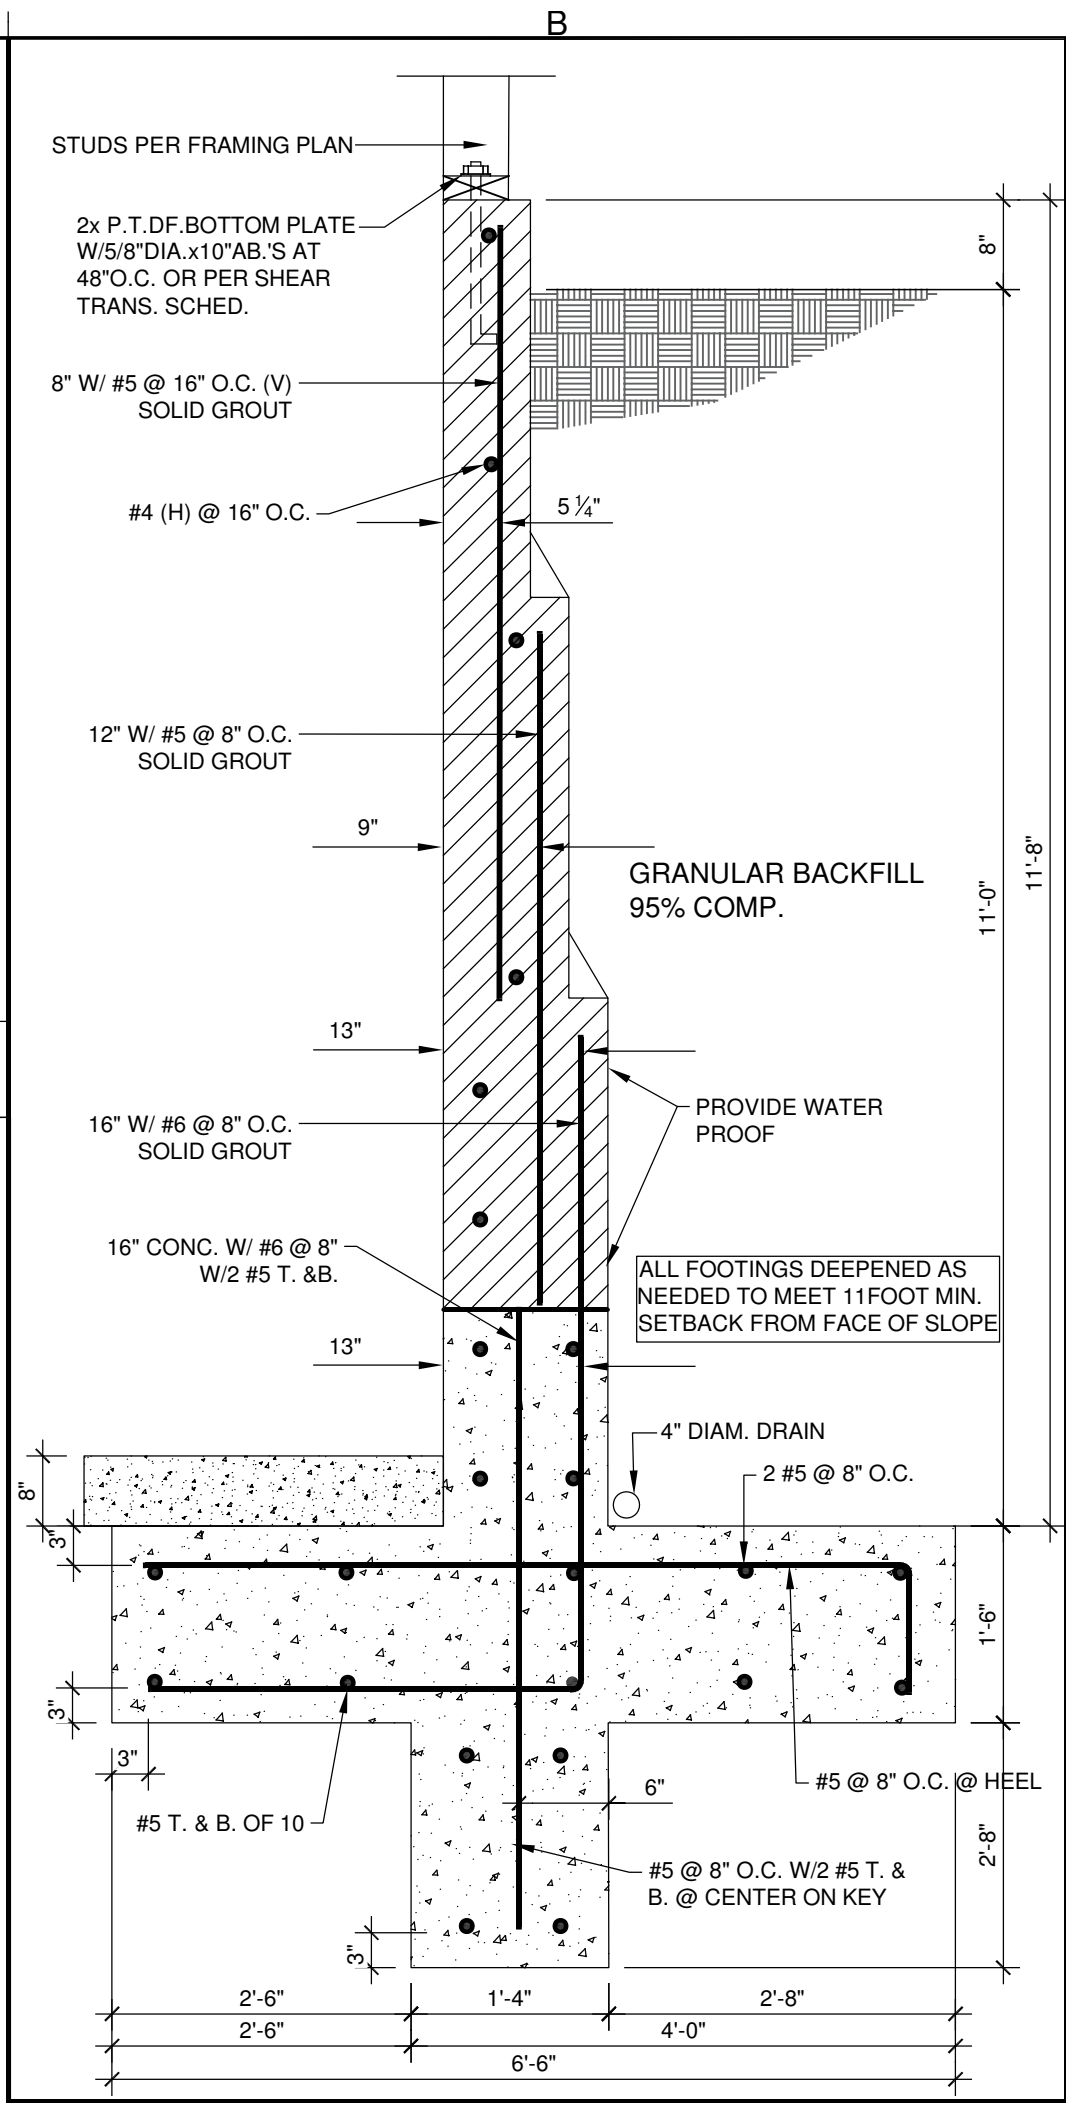


19 RETAINING WALL

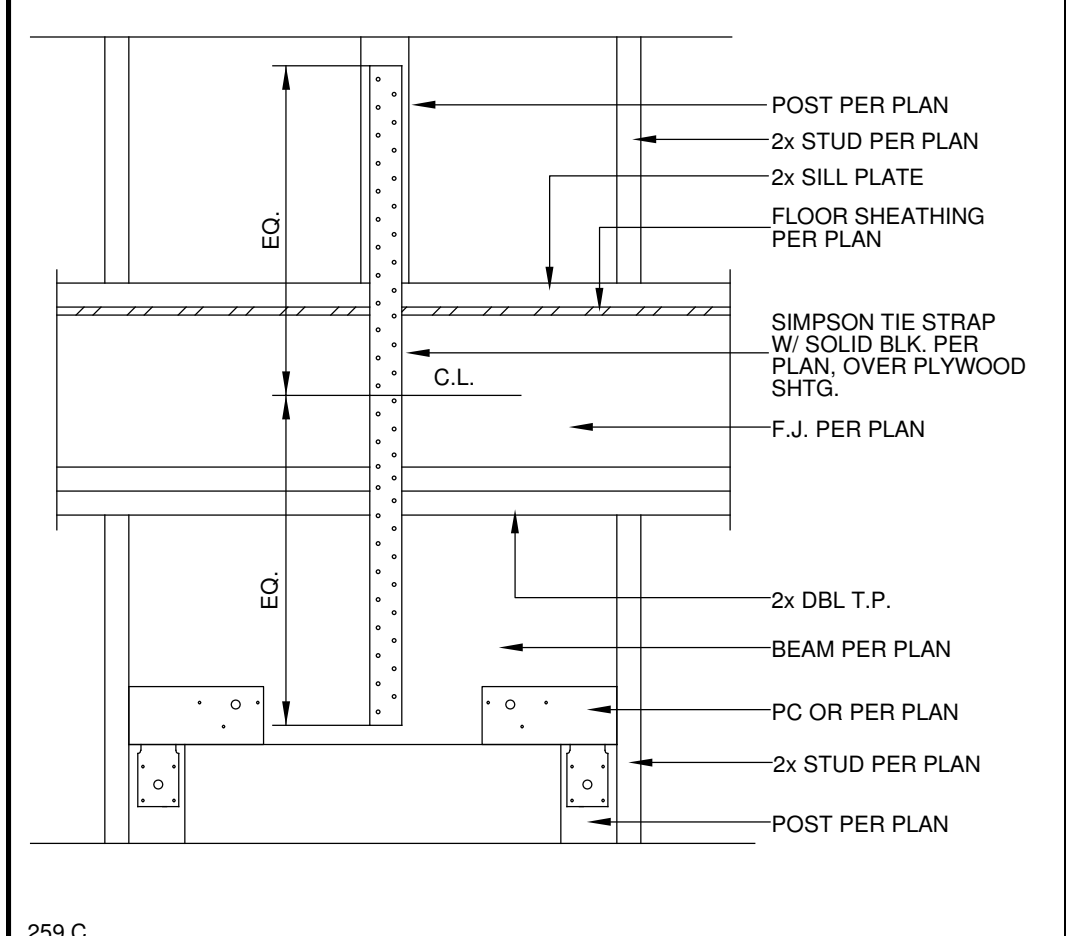


18 STRAP DETAIL

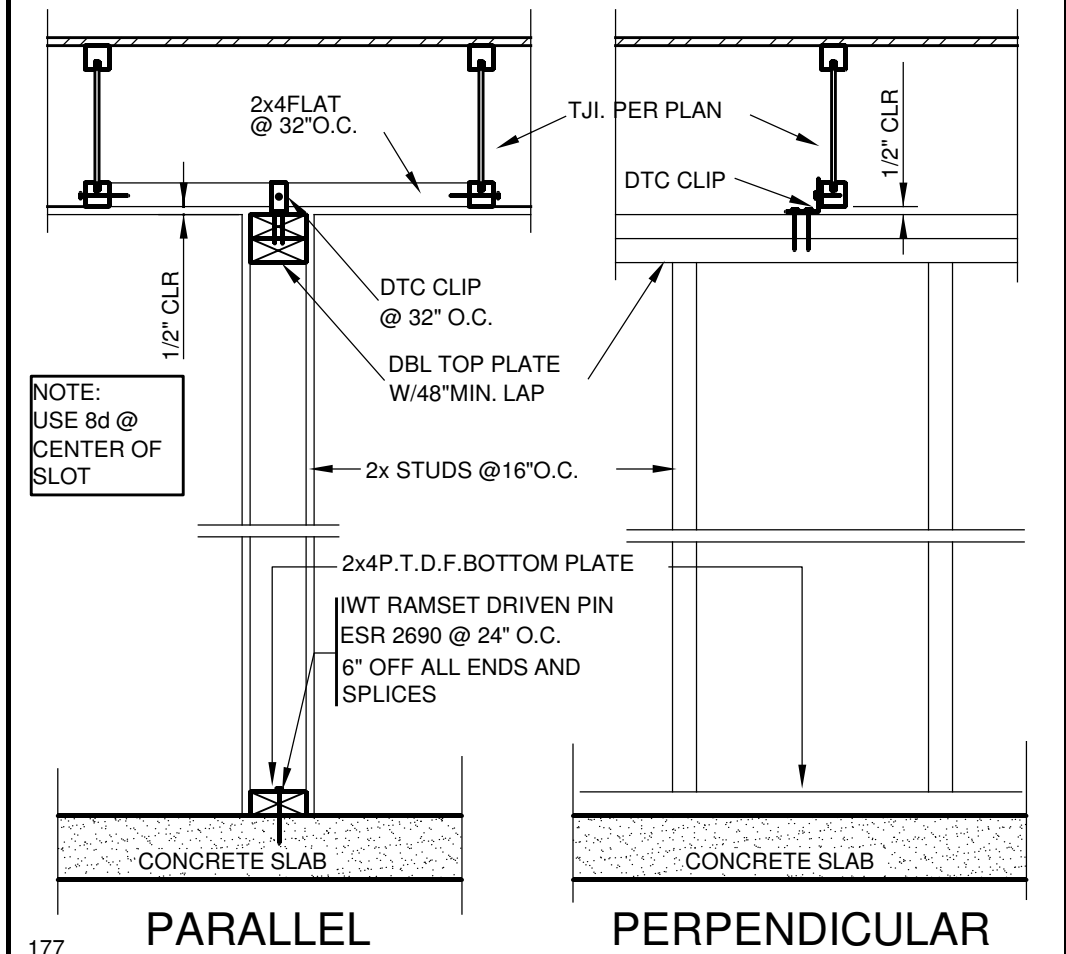


17 NONBEARING WALL

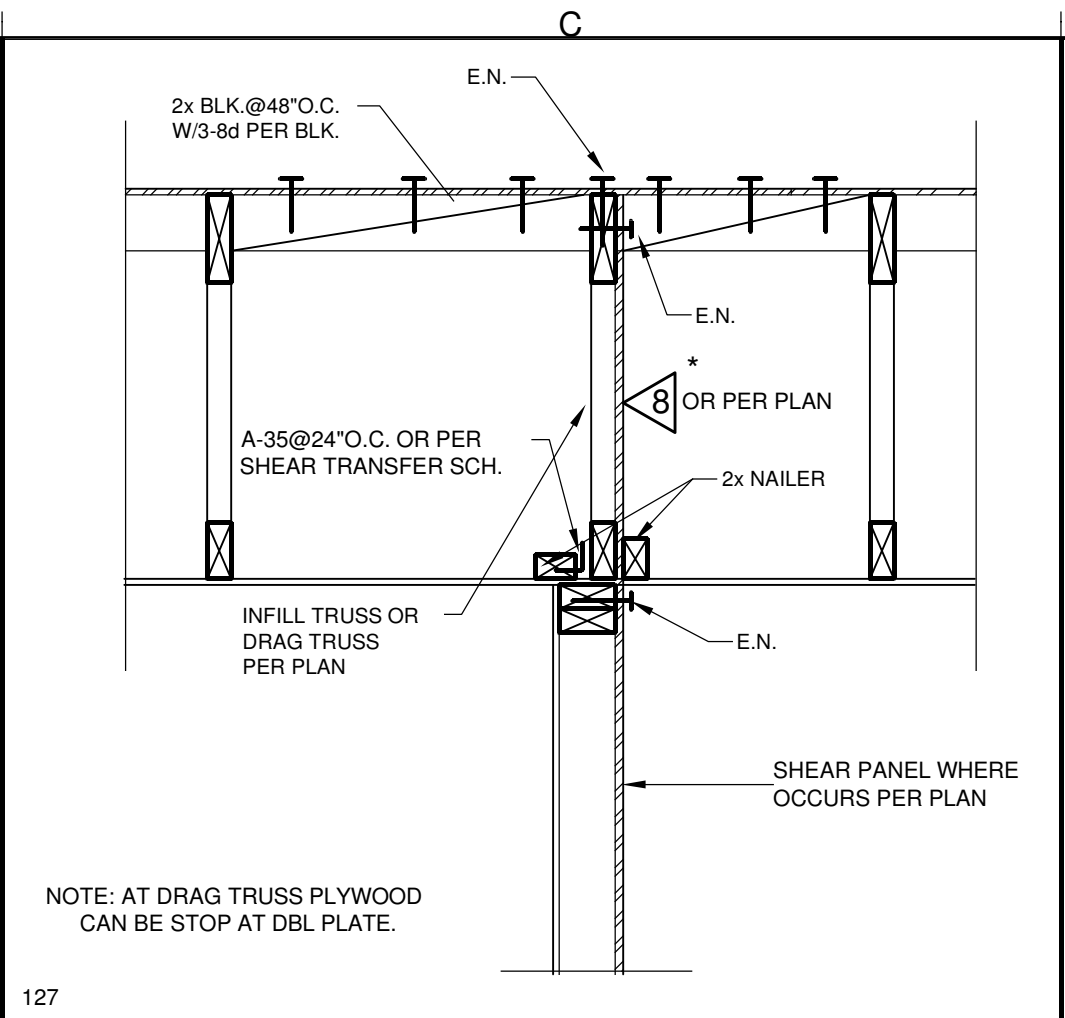


16 SHEAR TRANSFER

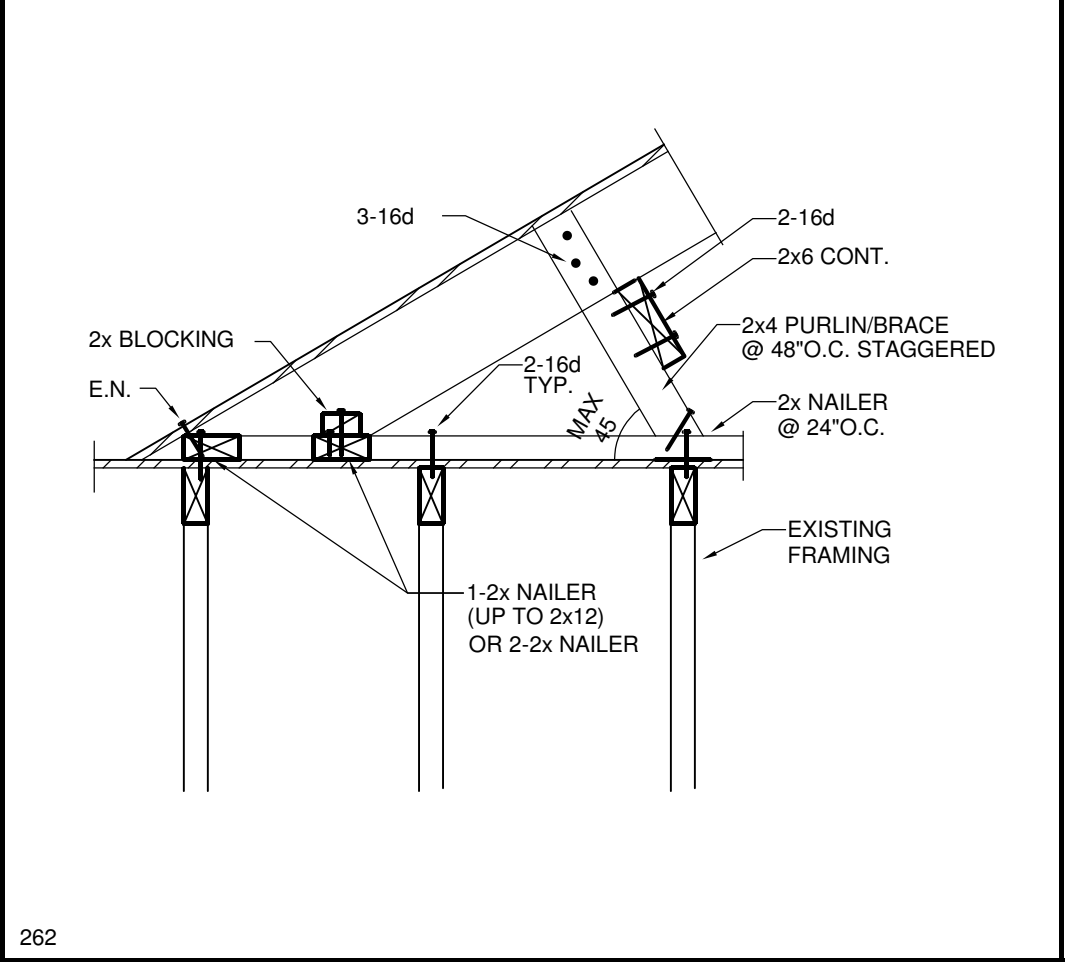


15 CALIFORNIA FILL

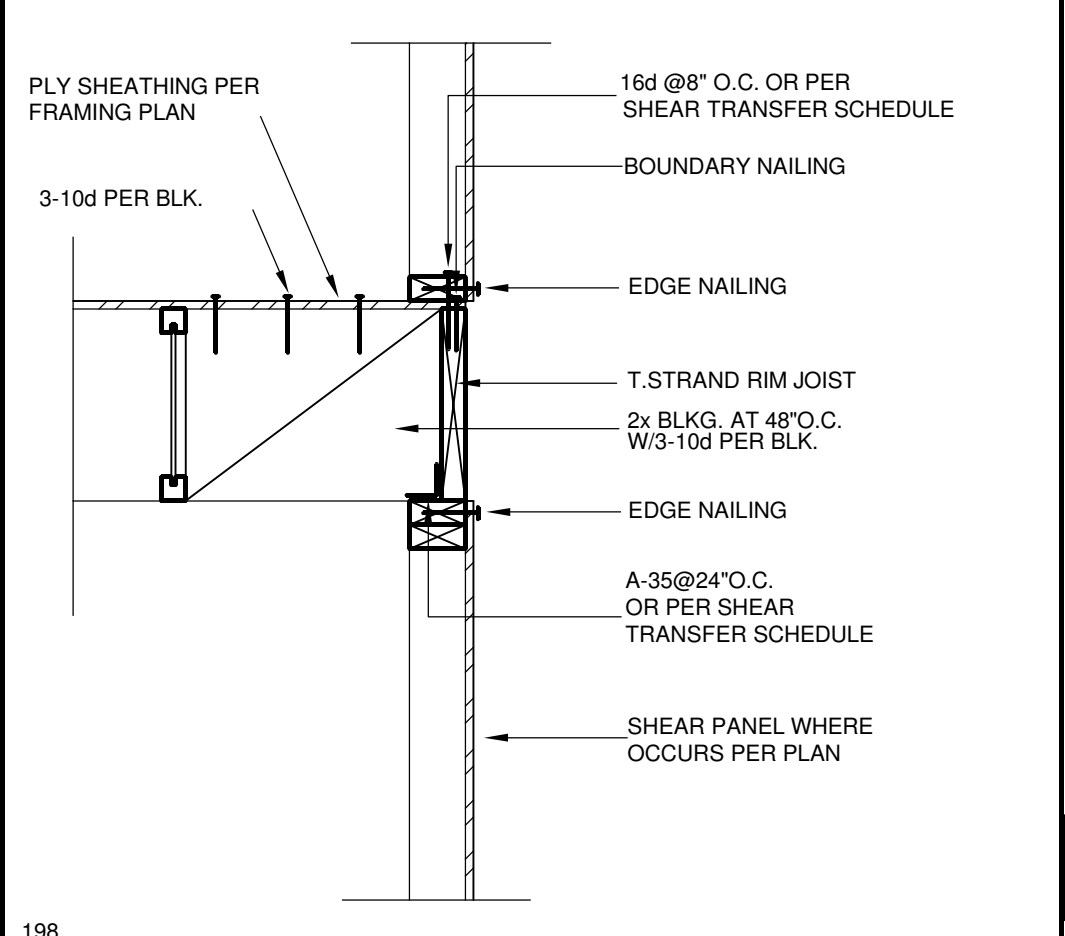


14 SHEAR TRANSFER

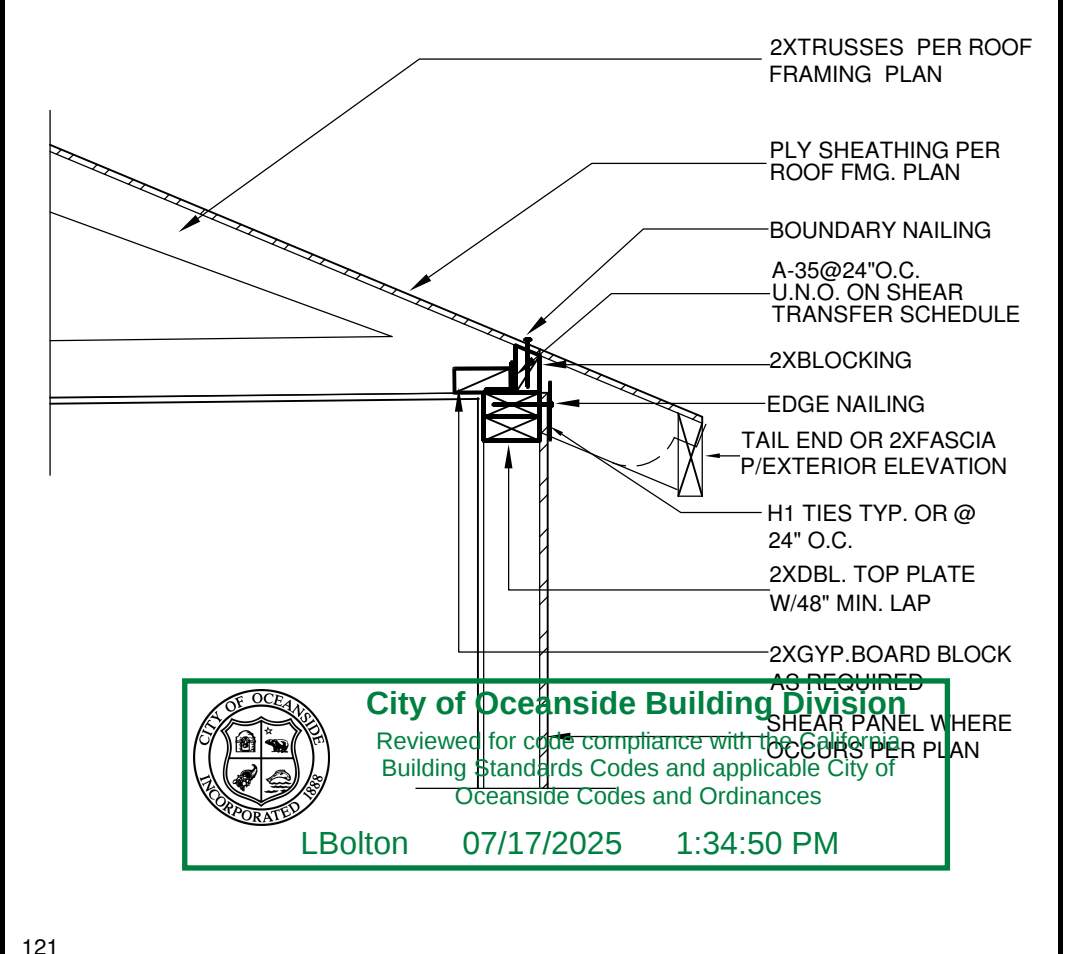


13 SHEAR TRANSFER

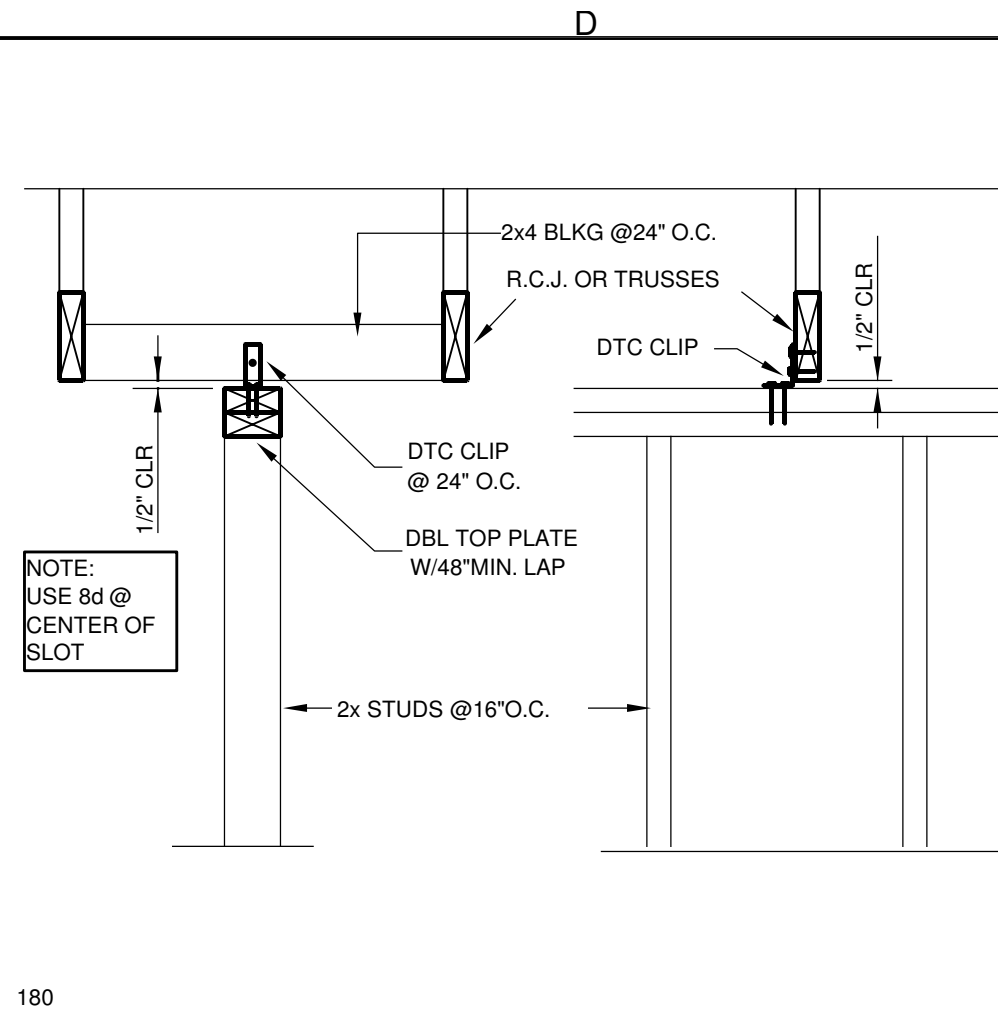


12 NONBEARING WALL

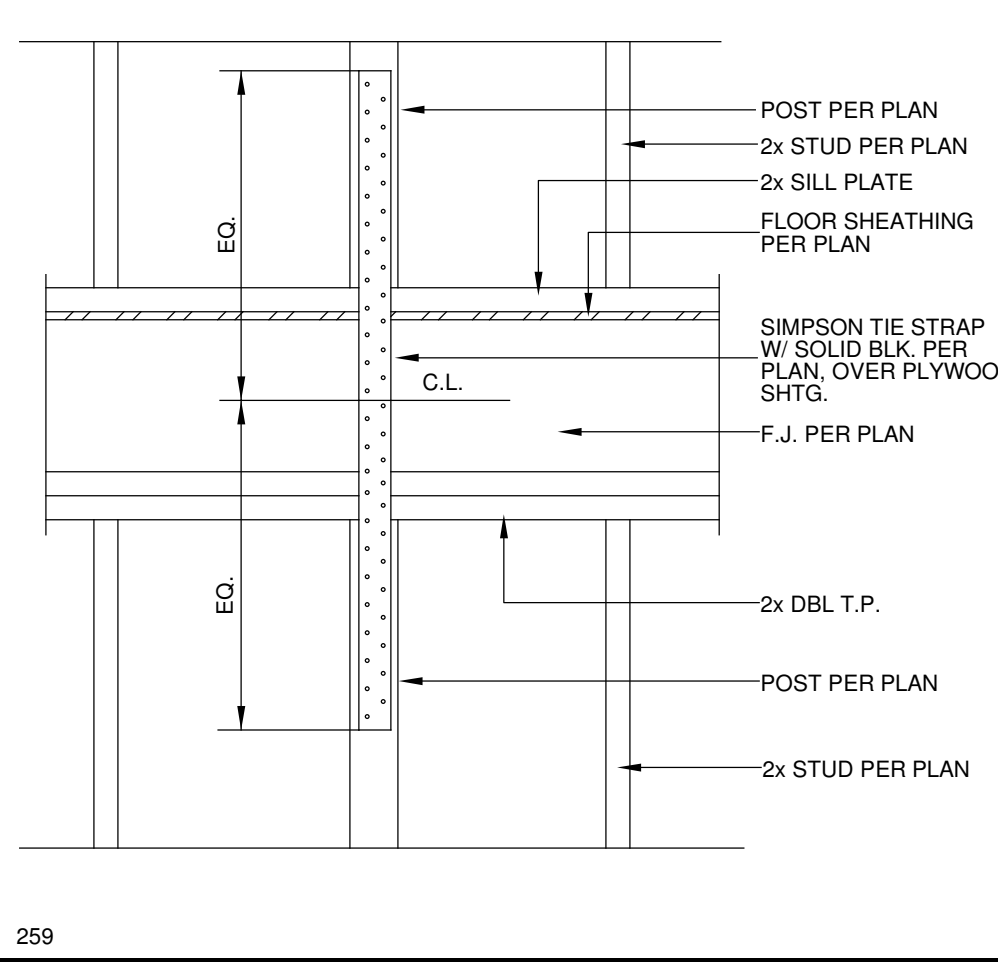


11 STRAP DETAIL

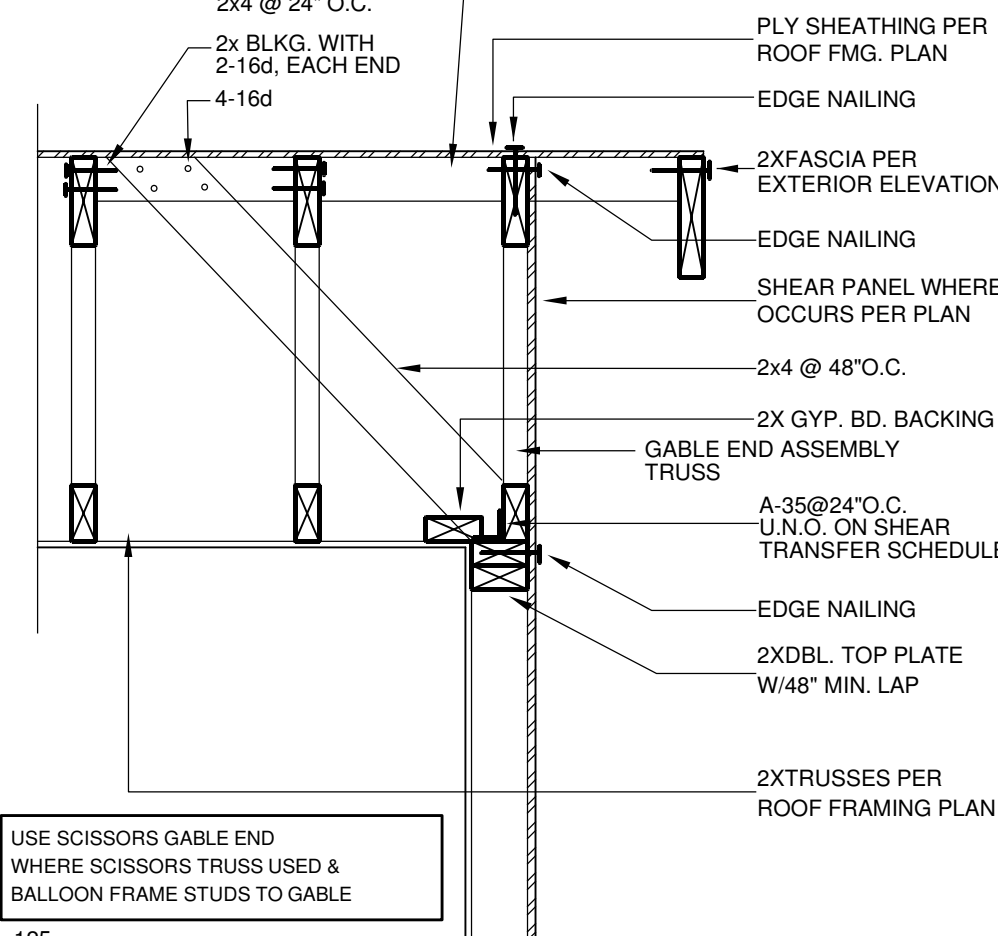


10 SHEAR TRANSFER

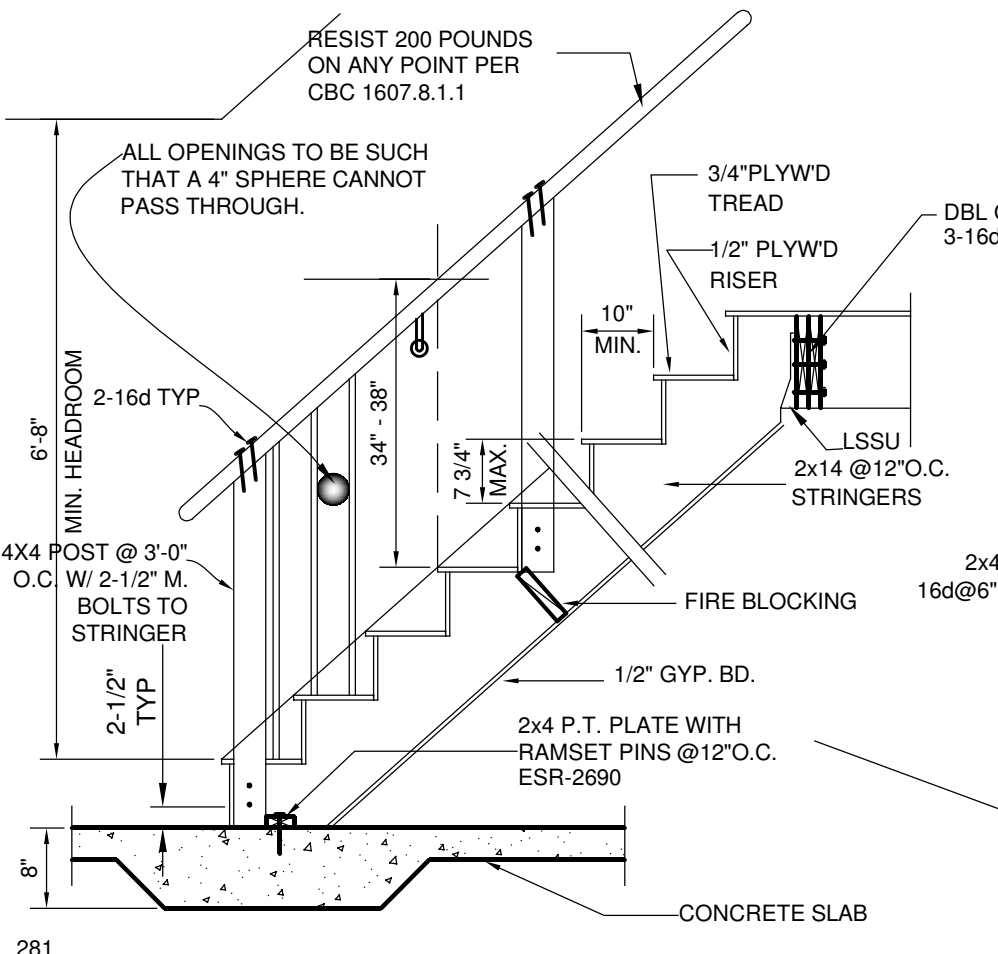


9 STAIR SECTION

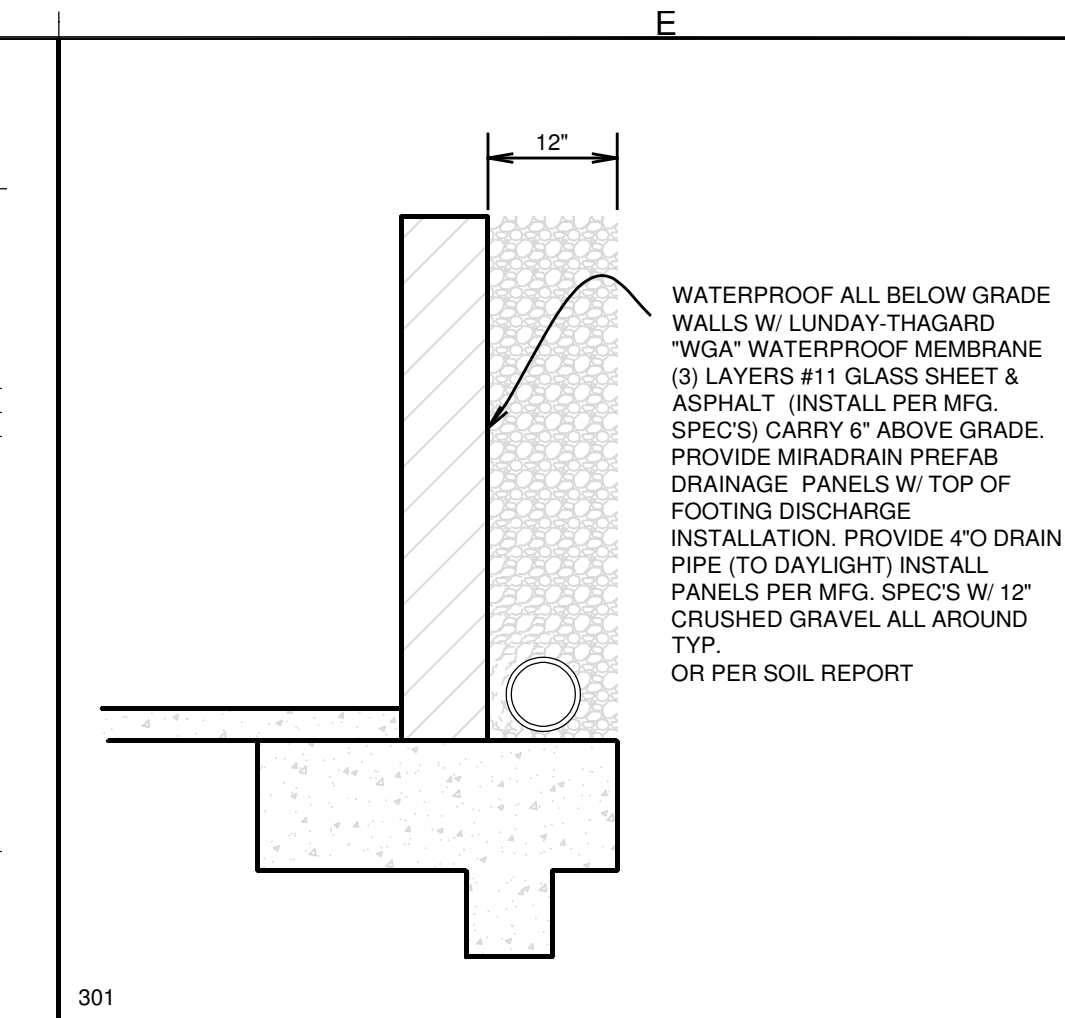


8 WATERPROOFING

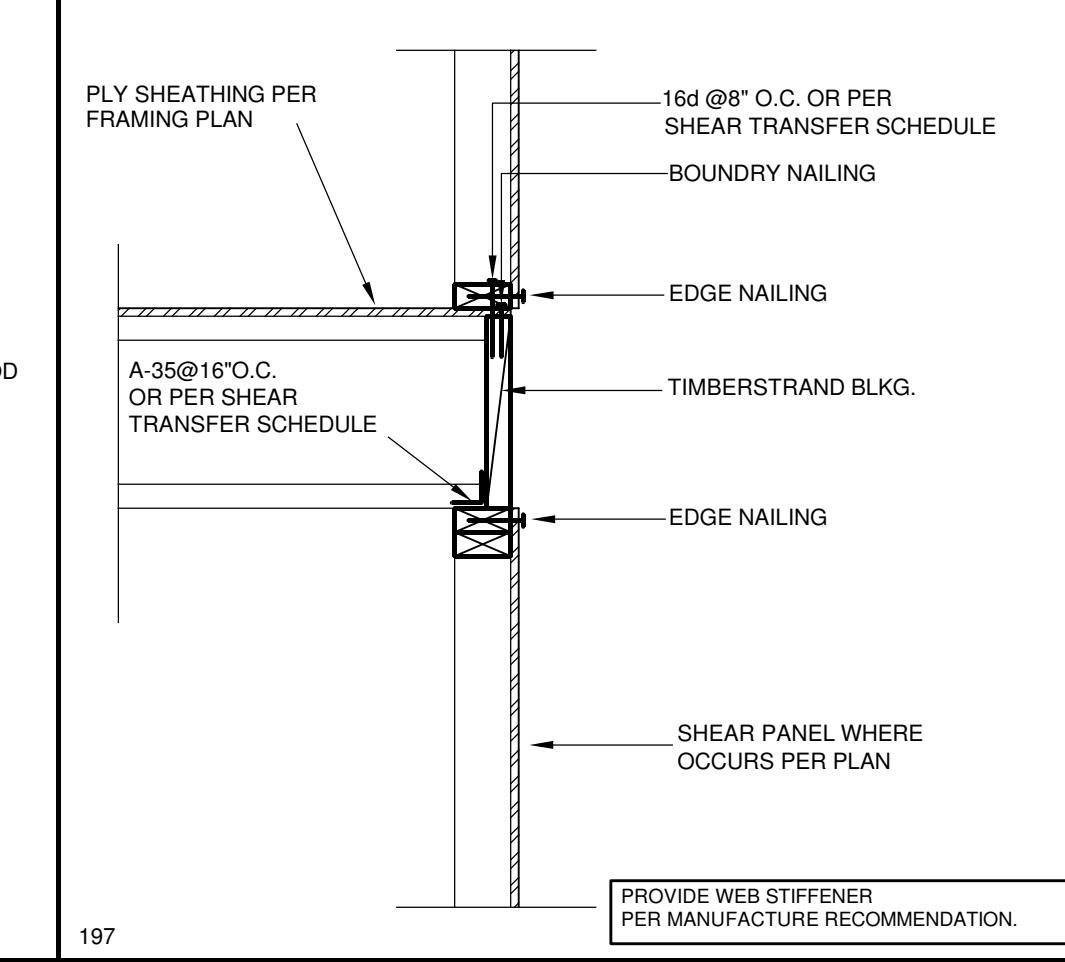


7 SHEAR TRANSFER

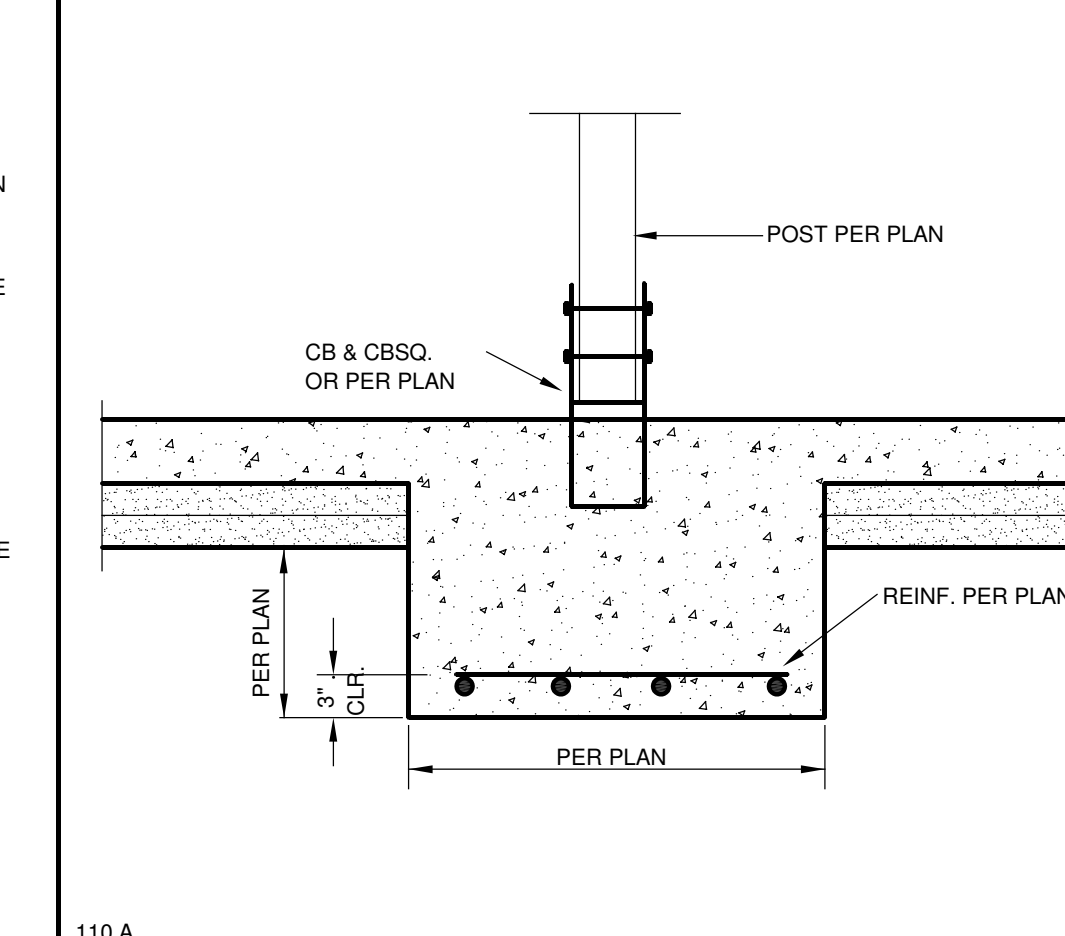


6 POST TO FOOTING

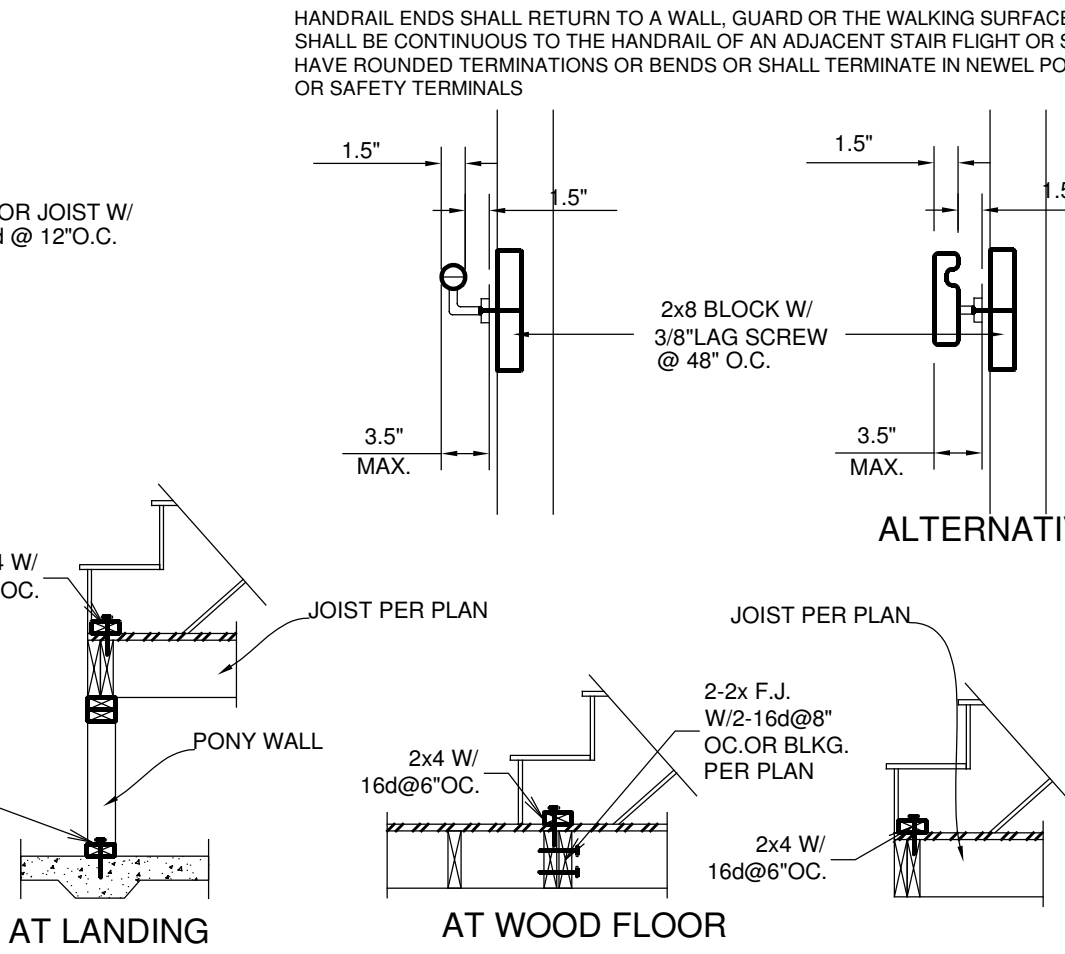


HANDRAIL DETAIL

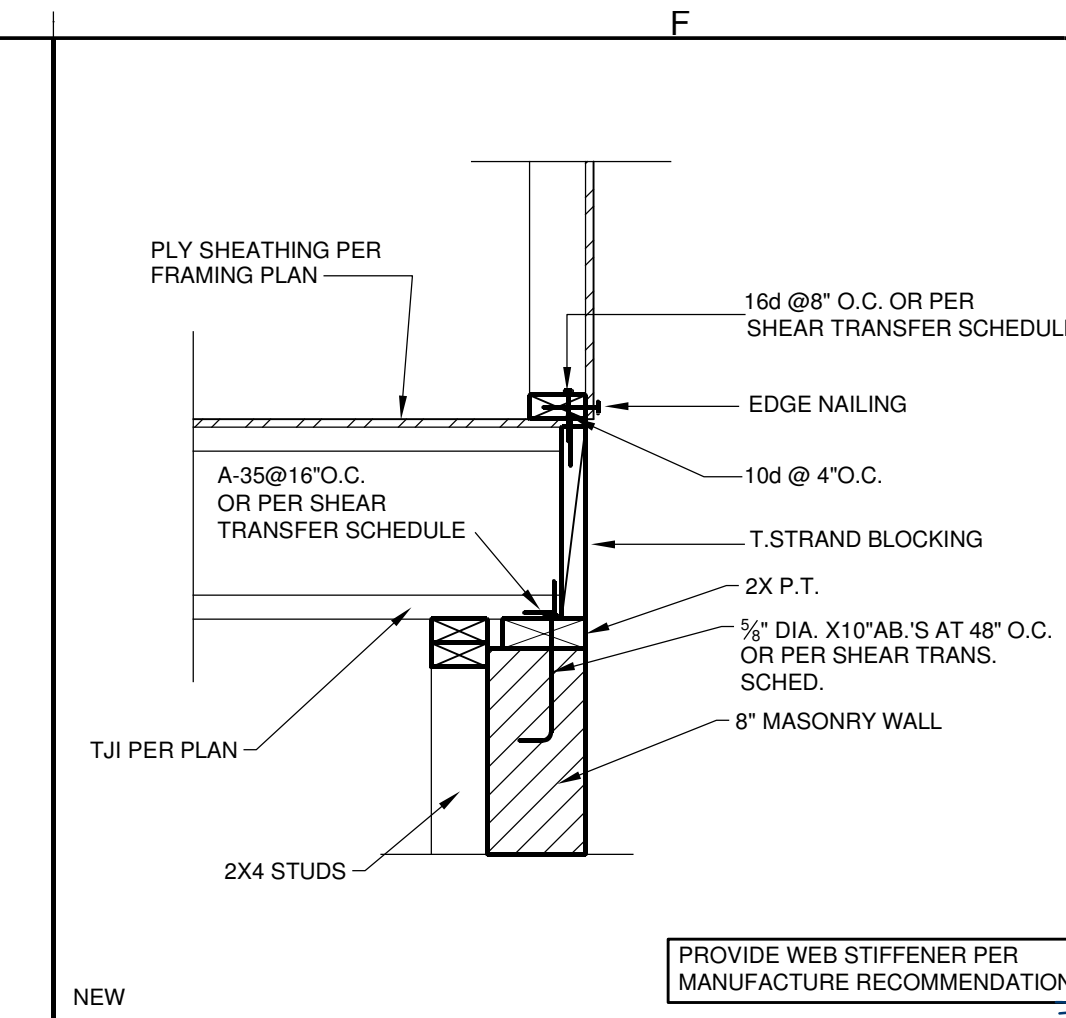


4 SHEAR TRANSFER

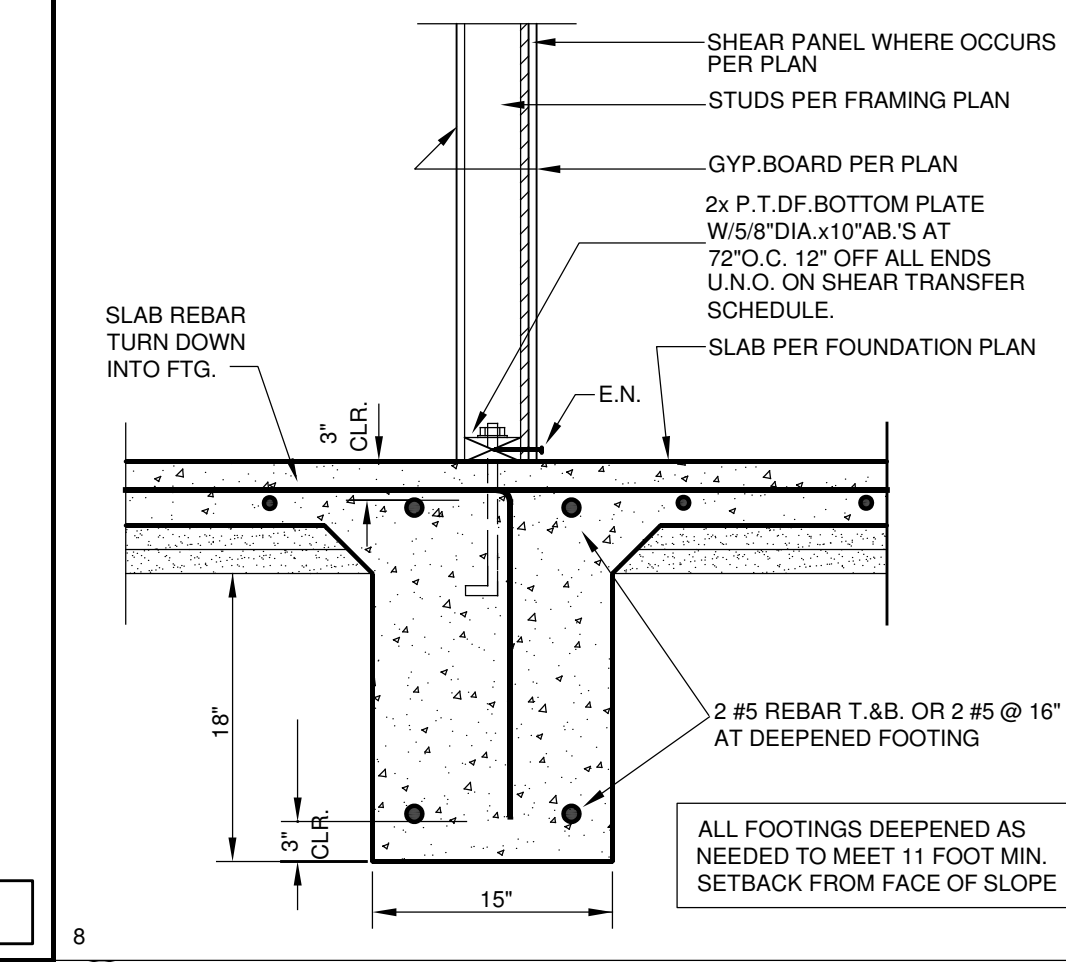

3 INTERIOR FOOTING

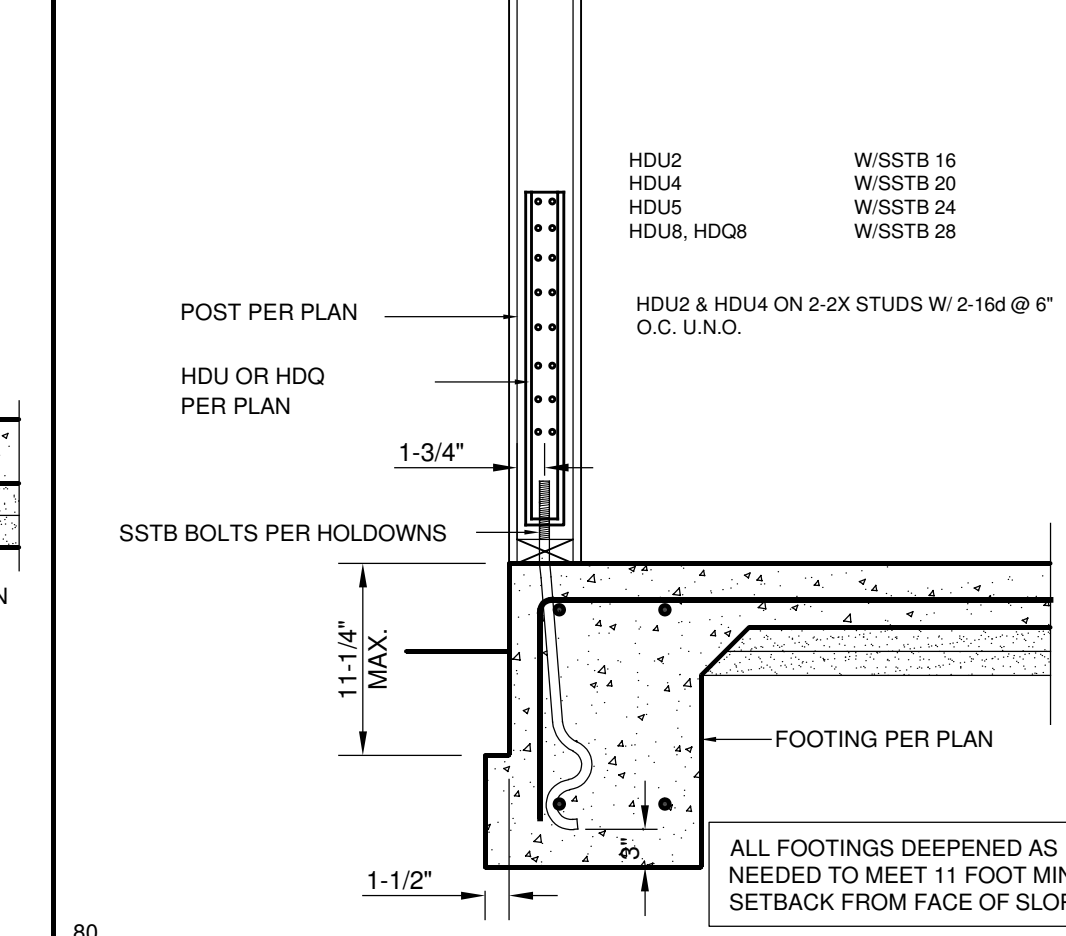

2 HOLDOWN DETAIL

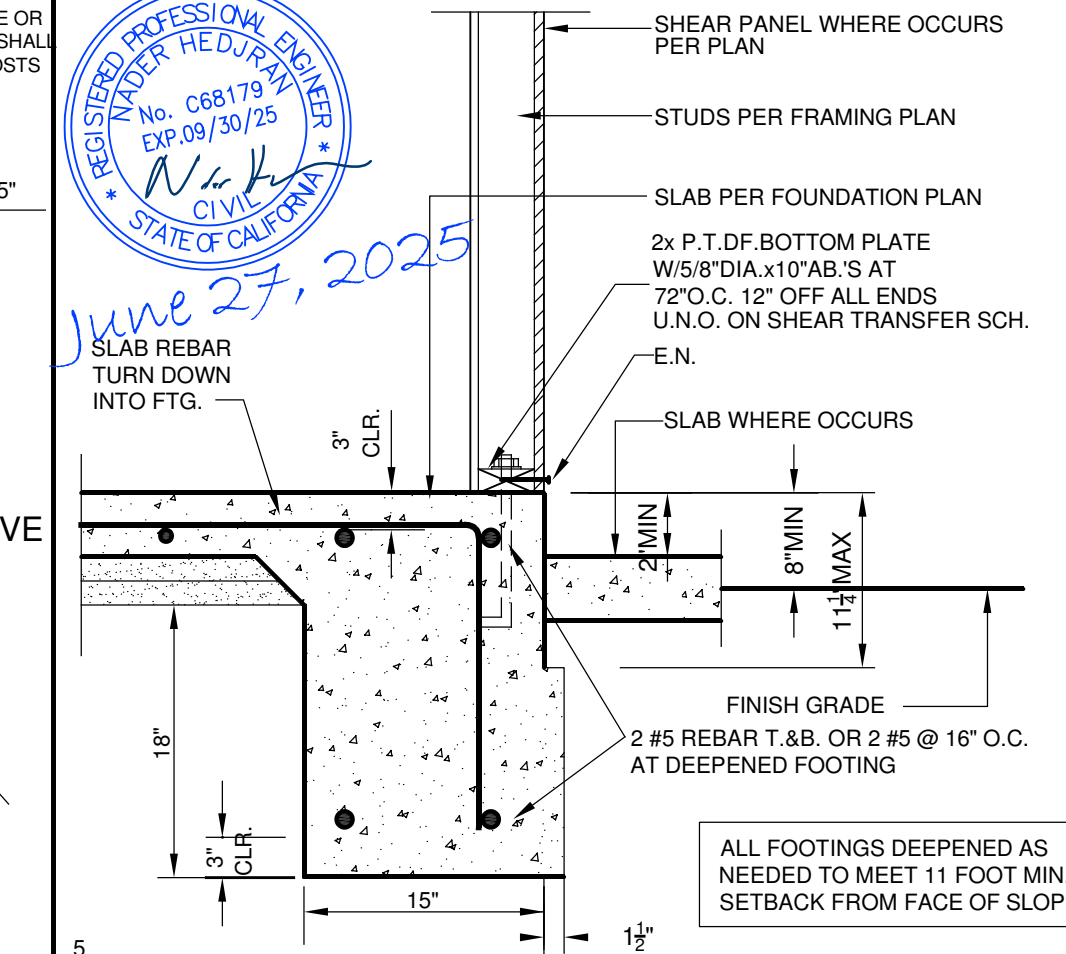

1 EXTERIOR FOOTING

GENERAL:

1. THE CONTRACTOR SHALL ASSUME SOLE AND COMPLETE RESPONSIBILITY FOR THE JOB SITE CONDITIONS DURING THE COURSE OF CONSTRUCTION, INCLUDING THE SAFETY OF ALL PERSONS AND PROPERTY, AND THIS REQUIREMENT SHALL APPLY CONTINUOUSLY AND NOT BE LIMITED TO NORMAL WORKING HOURS.
2. THE CONTRACTOR SHALL BE RESPONSIBLE FOR ALL MEANS AND METHODS OF CONSTRUCTION INCLUDING, BUT NOT LIMITED TO, SHORING, BRACING, TEMPORARY EXCAVATIONS, AND SHALL BE IN ACCORDANCE WITH ALL STATE AND FEDERAL SAFETY REQUIREMENTS.
3. THE CONTRACTOR SHALL VERIFY ALL DIMENSIONS, ELEVATIONS, AND SITE CONDITIONS BEFORE STARTING WORK AND NOTIFY THE ARCHITECT AND ENGINEER IMMEDIATELY OF ANY DISCREPANCIES.
4. ALL OMISSIONS AND CONFLICTS BETWEEN VARIOUS ELEMENTS OF WORKING DRAWINGS AND/OR SPECIFICATIONS SHALL BE BROUGHT TO THE ATTENTION OF THE ARCHITECT AND ENGINEER BEFORE PROCEEDING WITH ANY INVOLVED WORK.
5. RESOLVE ANY CONFLICTS ON THE DRAWINGS WITH THE ARCHITECT AND ENGINEER BEFORE PROCEEDING WITH CONSTRUCTION.
6. THE CONTRACTOR SHALL DETERMINE THE LOCATION OF UTILITY SERVICES IN THE AREA TO BE EXCAVATED PRIOR TO BEGINNING EXCAVATIONS.
7. NO PIPES, DUCTS, SLEEVES, CHASES, ETC. SHALL BE PLACED IN SLABS, BEAMS OR WALLS UNLESS SPECIFICALLY SHOWN OR NOTED. NOR SHALL ANY STRUCTURAL MEMBER BE CUT FOR PIPES, DUCTS OR OTHER ITEMS UNLESS OTHERWISE NOTED. CONTRACTOR SHALL OBTAIN PRIOR APPROVAL FOR INSTALLATION OF ANY ADDITIONAL PIPES, DUCTS OR OTHER ITEMS. REFER TO ARCHITECTURAL OR MECHANICAL DRAWINGS FOR LOCATIONS.
8. ALL MATERIAL AND WORKMANSHIP SHALL CONFORM TO REQUIREMENTS OF LATEST EDITION OF THE CALIFORNIA BUILDING CODE (CBC AND CRC).
9. SPECIAL INSPECTION PER SEC. 1701 OF THE CBC IS REQUIRED AS SHOWN ON PLANS.
10. DESIGN BASED ON 2022 EDITION OF CBC AND 2022 CRC.
11. SEISMIC BASE SHEAR COEFFICIENT PER CALCULATIONS.
12. BASIC WIND SPEED = 96 MPH, 3 SEC. GUST FACTOR EXPOSURE "B" (U.N.O.)

REINFORCEMENT STEEL

1. BAR REINFORCING STEEL SHALL BE DEFORMED AND CONFIRM TO ASTM A 615 GRADE 40, FOR UP TO #4 BARS AND GRADE 60 #5 BARS AND LARGER.
2. ALL WELDED REBAR TO BE A706.
3. WELDING OF REINFORCING STEEL SHALL CONFORM TO AWS D1.4.
4. WELDED WIRE FABRIC SHALL CONFORM TO ASTM A185.
5. REINFORCEMENT DETAILING, BENDINGS AND PLACING SHALL BE IN ACCORDANCE WITH CONCRETE REINFORCING STEEL INSTITUTE MANUAL, OR STANDARD PRACTICE LATEST EDITION.
6. LAPS AND BAR SPLICES SHALL BE: 36 BAR DIAMETER OR 18" MINIMUM FOR CONCRETE; AND 40 BAR DIAMETER OR 24" MINIMUM FOR MASONRY UNLESS OTHERWISE NOTED.
7. VERTICAL BARS IN WALL SHALL BE ACCURATELY POSITIONED AT THE CENTER WALL, UNLESS OTHERWISE NOTED ON DETAILS AND SHALL BE TIED IN POSITION AT TOP AND BOTTOM AND AT INTERVALS NOT EXCEEDING 192 DIAMETERS.
8. REINFORCING STEEL SHALL BE PROVIDED WITH THE FOLLOWING AMOUNT: FOOTINGS (CONCRETE DEPOSIT) 1.00% MINIMUM; CONCRETE SURFACE (FORMED) EXPOSED TO EARTH OR WEATHER—2" COLUMN REINFORCEMENT (INCLUDING COLUMN TIES)—1 1/2" BEAMS AND GIRDS—1 1/2" SLAB (NO. 11 OR SMALLER)—1 1/2" GIRDS.
9. ALL REINFORCING STEEL, ANCHOR BOLTS, DOWELS, AND INSERTS SHALL BE WELL SECURED IN POSITION PRIOR TO PLACING CONCRETE OR GROUT UO. UNLESS OTHERWISE NOTED IN DETAILS, FURNISH NO. 3 SPACER TIES AT APPROX. 2'-6" ON CENTER ON ALL BEAMS AND FOOTINGS TO SECURE REINFORCING IN PLACE.

STRUCTURAL STEEL:

1. STRUCTURAL STEEL SHALL COMPLY WITH A.S.T.M. A36 (FY=36KSI), EXCEPT W SHAPES, MOMENT FRAME, A.S.T.M. A992, (FY=50 KSI)
2. MATERIALS AND WORKMANSHIP SHALL COMPLY WITH A.I.S.C. SPECIFICATIONS FOR THE DESIGN, FABRICATION, AND ERECTION OF STRUCTURAL STEEL FOR BUILDINGS.
3. PIPE COLUMNS SHALL COMPLY WITH A.S.T.M. A53 (FY=36KSI).
4. TUBE COLUMNS SHALL COMPLY WITH A.S.T.M. A500, GRADE "B" (FY=48KSI).
5. MACHINE BOLTS SHALL COMPLY WITH A.S.T.M. A307, GRADE "A" UNLESS OTHERWISE NOTED.
6. ANCHOR BOLTS SHALL COMPLY WITH A.S.T.M. A307 GRADE "A", UNLESS OTHERWISE NOTED.
7. SHEAR STUDS SHALL BE FIELD WELDED.
8. ALL WELDING SHALL BE BY THE SHIELDED ARC PROCESS. USE E-70XX ELECTRODES.
9. ALL WELDING SHALL BE PERFORMED BY CERTIFIED WELDERS AND SHALL CONFORM TO A.I.S.C. D1.1 STRUCTURAL WELDING CODE.
10. STRUCTURAL FIELD WELDING SHALL HAVE SPECIAL INSPECTIONS AS REQUIRED BY THE LOCAL JURISDICTION HAVING PRECEDENCE.
11. ALL STRUCTURAL STEEL EXPOSED TO EARTH SHALL HAVE 3" CONCRETE COVER U.O.N.

STRUCTURAL WOOD:

1. FASTENER REQUIREMENTS, THE NUMBER, SIZE, AND SPACING OF FASTENERS CONNECTING WOOD MEMBERS/ELEMENTS SHALL NOT BE LESS THAN THAT SET FORTH IN CRC TABLE R602.3(1), (CRC R502.9, CRC R602.3, AND CRC R602.2)
2. ALL FRAMING SHALL BE GRADED D.F. OR LARCH MARKED AS FOLLOWS, UNLESS OTHERWISE NOTED. LIGHT FRAMING- "STANDARD" AND "STUD": STUDS: (8" & SHORTER) STUD GRADE OR BETTER STUDS: (OVER 8") DOUGLAS FIR #2 U.O.N. JOIST: DOUGLAS FIR #2 U.O.N. DOUGLAS FIR #1 U.O.N. 4X BEAM: DOUGLAS FIR #1 U.O.N. 6X UP BEAM: DOUGLAS FIR #1 U.O.N. LEDGERS AND TOP PLATE: DOUGLAS FIR #2 U.O.N.
3. STUD SIZE, HEIGHT, AND SPACING, THE SIZE, HEIGHT, AND SPACING OF STUDS SHALL BE IN ACCORDANCE WITH CRC TABLE R602.3(5), (CRC R602.3.1)
4. SILL PLATES ON CONCRETE SHALL BE DOUGLAS FIR, PRESSURE TREATED WITH MIN. 50# DIA. X 10" ANCHOR BOLTS @ 4' MAX AND 9" FROM END OF BOARD (OR AS SPECIFIED ON PLANS).
5. SILL PLATE: STUDS SHALL HAVE FULL BEARING ON NOMINAL 2-INCH THICK OR LARGER SILL PLATE WITH STUD AT LEAST EQUAL TO STUD WIDTH.
6. TOP PLATES OF ALL WIDTH SHALL BE DOUBLED, SAME SIZE AS STUDS, LAP PLATES 4'-0" MIN. WITH AT LEAST 16-16D NAILS AT 4" MAX. O.C. EACH SIDE UO.
7. SOLID BLOCK STUDS AT 10" VERTICAL INTERVALS.
8. DRILLING AND NOTCHING OF STUDS. ANY STUD IN AN EXTERIOR WALL OR BEARING PARTITION MAY BE CUT OR NOTCHED TO A DEPTH NOT EXCEEDING 25% OF ITS WIDTH. STUDS IN NON-BEARING PARTITIONS MAY BE NOTCHED TO A DEPTH NOT TO EXCEED 40% OF A SINGLE STUD WIDTH. ANY STUD MAY BE BORED OR DRILLED PROVIDED THE DIAMETER OF THE RESULTING HOLE IS NO MORE THAN 60% OF THE STUD WIDTH, THE EDGE OF THE HOLE IS NO MORE THAN 5/8 INCH TO THE EDGE OF THE STUD, AND THE HOLE IS NOT LOCATED IN THE SAME SECTION AS A CUT OR NOTCH. STUDS LOCATED IN EXTERIOR WALL OR BEARING PARTITIONS DRILLED OVER 40% AND UP TO 60% SHALL ALSO BE DOUBLED WITH NO MORE THAN TWO SUCCESSIVE STUDS BORED.
9. DRILLING AND NOTCHING OF TOP PLATE. WHEN PIPING OR DUCTWORK IS PLACED IN OR PARTLY IN AN EXTERIOR WALL OR INTERIOR LOAD-BEARING WALL, NECESSITATING CUTTING, DRILLING, OR NOTCHING OF THE TOP PLATE BY MORE THAN 50% OF ITS WIDTH, A GALVANIZED METAL TIE NOT LESS THAN 1/4-INCH THICK AND 1-1/2-INCHES WIDE SHALL BE FASTENED ACROSS AND TO THE PLATE AT EACH SIDE OF THE OPENING WITH NOT LESS THAN 8 10D NAILS HAVING A MINIMUM LENGTH OF 1-1/2 INCHES AT EACH SIDE OR EQUIVALENT. THE METAL TIE MUST EXTEND MINIMUM 6 INCHES PAST THE OPENING.
10. CRIPPLE WALLS: FOUNDATION CRIPPLE WALLS SHALL BE FRAMED OF STUDS NOT LESS IN SIZE THAN THE STUDING ABOVE. CRIPPLE WALLS MORE THAN 4 FEET IN HEIGHT SHALL HAVE STUDS SIZED AS REQUIRED FOR AN ADDITIONAL STORY. CRIPPLE WALLS WITH STUD HEIGHT LESS THAN 4 INCHES SHALL BE SHEATHED ON AT LEAST ONE SIDE WITH A WOOD STRUCTURAL PANEL FASTENED TO BOTH THE TOP AND BOTTOM PLATES IN ACCORDANCE WITH TABLE R602.3(1), OR THE CRIPPLE WALLS SHALL BE CONSTRUCTED OF SOLID BLOCKING. CRIPPLE WALLS SHALL BE SUPPORTED ON CONTINUOUS FOUNDATIONS.
11. SHEAR WALL JOINTS. ALL VERTICAL JOINTS IN SHEAR WALL SHEATHING SHALL OCCUR OVER, AND BE FASTENED TO, COMMON STUDS. HORIZONTAL JOINTS IN SHEAR WALLS SHALL OCCUR OVER, AND BE FASTENED TO, MINIMUM 1-1/2-INCH THICK BLOCKING.
12. JOISTS UNDER BEARING PARTITIONS. JOISTS UNDER PARALLEL BEARING PARTITIONS SHALL BE OF ADEQUATE SIZE TO SUPPORT THE LOAD. DOUBLE JOISTS, WHEN USED TO ADEQUATELY SUPPORT THE LOAD, THAT ARE SEPARATED TO PERMIT THE INSTALLATION OF PIPING OR VENTS SHALL BE FULL-DEPTH SOLID-BLOCKED WITH MINIMUM 2-INCH NOMINAL LUMBER SPACED AT MAXIMUM 4 FEET ON CENTER. BEARING PARTITIONS PERPENDICULAR TO JOISTS SHALL NOT BE SUPPORTED BY SUPPORTING GIRDERS, WALLS OR PARTITIONS MORE THAN THE JOIST DEPTH UNLESS SUCH JOISTS ARE OF SUFFICIENT SIZE TO CARRY THE ADDITIONAL LOAD.
13. JOISTS ABOVE OR BELOW SHEAR WALLS. WHERE JOISTS ARE PERPENDICULAR TO A SHEAR WALL ABOVE OR BELOW A RIM JOIST, BAND JOIST, OR FRAMING SHALL BE PROVIDED ALONG THE ENTIRE LENGTH OF THE SHEAR WALL, WHERE JOISTS ARE PARALLEL TO A SHEAR WALL ABOVE OR BELOW A RIM JOIST, END JOIST, OR OTHER PARALLEL FRAMING SHALL BE PROVIDED DIRECTLY ABOVE AND/OR BELOW THE SHEAR WALL, WHERE A PARALLEL FRAMING MEMBER CANNOT BE LOCATED DIRECTLY ABOVE OR BELOW THE SHEAR WALL, FULL-DEPTH BLOCKING AT 16-INCH SPACING SHALL BE PROVIDED BETWEEN THE PARALLEL FRAMING MEMBERS TO EACH SIDE OF THE SHEAR WALL.
14. FLOOR MEMBER BEARING. THE ENDS OF EACH RAFTER OR BEAM, OR GIRDER SHALL HAVE MINIMUM 1-1/2 INCHES OF BEARING ON WOOD OR METAL, AND MINIMUM 3 INCHES OF BEARING ON MASONRY OR CONCRETE EXCEPT WHERE SUPPORTED ON A 1-INCH-BY-4-INCH REBORN STRIP AND NAILED TO THE ADJOINING STUD OR BY THE USE OF APPROVED JOIST HANGERS.
15. FLOOR JOIST LAP. FLOOR JOISTS FRAMING OPPOSITE SIDES OVER A BEARING SUPPORT SHALL LAP MINIMUM 3 INCHES AND SHALL BE NAILED TO THE BEARING SUPPORT AS FOLLOWS: FACE NAILS: A WOOD OR METAL SPLICE WITH STRENGTH EQUAL TO OR GREATER THAN THAT PROVIDED BY THE LAP IS PERMITTED.
16. FLOOR JOIST TO GIRDER SUPPORT. FLOOR JOISTS FRAMING INTO THE SIDE OF A WOOD GIRDER SHALL BE SUPPORTED BY APPROVED FRAMING ANCHORS OR ON LEDGER STRIPS MINIMUM NOMINAL 2 INCHES BY 2 INCHES.
17. FLOOR JOIST LATERAL RESTRAINT. FLOOR JOISTS SHALL BE SUPPORTED Laterally AT ENDS AND EACH INTERMEDIATE SUPPORT BY MINIMUM 2-INCH FULL-DEPTH BLOCKING BY ATTACHMENT TO FULL-DEPTH HEADER, BAND JOIST, OR RIM JOIST TO AN ADJOINING STUD, OR, OR SHALL BE OTHERWISE PROVIDED WITH LATERAL SUPPORT TO PREVENT ROTATION.

REINFORCED CONCRETE

1. CEMENT SHALL CONFORM TO ASTM C-150, TYPE II.
2. AGGREGATE SHALL CONFORM TO ASTM C-33 FOR STRUCTURAL-NORMAL- WEIGHT CONCRETE (1" MAX. SIZE) AND ASTM C-330 FOR STRUCTURAL- LIGHT-WEIGHT CONCRETE.
3. READY MIX CONCRETE SHALL BE MIXED AND DELIVERED IN ACCORDANCE WITH ASTM C-94.
4. CONCRETE DESIGN MIXES SHALL BE IN ACCORDANCE WITH CHAP 19 OF CBC AND SHALL BE SIGNED BY A REGISTERED PROFESSIONAL ENGINEER REGISTERED IN THE STATE OF JURISDICTION.
5. ALL CONCRETE SHALL SATISFY BOTH A MINIMUM STRENGTH REQUIREMENT, AND MINIMUM CEMENT CONTENT. THE MINIMUM ULTIMATE COMPRESSIVE STRENGTH (FCI) AT 28 DAYS SHALL BE: 2500 PSI FOR SLAB FOOTING ON GRADE U.O.N. 4000 PSI FOR COLUMN BEAMS AND POST-TENSIONED SLAB U.O.N. THE MINIMUM CEMENT CONTENT PER CUBIC YARD OF CONCRETE SHALL BE: 5 1/4 SACKS FOR 2500 PSI STRENGTH 5 1/2 SACKS FOR 3000 PSI CONCRETE OR GREATER
6. THE MINIMUM CONCRETE SLUMP SHALL BE 3" +1" FOR A SLAB ON GRADE AND 4" +1" FOR ALL OTHER WORK, OR NOT MORE THAN 7-12 GALLONS OF WATER PER SACK OF CEMENT.
7. ADMIXTURES MAY BE USED WITH APPROVAL OF ENGINEERS. ADMIXTURES USED TO INCREASE THE WORKABILITY OF THE CONCRETE SHALL NOT BE CONSIDERED TO REDUCE THE SPECIFIED MINIMUM CEMENT CONTENT.
8. REFER TO AND VERIFY WITH ARCHITECTURAL DRAWINGS ANY MOLDS, GROOVES, REVEALS AND SCUPPERS, ORNAMENTS, CLIP OR TEXTURE REQUIRED TO BE CAST INTO CONCRETE AND FOR LOCATION AND EXTENT OF DEPRESSIONS, CURBS AND RAMPS.
9. PROJECTING CORNERS OF SLABS, BEAMS, WALLS, COLUMNS, ETC. SHALL BE FORMED WITH A 3/4" CHAMFER UNLESS OTHERWISE NOTED.
10. CONCRETE FORM TOLERANCES SHALL BE WITHIN STANDARDS SET BY AMERICAN CONCRETE INSTITUTE.
11. ALL REINFORCEMENT STEEL, ANCHOR BOLTS, DOWELS, AND OTHER INSERTS SHALL BE SECURED IN POSITION AND INSPECTED BY THE LOCAL BUILDING DEPARTMENT INSPECTOR PRIOR TO POURING OF CONCRETE.
12. LOCATION OF ALL CONSTRUCTION JOINTS NOT SPECIFICALLY INDICATED ON THE DRAWINGS SHALL BE APPROVED BY ENGINEER PRIOR TO PLACING REINFORCING STEEL.

18. FLOOR JOIST BRIDGING. FLOOR JOISTS EXCEEDING NOMINAL 2 INCHES BY 12 INCHES SHALL BE SUPPORTED Laterally BY SOLID BLOCKING, DIAGONAL BRIDGING (WOOD OR METAL), OR A CONTINUOUS 1-INCH-BY-3-INCH STRIP NAILED ACROSS THE BOTTOM OF JOISTS PERPENDICULAR TO JOISTS AT MAXIMUM 8-FOOT INTERVALS.
19. GIRDERS. GIRDERS FOR SINGLE-STORY CONSTRUCTION OR GIRDERS SUPPORTING LOADS FROM A SINGLE FLOOR SHALL NOT BE LESS THAN 4 INCHES BY 8 INCHES FOR SPANS 6 FEET OR LESS, PROVIDED THAT THE GIRDERS ARE NOT MORE THAN 16 FEET ON CENTER. OTHER GIRDERS SHALL BE DESIGNED TO SUPPORT THE LOADS SPECIFIED IN THE CBC. GIRDER END JOINTS SHALL OCCUR OVER SUPPORTS. WHEN A GIRDER IS SPLICED OVER A SUPPORT, AN ADEQUATE TIE SHALL BE PROVIDED. THE ENDS OF BEAMS OR GIRDERS SUPPORTED ON MASONRY OR CONCRETE SHALL NOT HAVE LESS THAN 3 INCHES OF BEARING.
20. RIDGES, HIPS, AND VALLEYS. RAFTERS SHALL BE FRAMED TO A RIDGE BOARD OR TO TO EACH OTHER WITH A GUSSET PLATE AS A TIE. RIDGE BOARDS SHALL BE MINIMUM 1-INCH NOMINAL THICKNESS AND NOT LESS IN DEPTH THAN THE CUT END OF THE RAFTER. AT ALL VALLEY AND HIPS, THERE SHALL BE A VALLEY OR HIP RAFTER NOT LESS THAN 2-INCH NOMINAL THICKNESS AND NOT LESS IN DEPTH THAN THE CUT END OF THE RAFTER. HIP AND VALLEY RAFTERS SHALL BE SUPPORTED AT THE RIDGE BY A BRACE TO A BEARING PARTITION OR BE DESIGNED TO CARRY THE SPECIFIED LOAD AT THAT POINT, WHERE THE ROOF PITCH IS LESS THAN 3:12 SLOPE (25% GRADE), STRUCTURAL MEMBERS THAT SUPPORT RAFTERS AND CEILING JOISTS, SUCH AS RIDGES, HIPS, AND VALLEYS, SHALL BE DESIGNED AS BEAMS.

21. CEILING JOIST AND RAFTER CONNECTIONS. CEILING JOISTS AND RAFTERS SHALL BE NAILED TO EACH OTHER PER CRC TABLE R602.5 (10), AND THE RAFTER SHALL BE NAILED TO THE WALL TOP PLATE PER CRC TABLE R602.3(1). CEILING JOISTS SHALL BE CONTINUOUS OR SECURELY JOINED PER CRC TABLE R602.5 (19) WHERE THEY MEET OVER INTERIOR PARTITIONS AND ARE NAILED TO ADJACENT RAFTERS TO PROVIDE A CONTINUOUS TIE ACROSS THE BUILDING WHEN SUCH JOISTS ARE PARALLEL TO RAFTERS WHERE CEILING JOISTS ARE NOT CONNECTED TO THE RAFTERS AT THE WALL TOP PLATE, JOISTS CONNECTED HIGHER IN THE ATTIC SHALL BE INSTALLED AS RAFTER TIES, OR RAFTER TIES SHALL BE INSTALLED TO PROVIDE A CONTINUOUS TIE. WHERE CEILING JOISTS ARE NOT PARALLEL TO RAFTERS, RAFTER TIES SHALL BE INSTALLED. RAFTER TIES SHALL BE MINIMUM 2 INCHES BY 4 INCHES NOMINAL, INSTALLED PER CRC TABLE R602.5 (19), OR CONNECTIONS OF EQUIVALENT CAPACITIES SHALL BE PROVIDED. WHERE CEILING JOISTS OR RAFTER TIES ARE NOT PROVIDED, THE FORM FORMED BY THESE RAFTERS SHALL BE SUPPORTED BY A WALL OR ENGINEER-DESIGNED GIRDER.

22. CEILING JOISTS LAPPED. ENDS OF CEILING JOISTS SHALL BE LAPPED MINIMUM 3 INCHES OR BUTTED OVER BEARING PARTITIONS OR BEAMS AND TIE-NAILED TO THE BEARING ELEMENT. WHERE CEILING JOISTS PROVIDE RESISTANCE TO RAFTER THRUST, LAPPED JOISTS SHALL BE NAILED TOGETHER PER CRC TABLE R602.3(1) AND BUTTED JOISTS SHALL BE TIED TOGETHER IN A MANNER TO RESIST SUCH THRUST.

23. COLLAR TIES. COLLAR TIES OR RIDGE STRAPS TO RESIST WIND UPLIFT SHALL BE CONNECTED IN THE UPPER THIRD OF THE ATTIC SPACE. COLLAR TIES SHAL BE MINIMUM 1 INCH BY 4 INCHES NOMINAL AND SPACED AT MAXIMUM 4 FEET ON CENTER.

24. PURLINS. PURLINS INSTALLED TO REDUCE THE SPAN OF RAFTERS SHALL BE SIZED NOT LESS THAN THE REQUIRED SIZE FOR THE RAFTERS THEY SUPPORT. PURLINS SHALL BE CONTINUOUS AND SHALL BE SUPPORTED BY 2-INCH-BY-4-INCH NOMINAL BRACES INSTALLED TO BEARING WALLS AT A MINIMUM 45-DEGREE SLOPE FROM HORIZONTAL. THE BRACES SHALL BE SPACED MAXIMUM 4 FEET ON CENTER WITH A MAXIMUM 8-FOOT UNBRACED LENGTH.

25. ROOF/CEILING MEMBER BEARING. THE ENDS OF EACH RAFTER OR CEILING JOIST SHALL HAVE NOT LESS THAN 1-1/2 INCHES OF BEARING ON WOOD OR METAL AND NOT LESS THAN 3 INCHES OF BEARING ON MASONRY OR CONCRETE.

26. ROOF/CEILING MEMBER LATERAL SUPPORT. ROOF FRAMING MEMBERS AND CEILING JOISTS WITH A NOMINAL DEPTH-TO-THICKNESS RATIO EXCEEDING 5:1 SHALL BE PROVIDED WITH LATERAL SUPPORT AT POINTS OF BEARING TO PREVENT ROTATION.

27. ROOF/CEILING BRIDGING. RAFTERS AND CEILING JOISTS WITH A NOMINAL DEPTH-TO-THICKNESS RATIO EXCEEDING 6:1 SHALL BE SUPPORTED Laterally BY SOLID BLOCKING, DIAGONAL BRIDGING (WOOD OR METAL), OR A CONTINUOUS 1-INCH-BY-3-INCH WOOD STRIP NAILED ACROSS THE RAFTERS OR CEILING JOISTS AT MAXIMUM 8-FOOT INTERVALS.

28. ROOF FRAMING ABOVE SHEAR WALLS. RAFTERS OR ROOF TRUSSES SHALL BE CONNECTED TO TOP PLATES OF SHEAR WALLS WITH BLOCKING BETWEEN THE RAFTERS OR TRUSSES.

29. ROOF DIAPHRAGM UNDER FILL FRAMING. ROOF PLYWOOD SHALL BE CONTINUOUS UNDER CALIFORNIA FILL FRAMING.

30. ROOF DIAPHRAGM AT RIDGES. MINIMUM 2-INCH NOMINAL BLOCKING REQUIRED FOR ROOF DIAPHRAGM NAILING AT RIDGES.

31. BLOCKING OF ROOF TRUSSES. MINIMUM 2-INCH NOMINAL BLOCKING REQUIRED BETWEEN TRUSSES AT RIDGE LINES AND AT POINTS OF BEARING AT EXTERIOR WALLS.

32. TRUSS CLEARANCE. MINIMUM 1/2-INCH CLEARANCE REQUIRED BETWEEN TOP PLATES OF INTERIOR NON-BEARING PARTITIONS AND BOTTOM CHORDS OF TRUSSES.

33. DRILLING, CUTTING, AND NOTCHING OF ROOF/FLOOR FRAMING. NOTCHES IN SLOTH LUMBER JOISTS, RAFTERS, BLOCKING, AND BEAMS SHALL NOT EXCEED ONE-SIXTH THE MEMBER DEPTH. SHALL BE NOT LONGER THAN ONE-FOURTH THE MEMBER DEPTH. SHALL NOT BE LOCATED IN THE MIDDLE ONE-THIRD OF THE SPAN. NOTCHES AT MEMBER ENDS SHALL NOT EXCEED ONE-FOURTH THE MEMBER DEPTH. THE TENSION SIDE OF MEMBERS 4 INCHES OR GREATER IN NOMINAL THICKNESS SHALL NOT BE NOTCHED EXCEPT AT MEMBER ENDS. THE DIAMETER OF HOLES BORED OR CUT INTO MEMBER SHALL NOT EXCEED ONE-THIRD THE MEMBER DEPTH. HOLES SHALL NOT BE CLOSER THAN 2 INCHES TO THE TOP OR BOTTOM OF THE MEMBER OR TO ANY OTHER HOLE LOCATED IN THE MEMBER. WHERE THE MEMBER IS ALSO NOTCHED, THE HOLE SHALL NOT BE CLOSER THAN 2 INCHES TO THE NOTCH.

34. DO NOT CUT, NOTCH, BORE, SHAVE, TAPER OR FOR ANY REASON MODIFY PRE-ENGINEERED / MANUFACTURED STRUCTURAL ELEMENTS SUCH AS GLUED LAMINATED MEMBERS, PARALLAMS, MICROLAMs, JOISTS, LIGHT GAUGE METAL MEMBERS AND OTHER SIMILAR TIMBER OR STEEL PRODUCTS UNLESS SUCH MODIFICATIONS ARE WITHIN THE WRITTEN PARAMETERS SET FORTH BY THE MANUFACTURER OF THAT PRODUCT OR A LETTER OF CERTIFICATION FROM THE MANUFACTURER'S ENGINEER WITH DETAIL SIGNED AND STAMPED IS ISSUED AND AUTHORIZED BY THE PROJECT ENGINEER OF RECORD AND APPROVED BY THE CITY BUILDING OFFICIAL.

35. BOLTS SHALL HAVE 7 DIA. MIN. END DISTANCE AND 4 DIA. MIN. EDGE DIST. U.O.N.

36. ALL BOLTS SHALL BE FITTED WITH WASHERS. HOLES IN WOOD SHALL BE BORED WITH A BIT 1/32" TO 1/16" LARGER THAN THE BOLT DIAMETER.

37. CONNECTORS SHALL BE MANUFACTURED BY THE SIMPSON COMPANY. UNLESS ALTERNATE CONNECTORS HAVE BEEN APPROVED BY THE ENGINEER PRIOR TO CONSTRUCTION.

38. CUTTING, NOTCHING OR DRILLING OF BEAMS OR JOISTS TO BE PERMITTED ONLY AS DETAILED OR APPROVED BY THE ENGINEER.

39. PROVIDE STRAP TIE (FLUSH HEADERS TO TOP PLATES) ST-22 MIN.

40. SHOT PINS SECURING WOOD SILL PLATE TO CONCRETE AT NON-SHEAR WALL OR INTERIOR NON-BEARING WALLS SHALL BE AS SPECIFIED MIN. 140 DIA. BY 2 7/8" LONG PINS. W/6 FROM END OF SILL PLATES & 1 3/4" EDGE DISTANCE AND SPACING 32" O.C. MAX., WITH AT LEAST TWO PINS AT END OF PLATES AT 6' & 10' RESPECTIVELY (RAMJET REDHEAD 1524 SDB, 1524 SDPI PER ESR-2690)
41. ALL STUDS SHALL BE 2x4 MIN @ 16" O.C OR PANEL FACE GRAIN SHALL BE HORIZONTAL ACROSS FRAMING IF @ 24" O.C. (U.N.O.), PANEL EDGES BETWEEN STUDS SHALL BE SOLID BLOCKED (U.N.O.)
42. WHERE PLYWOOD SHEAR PANELS IS APPLIED TO BOTH SIDES OF A WALL & NAILS ARE LESS THAN 6" O.C. PANEL JOIST SHALL BE OFFSET ON DIFFERENT FRAMING MEMBERS OR STUDS AND SILL PLATES SHALL BE 3X AND NAILS SHALL BE STAGGERED.
43. SILL PLATES SHALL BE ON 3X MEMBER.

STRUCTURAL 1-JOISTS & MANUFACTURED LUMBER

1. MANUFACTURED JOISTS & LUMBER (MICROLAM [LVL], PARALLEL [PSL] AND TIMBERSTRAND [LSL]) BY "VEYERHEUSEL COMPANY" OR "BOISE ENGINEERED WOOD PRODUCTS"

2. DESIGN, FABRICATION AND ERECTION IN ACCORDANCE WITH THE LATEST EDITION ESR-1387 & ESR-1155 FOR "VEYERHEUSEL COMPANY" OR EDITION ESR-1336, 1040 FOR "BOISE ENGINEERED WOOD PRODUCTS"

PLYWOOD:

1. ALL PLYWOOD SHALL BE MIN C-2, INTERIOR SHEATHING, OR BETTER WITH EXTERIOR GRADE AND SHALL BEAR THE STAMP OF AN APPROVED TESTING AGENCY. COMPLY WITH DOC P51 OR P52
2. LAY PLYWOOD UP WITH FACE GRAIN PERPENDICULAR TO SUPPORT. (ON ROOFS WHERE PLYWOOD IS LAID UP WITH FACE GRAIN PARALLEL TO SUPPORTS, USE A MINIMUM OF 5-PLY PLYWOOD); STAGGER JOINTS, ALL NAILING TO BE COMMON NAILS.

WOOD SCREWS.

1. WHERE SCREWS ARE INDICATED FOR WOOD TO WOOD ATTACHMENTS, USE
4. SCREWS AT FLOOR SHEATHING SHALL BE #8 X 1 1/2" LONG OR (W/SLTL2125 PER ESR-5053) FOR SHEATHING LESS THAN 1" THICK. ALL FLOOR SHEATHING SHALL BE GLEUED TO JOISTS WITH AN APA AFG-01 QUALIFIED GLUE.

5. ALL PLYWOOD SHALL BE OF THE FOLLOWING NOMINAL THICKNESS, SPANINDEX RATIO AND SHALL BE ATTACHED AS FOLLOWS UNLESS NOTED OTHERWISE:
- USE THICKNESS SPANINDEX EDGE INTERMEDIATE

ROOF	1/2"	240	3216	8d @ 6" O.C.	8d @ 12" O.C.
FLOOR	5/8"	4220	10d @ 6" O.C.	10d @ 10" O.C.	

PREFABRICATED WOOD TRUSSES

1. PREFABRICATED WOOD TRUSSES SHALL BE DESIGNED TO SUPPORT SELF WEIGHT PLUS LIVE LOAD AND SUPERIMPOSED DEAD LOADS STATED IN STRUCTURAL CALCULATIONS OR AS NOTED ON PLANS. BRIDGING SIZE AND SPACING BY TRUSS MANUFACTURER UNLESS NOTED OTHERWISE.

2. EACH TRUSS SHALL BE LEGIBLE BRANDED, MARKED OR OTHERWISE HAVE PERMANENTLY AFFIXED THERE TO THE FOLLOWING INFORMATION LOCATED WITHIN 2 FEET OF THE CENTER OF THE SPAN ON THE FACE OF THE BOTTOM CHORD:

- A) IDENTITY OF THE COMPANY MANUFACTURING THE TRUSS.
B) THE DESIGN LOAD.
C) THE SPACING OF THE TRUSS.
3. TRUSSES SHALL BE DESIGNED AS REQUIRED TO SUPPORT MECHANICAL EQUIPMENT.

GLUE LAMINATED BEAMS

1. GLUE-LAMINATED BEAMS SHALL BE DOUGLAS FIR/LARCH COMBINATION "24F" U.N.O., MANUFACTURED IN ACCORDANCE WITH A.I.T.C. SPECIFICATION 117-84 AND SHALL BE INDUSTRIAL GRANDE APPEARANCE U.N.O.
2. A CERTIFICATE OF COMPLIANCE FOR GLUE-LAMINATED BEAMS MUST BE SUBMITTED TO THE BUILDING INSPECTION DEPARTMENT PRIOR TO INSTALLATION SHOW DRY OR WET SERVICE CONDITION.
3. MINIMUM ALLOWABLE JOINT STRESS FOR GLUE-LAMINATED BEAMS: FB=2400 P.S.I. FV=165 P.S.I. FC=650 P.S.I. E=1.8x10⁶ P.S.I.

SHOP DRAWINGS:

1. SHOP DRAWINGS SHALL BE SUBMITTED FOR ALL STRUCTURAL ITEMS IN ADDITION TO ITEMS REQUIRED BY ARCHITECTS SPECIFICATIONS.
2. THE CONTRACTOR SHALL REVIEW ALL SHOP DRAWINGS PRIOR TO SUBMITTAL. ITEMS NOT IN ACCORDANCE WITH CONTRACT DOCUMENTS SHALL BE FLAGGED IN THIS REVIEW.
3. VERIFY ALL DIMENSIONS WITH ARCHITECT/ DESIGNER.
4. THE ADEQUACY OF ENGINEERS DESIGN AND LAYOUT PERFORMED BY OTHERS RESTS WITH THE DESIGNING OR SUBMITTING AUTHORITIES.
5. REVIEWING IS INTENDED ONLY AS AN AID TO THE CONTRACTOR IN OBTAINING CORRECT SHOP DRAWINGS. RESPONSIBILITY FOR CORRECTNESS SHALL REST WITH THE CONTRACTOR.

SHEAR WALL SCHEDULE					
SYM	PLF	ASSEMBLY(1)	NAILING(1)	COLOR (TRACKERS)	
▽	180	7/8" STUCCO ON EXPANDED METAL OR WOVEN WIRE LATH UNLOCKED, W/81 GAUGE, 1-1/2" LONG, 7/16" HEAD, NAILS OR #16 GAUGE STAPLES, 7/16" LESS @ 6" O.C.			
▽	260	3/8" APA SHTG	8d COMMON @ 6" O.C.	BLUE	
▽	350	3/8" APA SHTG	8d COMMON @ 4" O.C.(4)	BLUE	
▽	450	3/8" APA SHTG	8d COMMON @ 3" O.C.(2,4)	BLUE	
▽	310	1532" APA SHTG	10d COMMON @ 6" O.C.	PURPLE	
▽	460	1532" APA SHTG	10d COMMON @ 4" O.C.(2,4)	PURPLE	
▽	600	1532" APA SHTG	10d COMMON @ 3" O.C.(2,4)	PURPLE	
▽	280	3/8" APA STRUCT 1	8d COMMON @ 6" O.C.	BLUE	
▽	430	3/8" APA STRUCT 1	8d COMMON @ 4" O.C.(2,4)	BLUE	
▽	550	3/8" APA STRUCT 1	8d COMMON @ 3" O.C.(2,4)	BLUE	
▽	340	1532" APA STRUCT 1	10d COMMON @ 6" O.C.	PURPLE	
▽	510	1532" APA STRUCT 1	10d COMMON @ 4" O.C.(2,4)	PURPLE	
▽	665	1532" APA STRUCT 1	10d COMMON @ 3" O.C.(2,4,5)	PURPLE	
▽	870	1532" APA STRUCT 1	10d COMMON @ 2" O.C.(2,4,5)	PURPLE	

1. NAILING FOR APA SHEATHING SHEAR WALL APPLIES TO ALL EDGE NAILING. FIELD NAIL WITH SAME SIZE @ 12" O.C.
2. FRAMING RECEIVING EDGE NAILING FROM ABUTTING PANELS SHALL BE 3X MEMBERS OR 2 INCHES NOMINAL MEMBERS FASTENED TOGETHER W/ 2-16d @ 6" O.C. FOUNDATION SILL SHALL BE 3 OR 2X MEMBERS PER ANCHOR BOLT SPACING. PLYWOOD JOINT & SILL PLATE NAILINGS SHALL BE STAGGERED.
3. ALL STUDS SHALL BE 2x4 MIN @ 16" O.C OR PANEL FACE GRAIN SHALL BE HORIZONTAL ACROSS FRAMING IF @ 24" O.C. (U.N.O.), PANEL EDGES BETWEEN STUDS SHALL BE SOLID BLOCKED (U.N.O.)
4. WHERE PLYWOOD SHEAR PANELS IS APPLIED TO BOTH SIDES OF A WALL & NAILS ARE LESS THAN 6" O.C. PANEL JOIST SHALL BE OFFSET ON DIFFERENT FRAMING MEMBERS OR STUDS AND SILL PLATES SHALL BE 3X AND NAILS SHALL BE STAGGERED.
5. SILL PLATES SHALL BE ON 3X MEMBER.



City of Oceanside Building Division
Reviewed for code compliance with the California Building Standards Codes and applicable City of Oceanside Codes and Ordinances
L Bolton 07/17/2025 1:34:55 PM

SUMMARY OF SPECIAL INSPECTION

I, AS THE ENGINEER/ARCHITECT OF RECORD, CERTIFY THAT I HAVE PREPARED THE FOLLOWING SPECIAL INSPECTION PROGRAM AS REQUIRED BY THE CBC SECTION 1705.1 FOR THE CONSTRUCTION PROJECT LOCATED AT THE SITE.





















I, AS THE OWNER, AGENT OF THE OWNER, OR ARCHITECT OF RECORD CERTIFY THAT I WILL BE RESPONSIBLE FOR EMPLOYING THE SPECIAL INSPECTOR(S) FOR THE CONSTRUCTION PROJECT LOCATED AT THE SITE.

SIGNED:

LIST OF WORK REQUIRING SPECIAL INSPECTION:				
HOLDOWNS & BOLTS				
APPLIES	No.	Description of Type of Inspection Required	Continuous during task listed	Periodically During task listed
	1	5/8" Threaded Rod "Simpson SET-3G ESR-4057 10" EMBD @ Holdowns	X	
	2	5/8" Threaded Rod "Simpson SET-3G ESR-4057 5" EMBD @ Anchor Bolts	X	
			X	
SOIL				
✓	4	Verify materials below footings are adequate to achieve the design bearing capacity.	X	
✓	5	Verify excavations are extended to proper depth and have reached proper material.	X	
✓	6	Perform classification and testing of controlled fill materials.	X	
✓	7	Verify use of proper materials, densities and lift thicknesses during placement and compaction of controlled fill.		X
✓	8	Prior to placement of controlled fill, observe subgrade and verify that site has been prepared properly.	X	
STEEL				
	9	All structural welding Per Plan		
WOOD				
✓	10	Plywood Shear Nailing 4" O.C. or less		X
	11	Strong Wall Products per Manufacturers Recommendations, ESR-2652		X
MASONRY				
✓	12	Preparation of Grout & Mortar specimens &/or prisms shall be observed	X	

NOTES

1. NOTICE TO THE APPLICANT/OWNER/OWNER'S AGENT/ARCHITECT OR ENGINEER OF RECORD: BY USING THIS PERMITTED CONSTRUCTION DRAWINGS FOR CONSTRUCTION/INSTALLATION OF THE WORK SPECIFIED HEREIN, YOU AGREE TO COMPLY WITH THE REQUIREMENTS OF THE CITY FOR SPECIAL INSPECTIONS, STRUCTURAL OBSERVATIONS, CONSTRUCTION MATERIAL TESTING AND OFF-SITE FABRICATION OF BUILDING COMPONENTS, CONTAINED IN THE STATEMENT OF SPECIAL INSPECTIONS AND, AS REQUIRED BY THE CALIFORNIA CONSTRUCTION CODES.
2. NOTICE TO THE CONTRACTOR/BUILDER/INSTALLER / SUB- CONTRACTOR/ OWNER-BUILDER: BY USING THIS PERMITTED CONSTRUCTION DRAWINGS FOR CONSTRUCTION/INSTALLATION OF THE WORK SPECIFIED HEREIN, YOU AGREE TO COMPLY WITH THE REQUIREMENTS OF THE CITY OF SAN DIEGO FOR SP, INSPECTIONS, STRUCTURAL OBSERVATIONS, CONSTRUCTION MATERIAL TESTING AND OFF-SITE FABRICATION OF BUILDING COMPONENTS, CONTAINED IN THE STATEMENT OF SP, INSP. AND AS REQUIRED BY THE CALIF. CONS. CODES.
3. THE SPECIAL INSPECTOR MUST BE CERTIFICATE BY THE CITY, DEVELOPMENT SERVICES, IN THE CATEGORY OF WORK REQUIRED TO HAVE SPECIAL INSPECTION.
4. THE CONSTRUCTION MATERIALS TESTING LABORATORY MUST BE APPROVED BY THE CITY, DEVELOPMENT SERVICES, FOR TESTING OF MATERIALS, SYSTEMS, COMPONENTS AND EQUIPMENTS.
5. THE SPECIAL INSPECTIONS IDENTIFIED ON PLANS ARE, IN ADDITION TO, AND NOT A SUBSTITUTE FOR, THOSE INSPECTIONS REQUIRED TO BE PERFORMED BY A CITY'S BUILDING INSPECTOR.
6. FABRICATOR MUST BE APPROVED BY THE CITY OF SAN DIEGO, DEVELOPMENT SERVICES FOR THE FABRICATION OF MEMBERS AND ASSEMBLIES ON THE PREMISES OF FABRICATOR'S SHOP.
7. FABRICATOR SHALL SUBMIT AN "APPLICATION TO PERFORM OFF-SITE FABRICATION" TO THE INSPECTION SERVICES DIVISION FOR APPROVAL PRIOR TO COMMENCEMENT OF FABRICATION.
8. FABRICATOR SHALL SUBMIT AN "CERTIFICATE OF COMPLIANCE FOR OFF-SITE FABRICATION" TO THE INSPECTION SERVICES DIVISION PRIOR TO ERECTION OF FABRICATED ITEMS AND ASSEMBLIES.

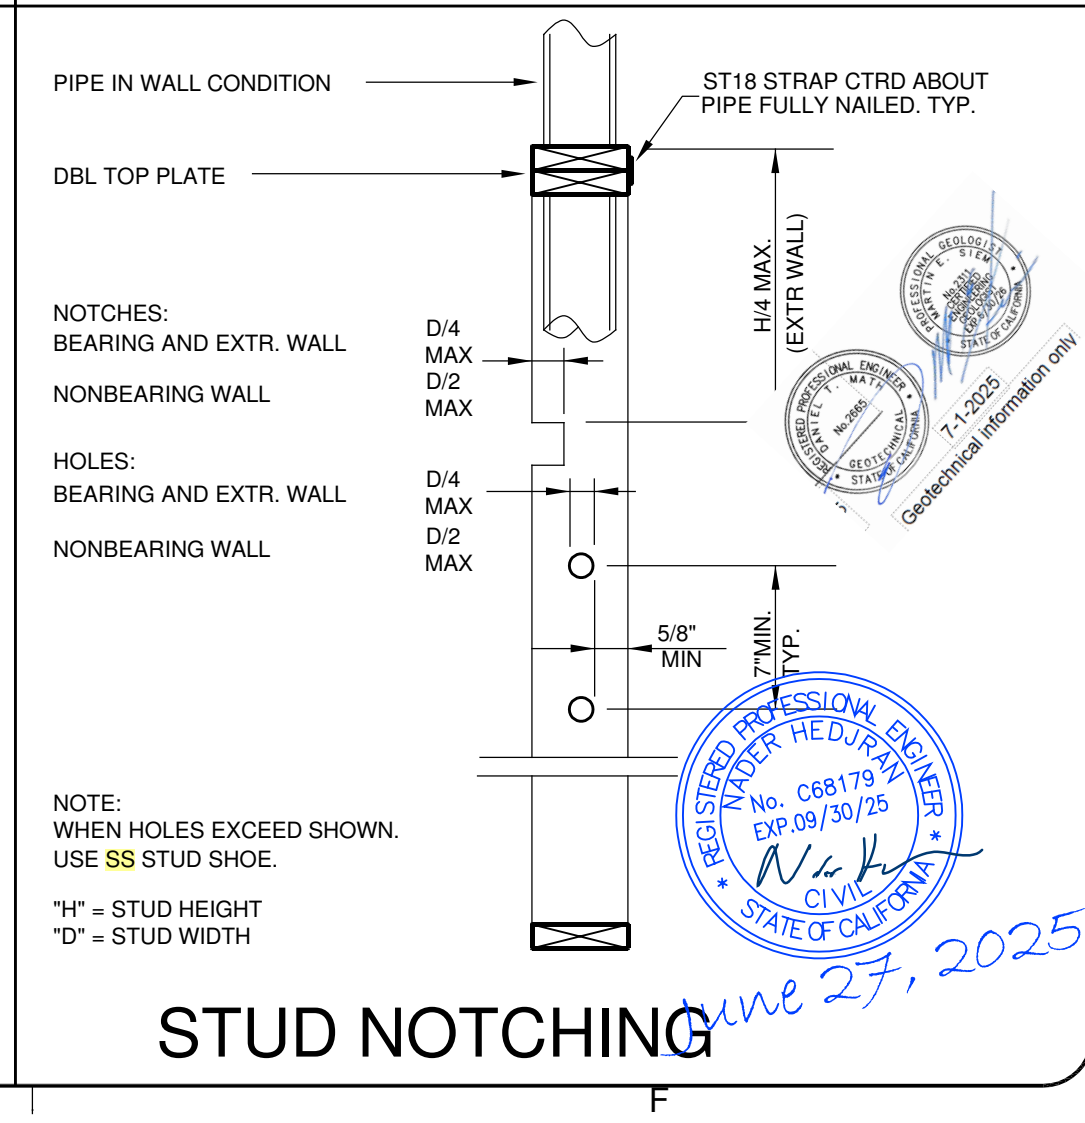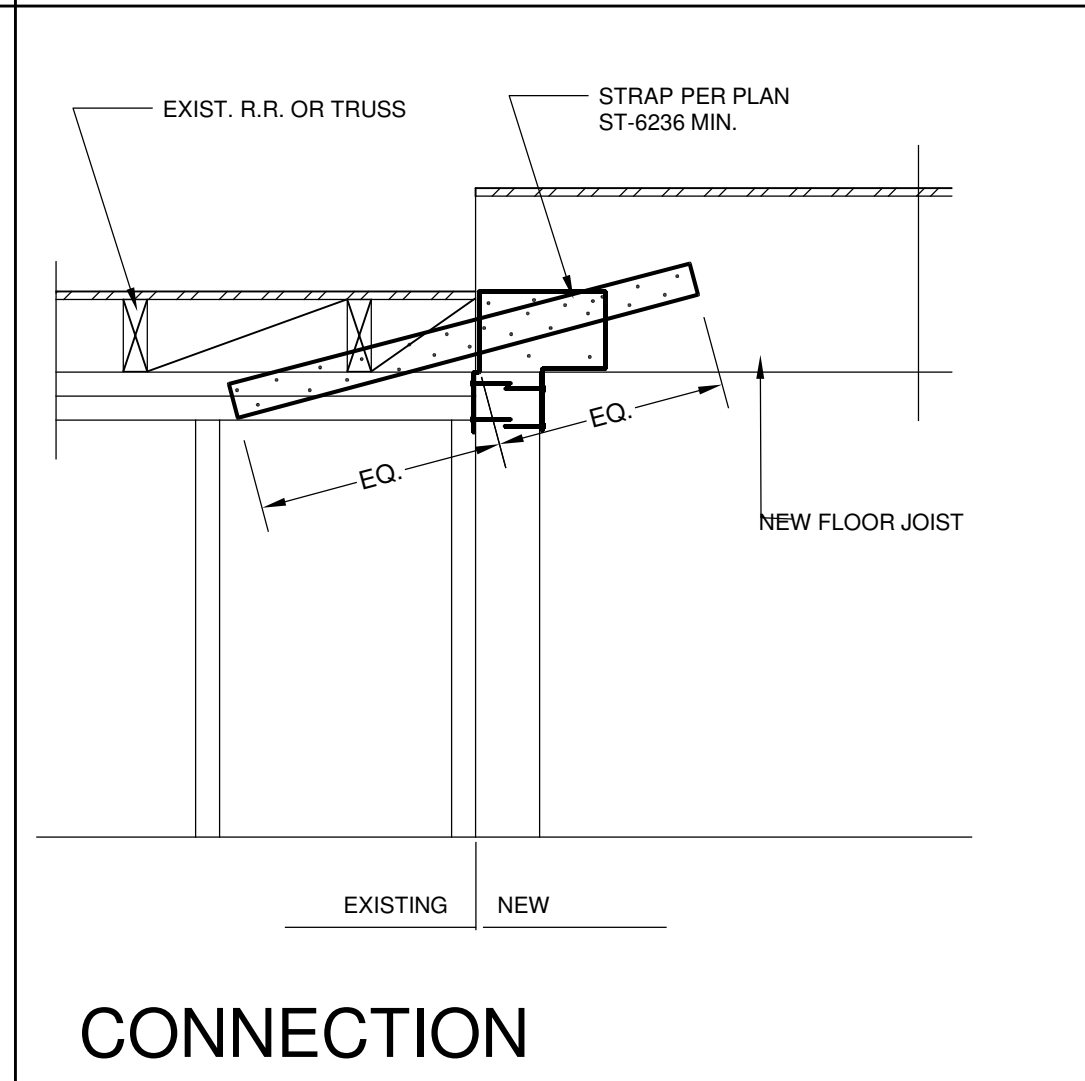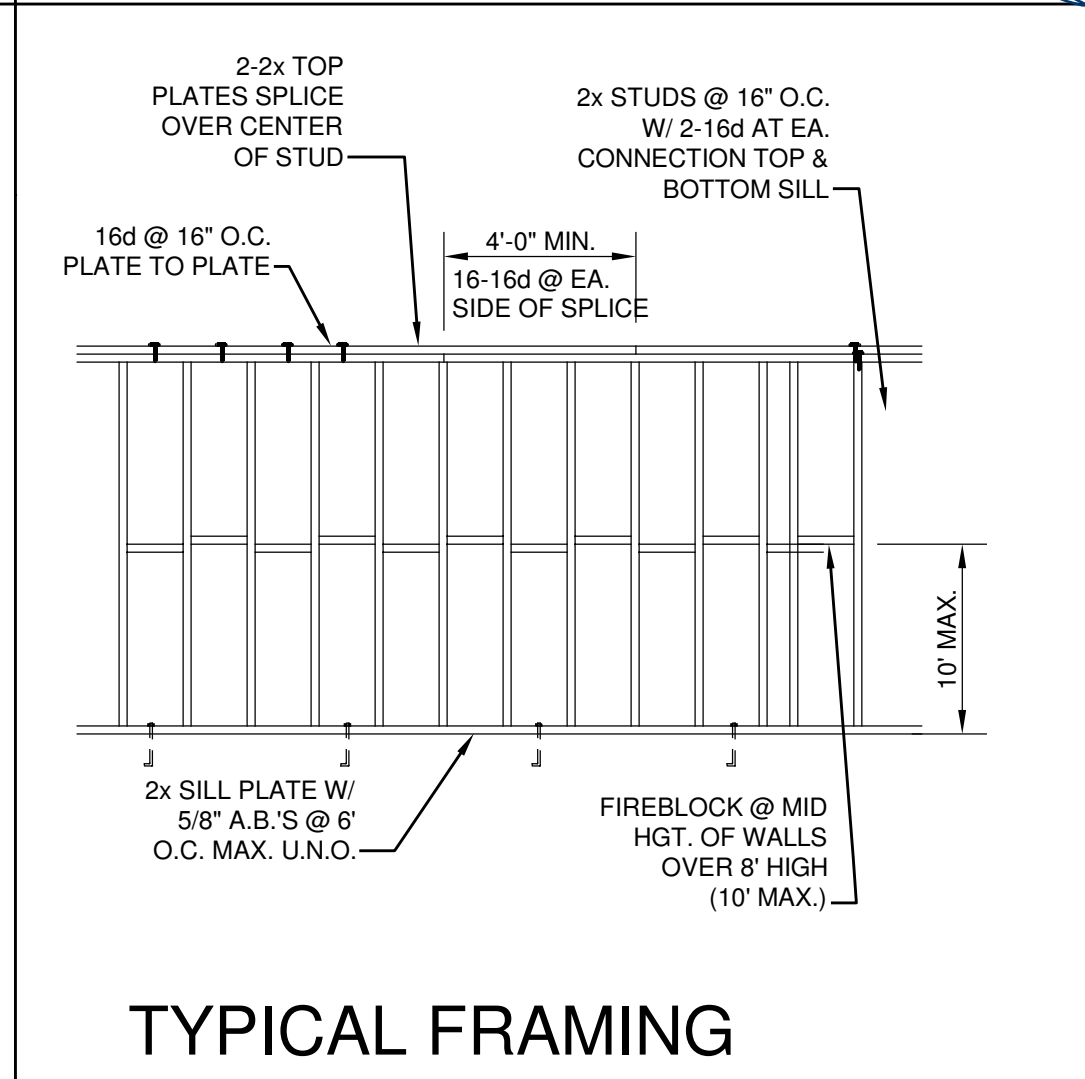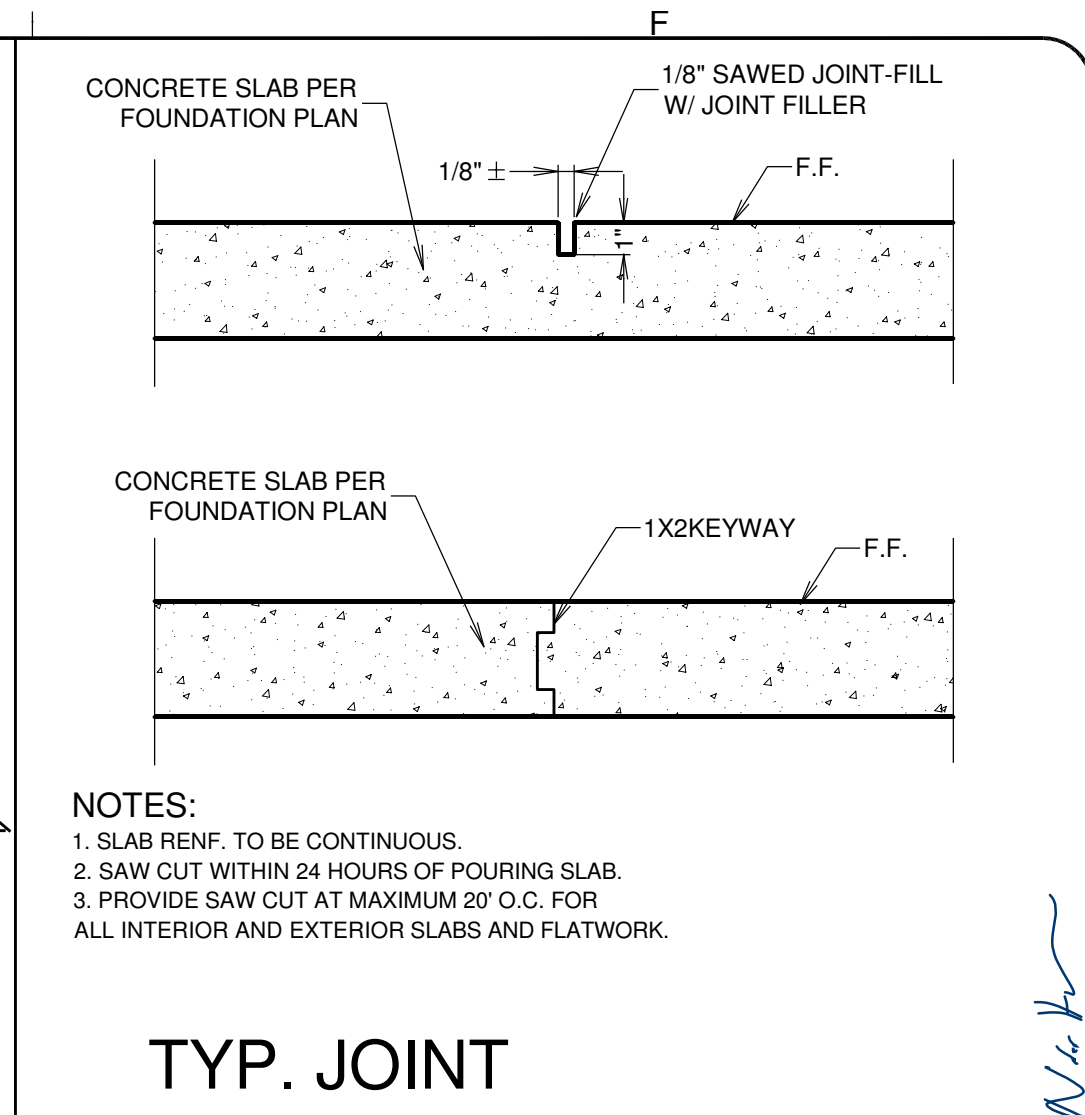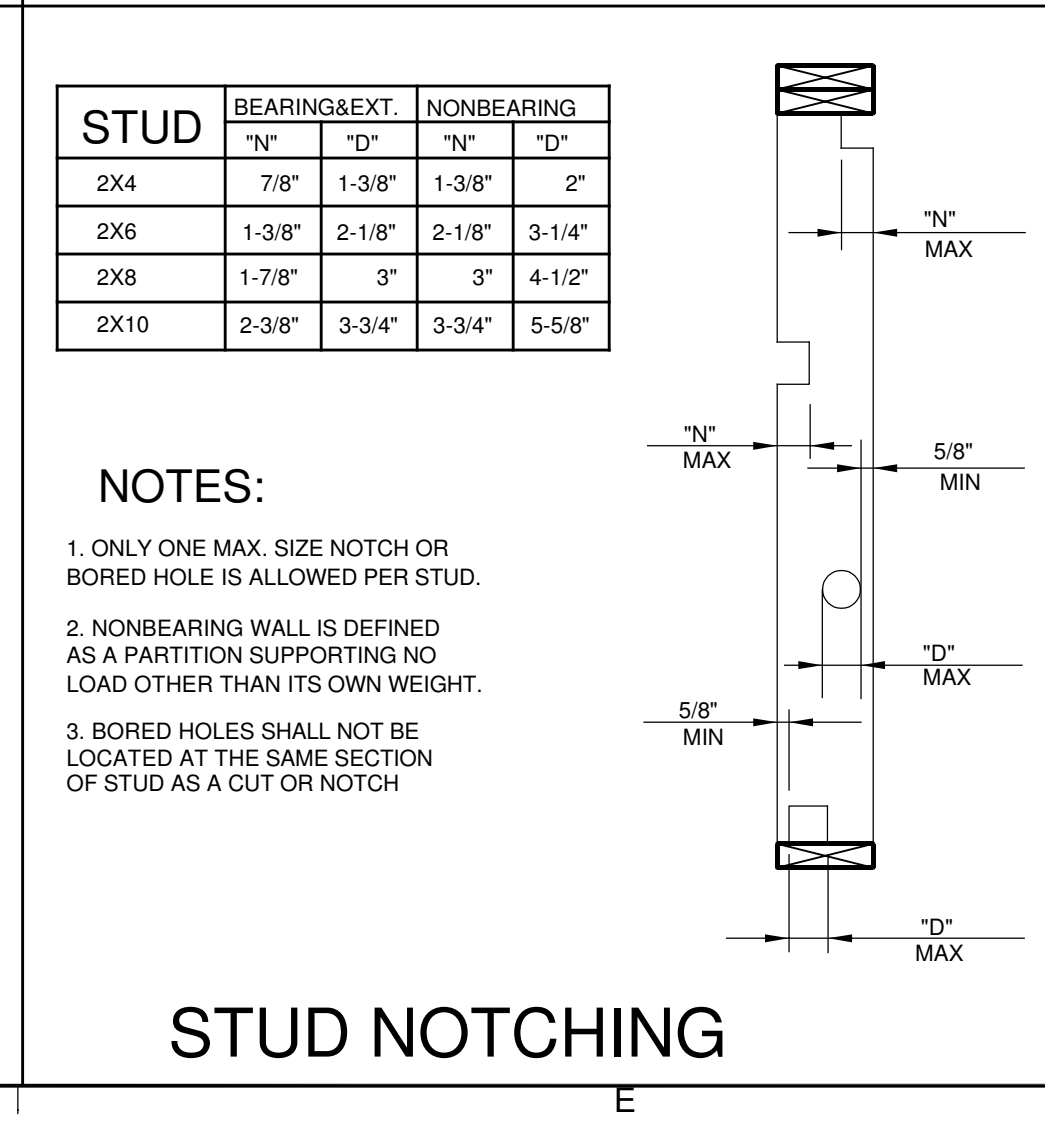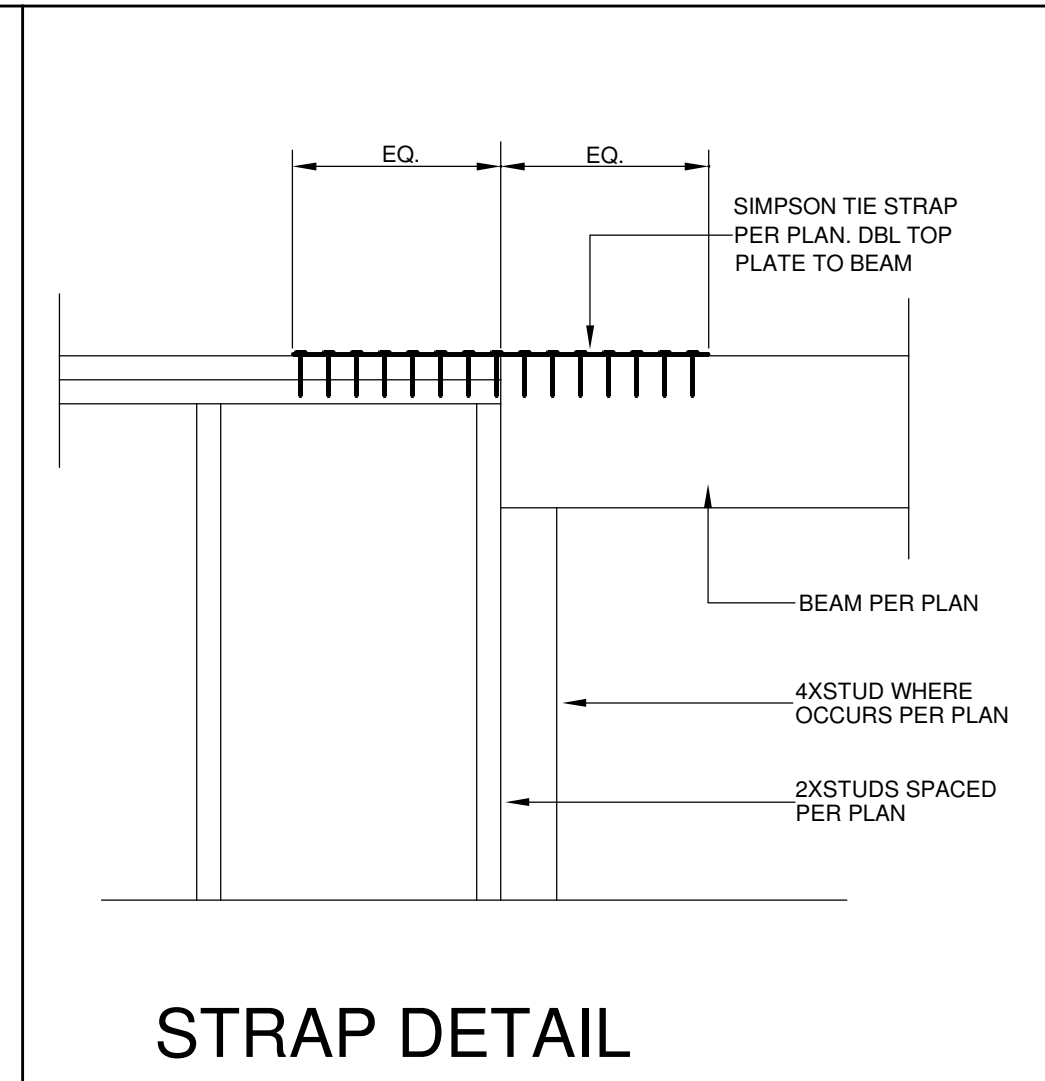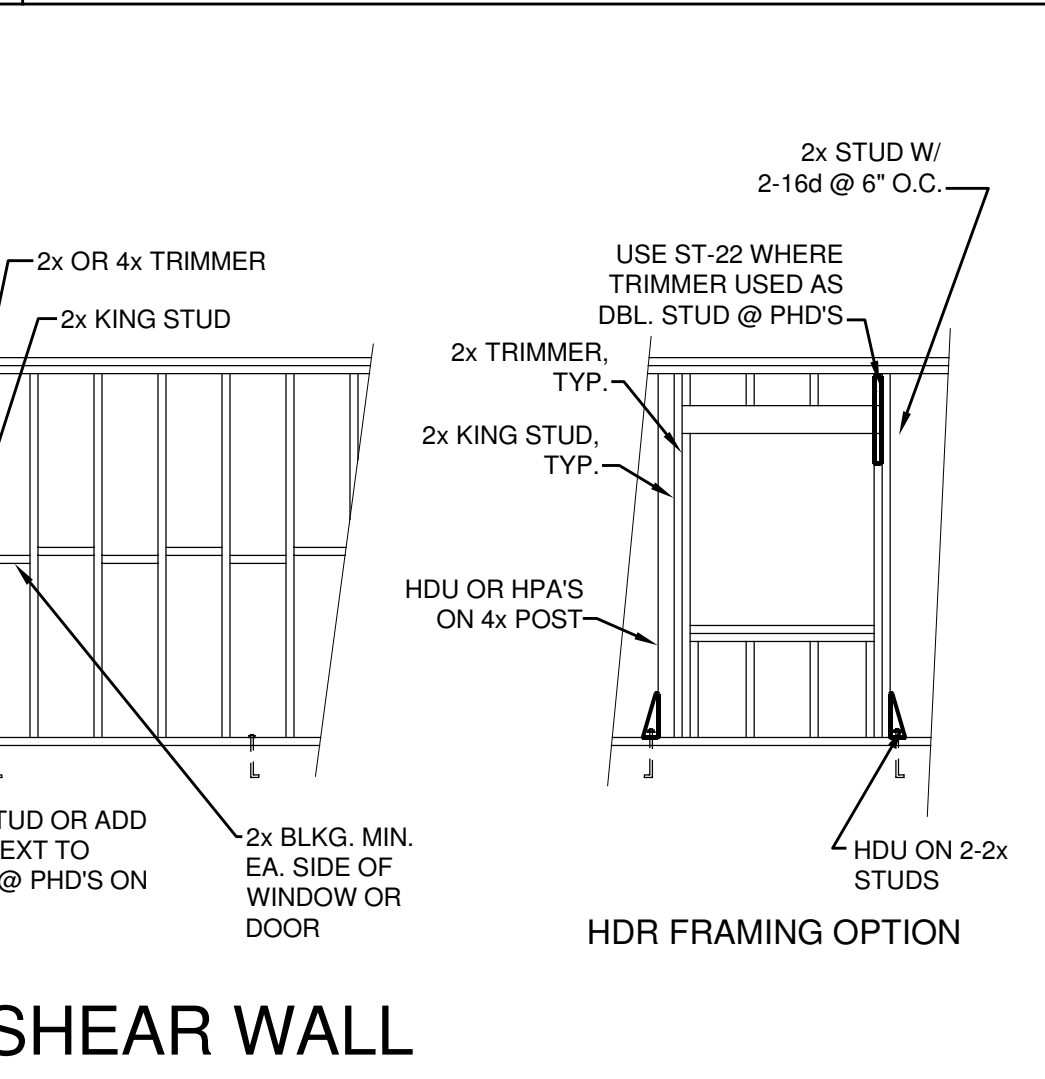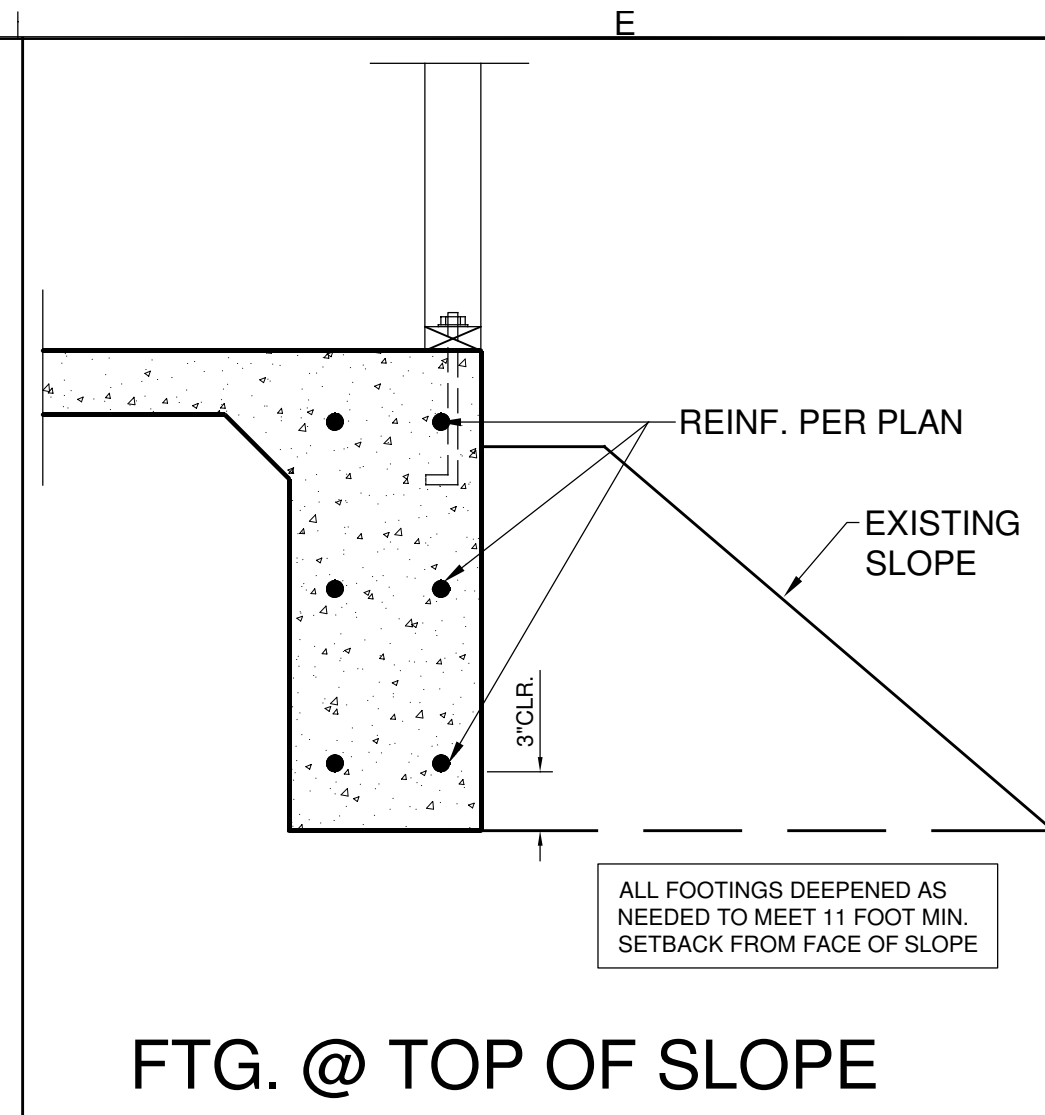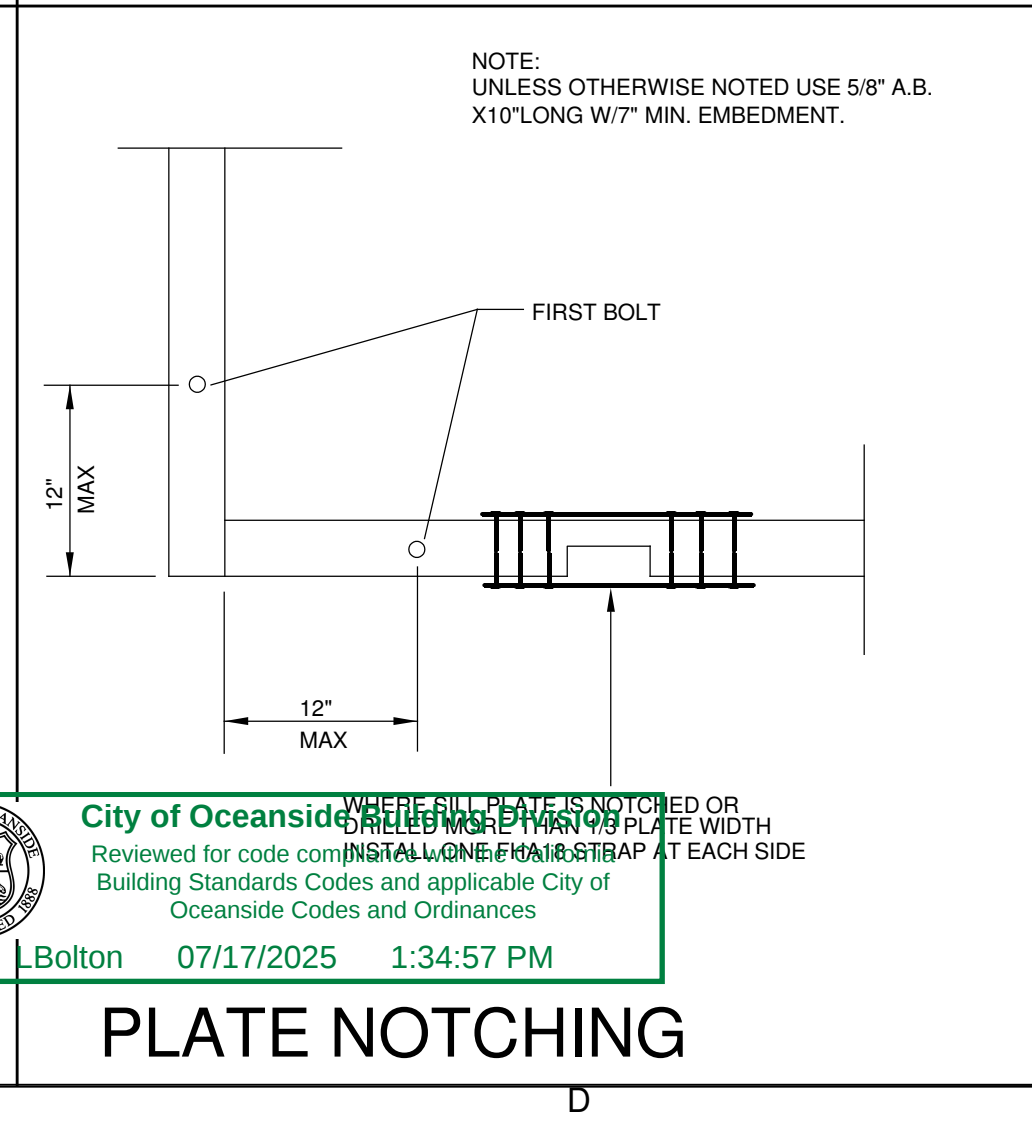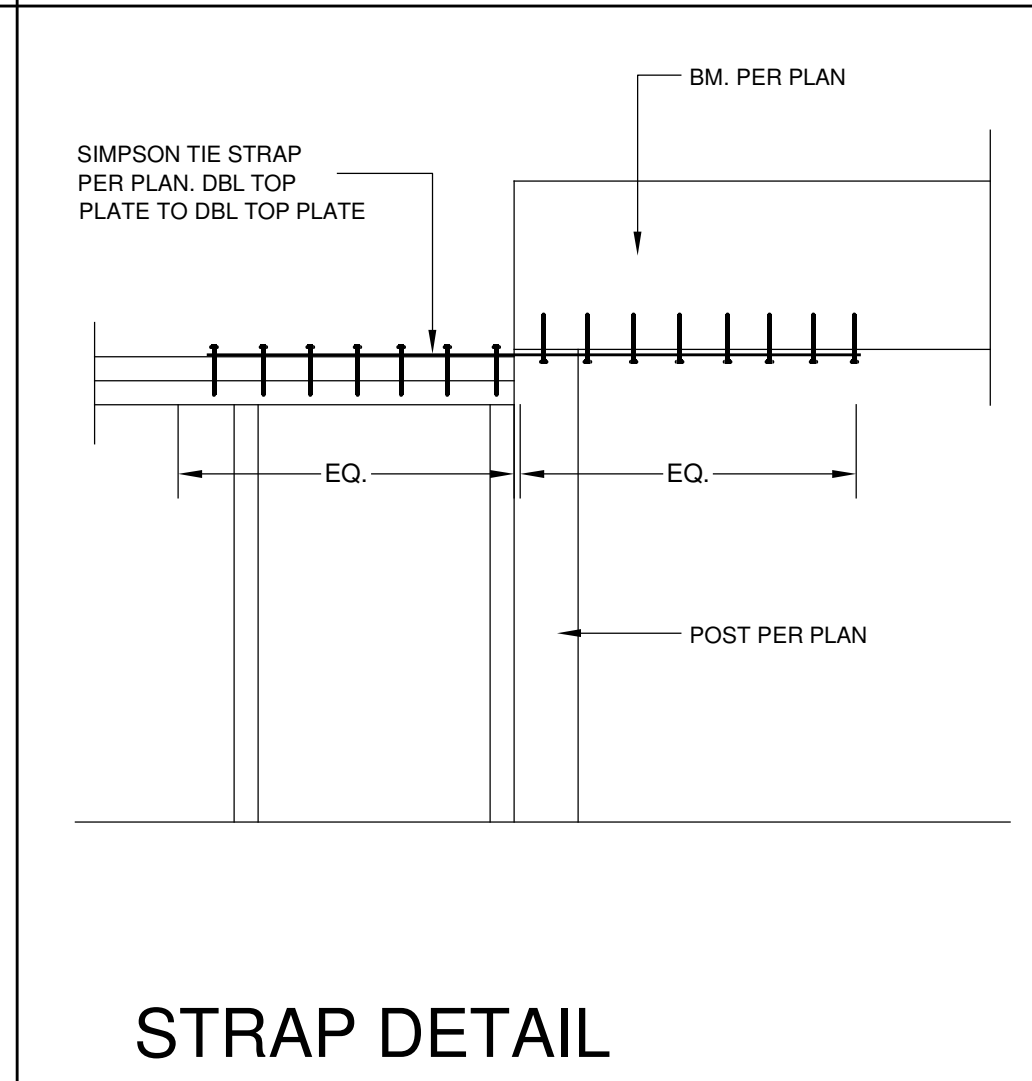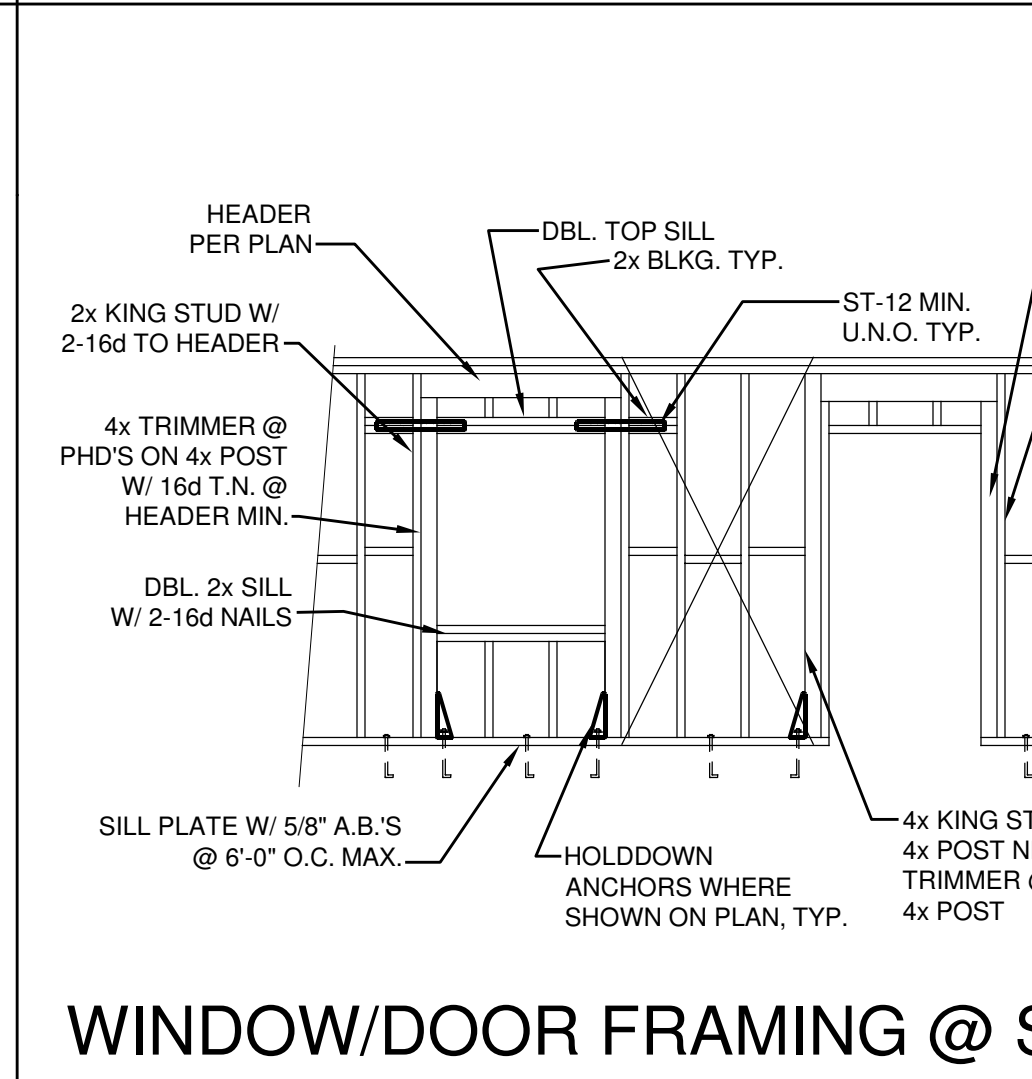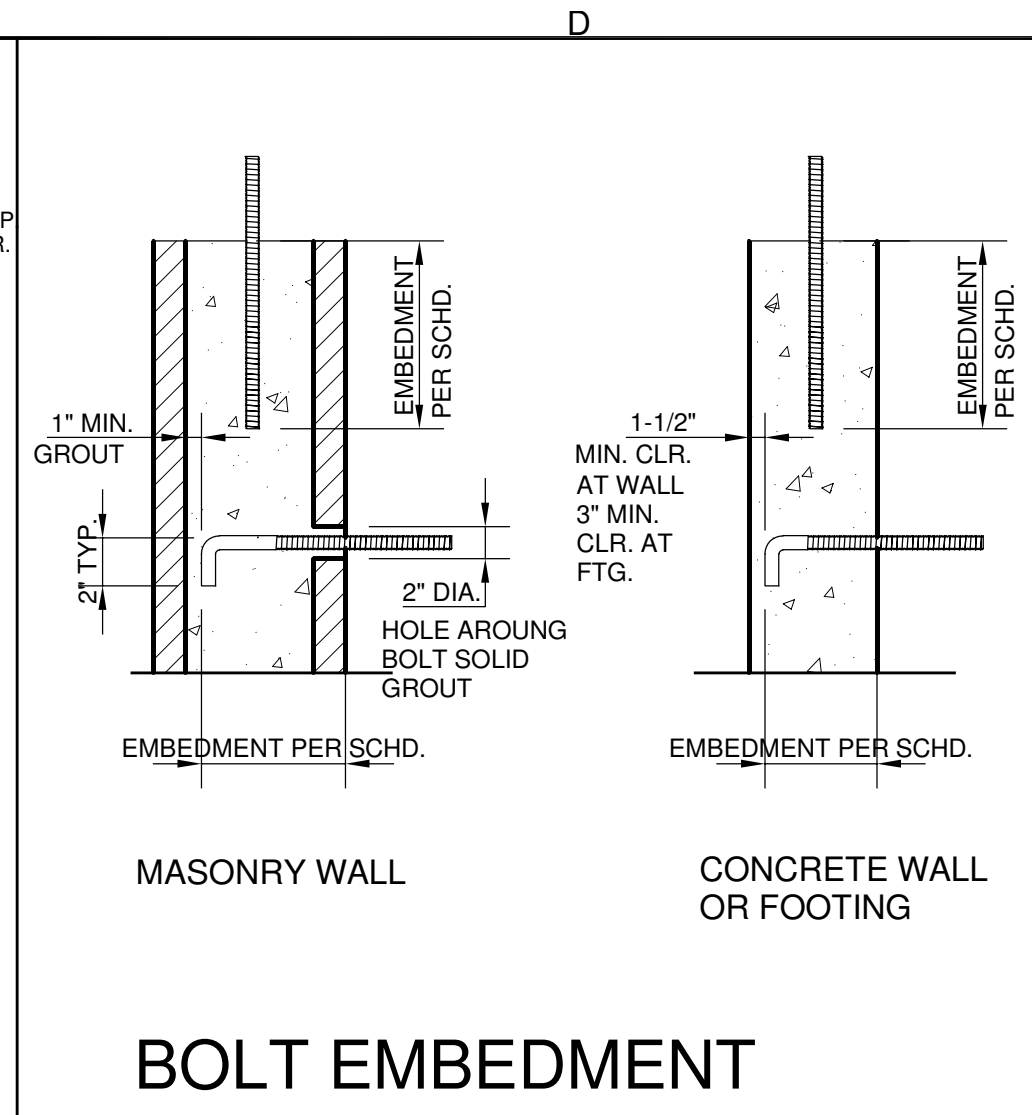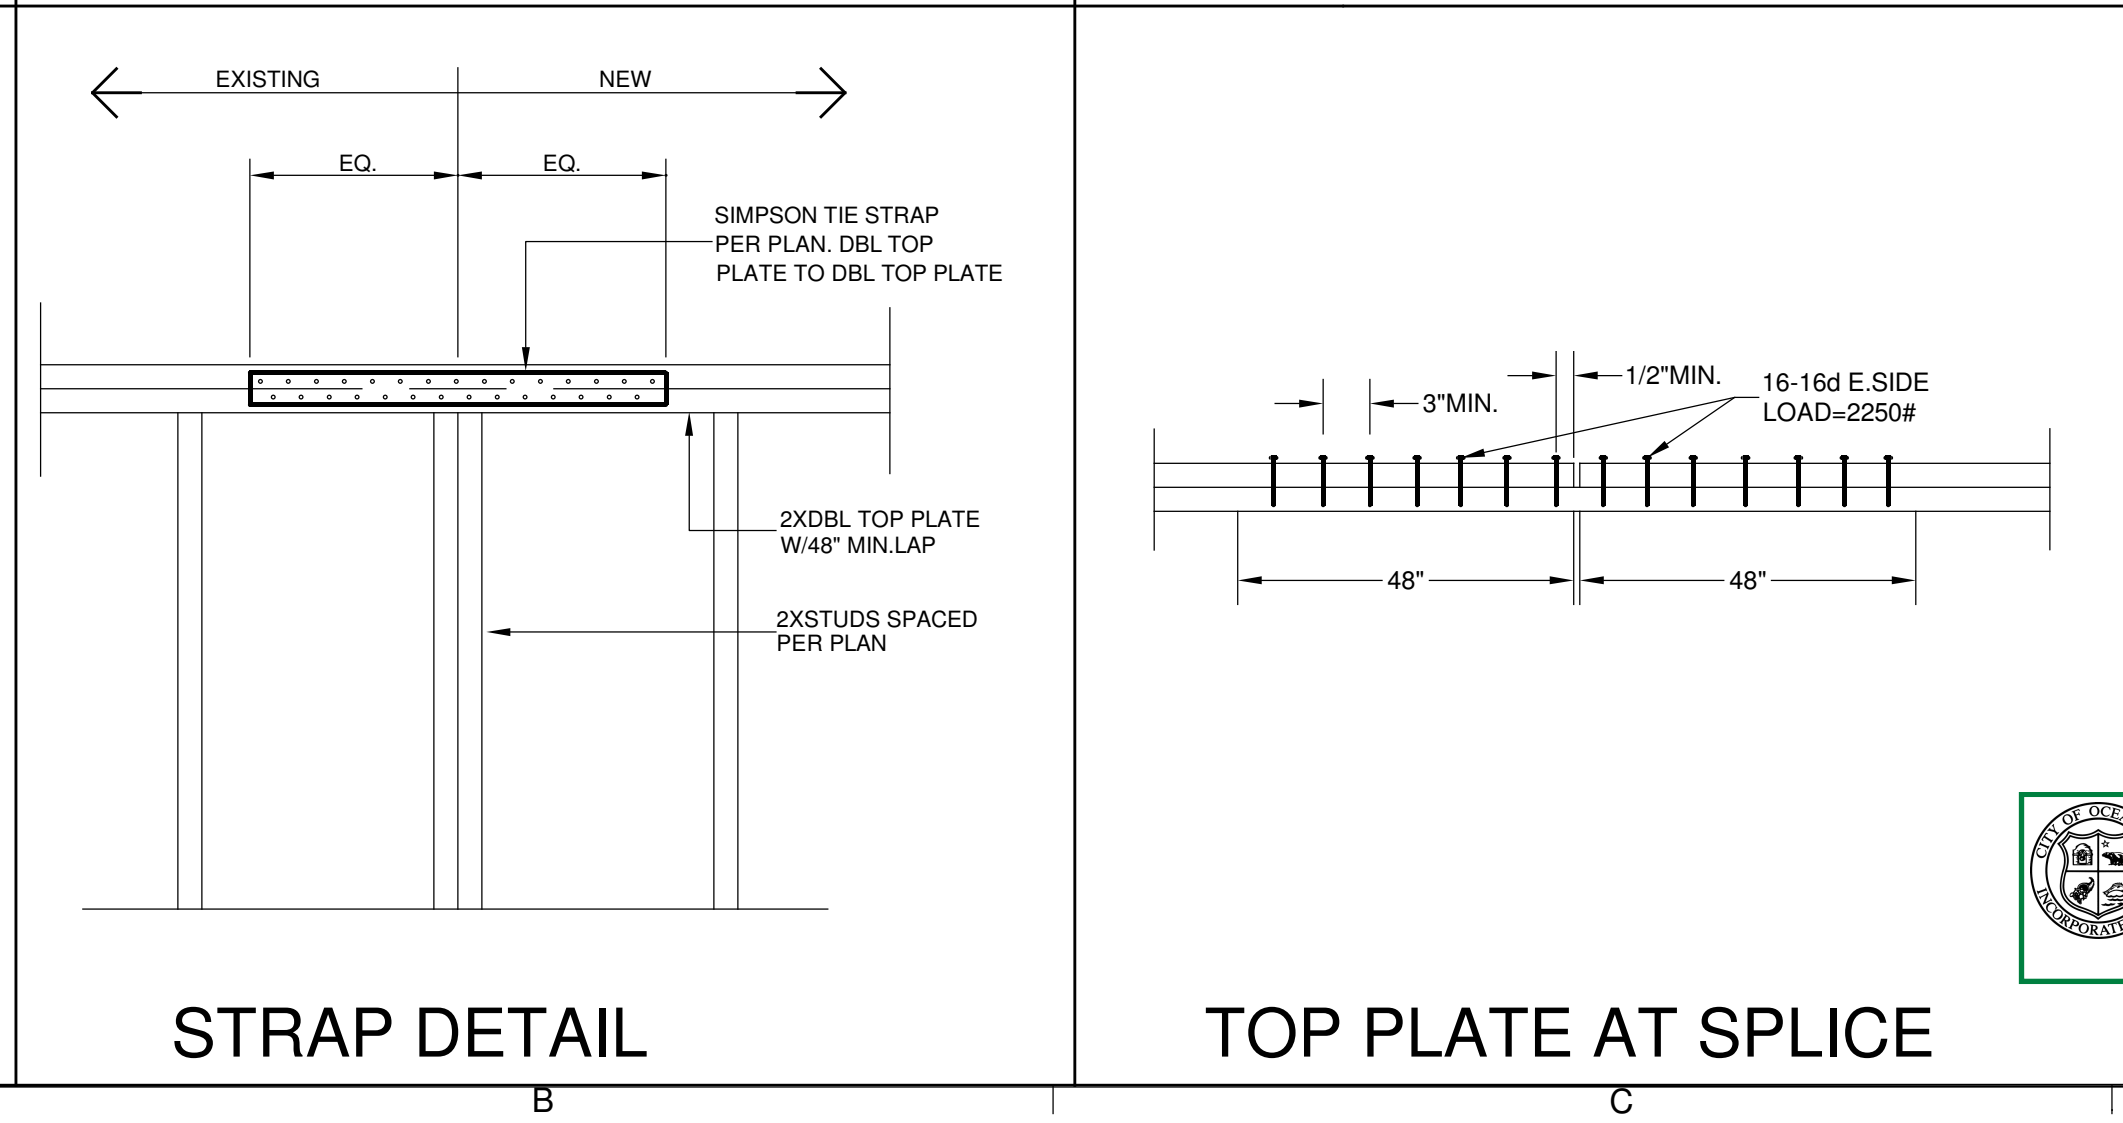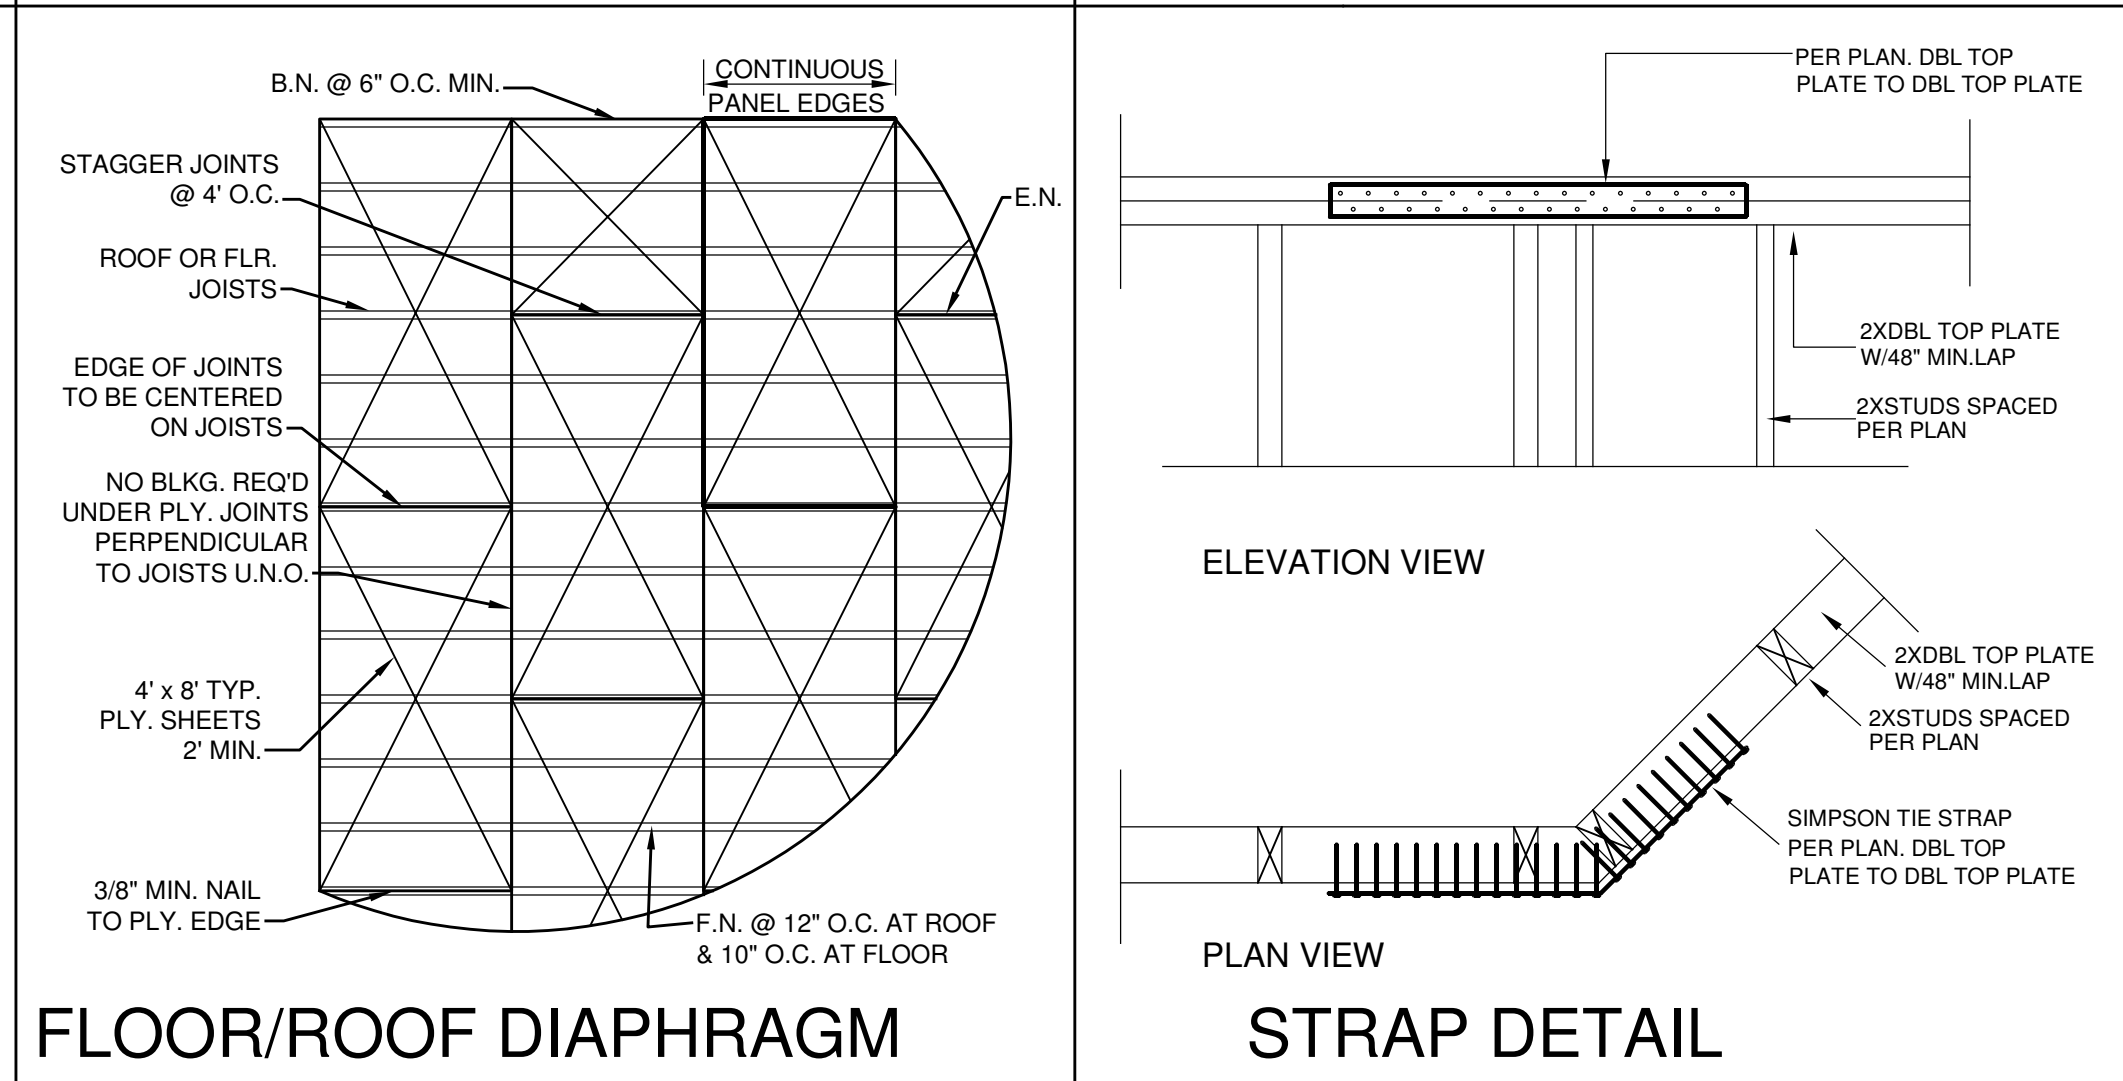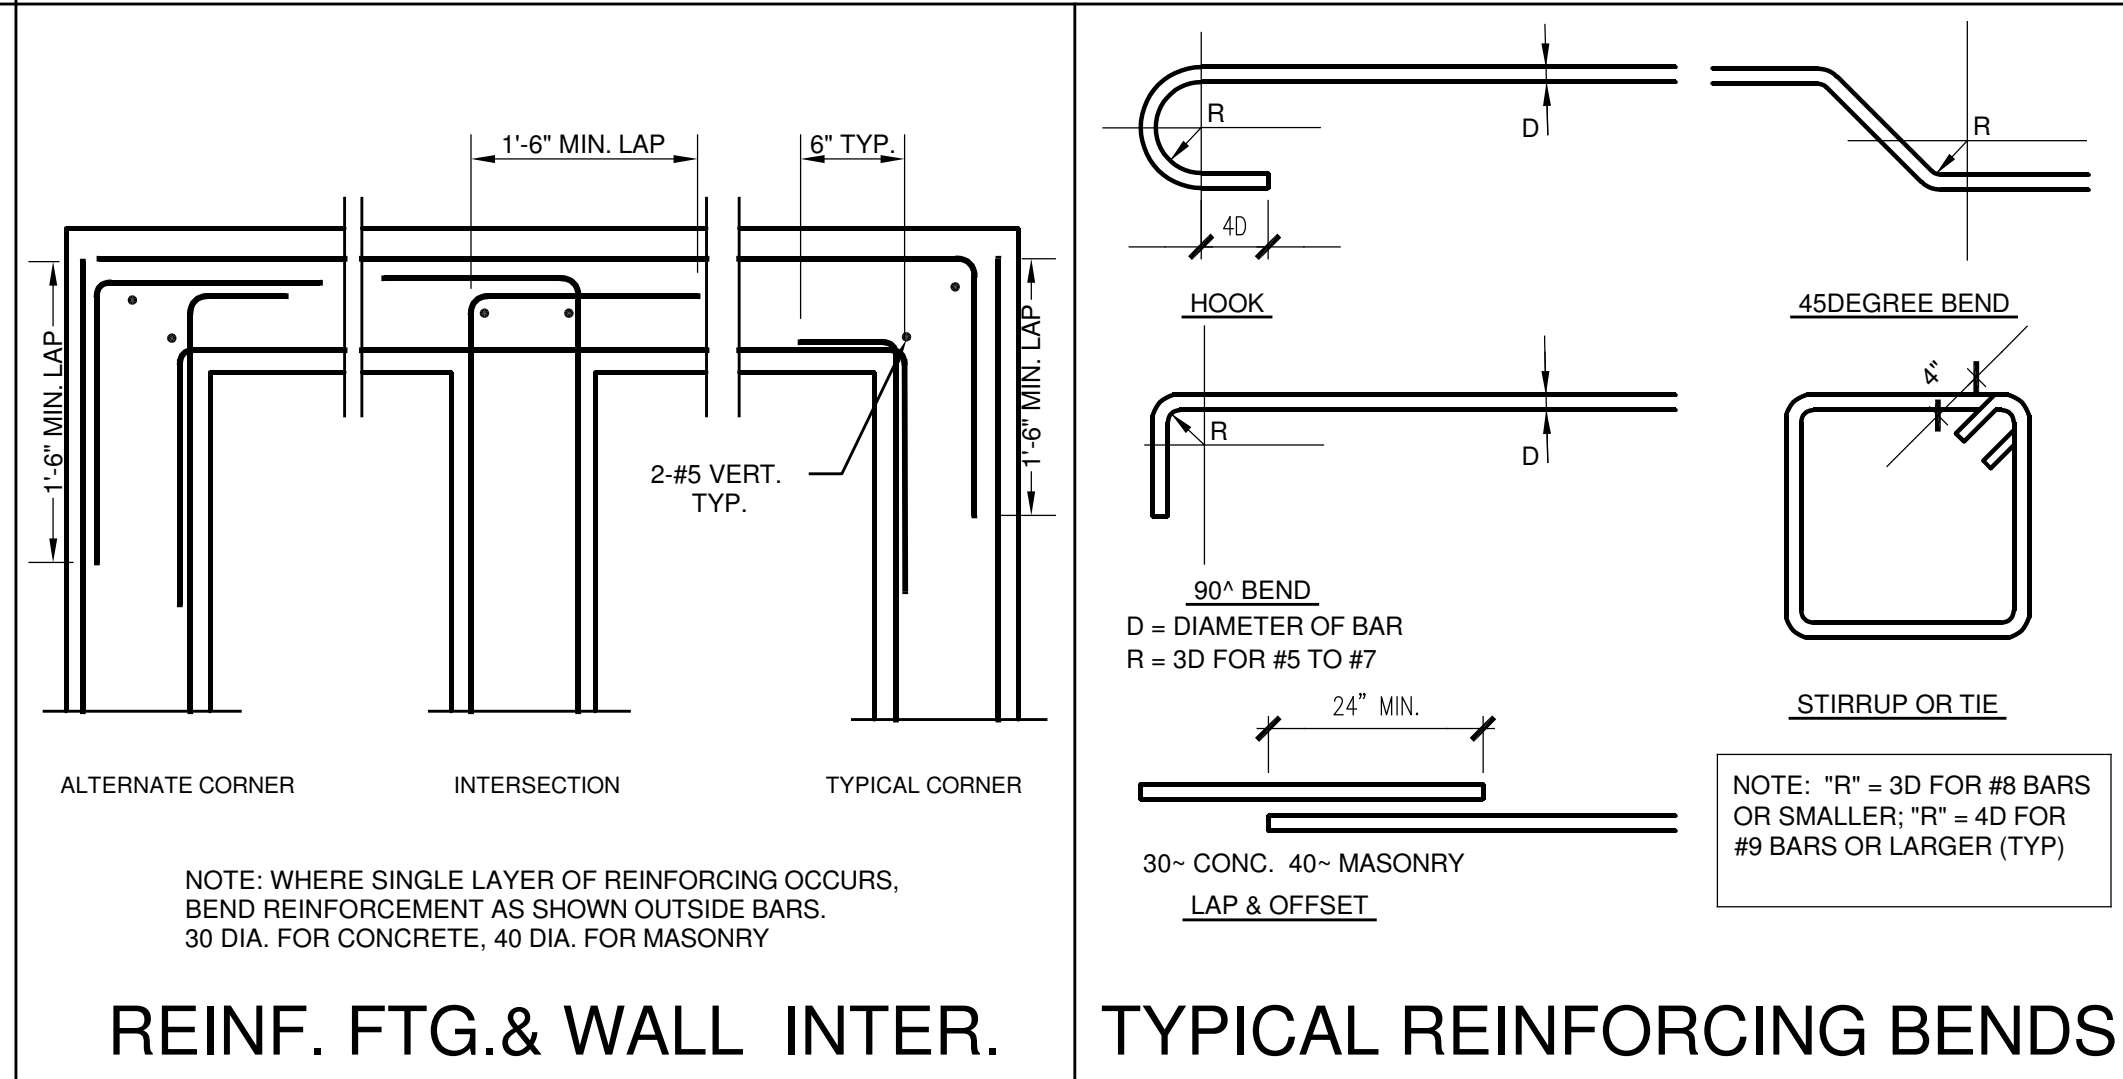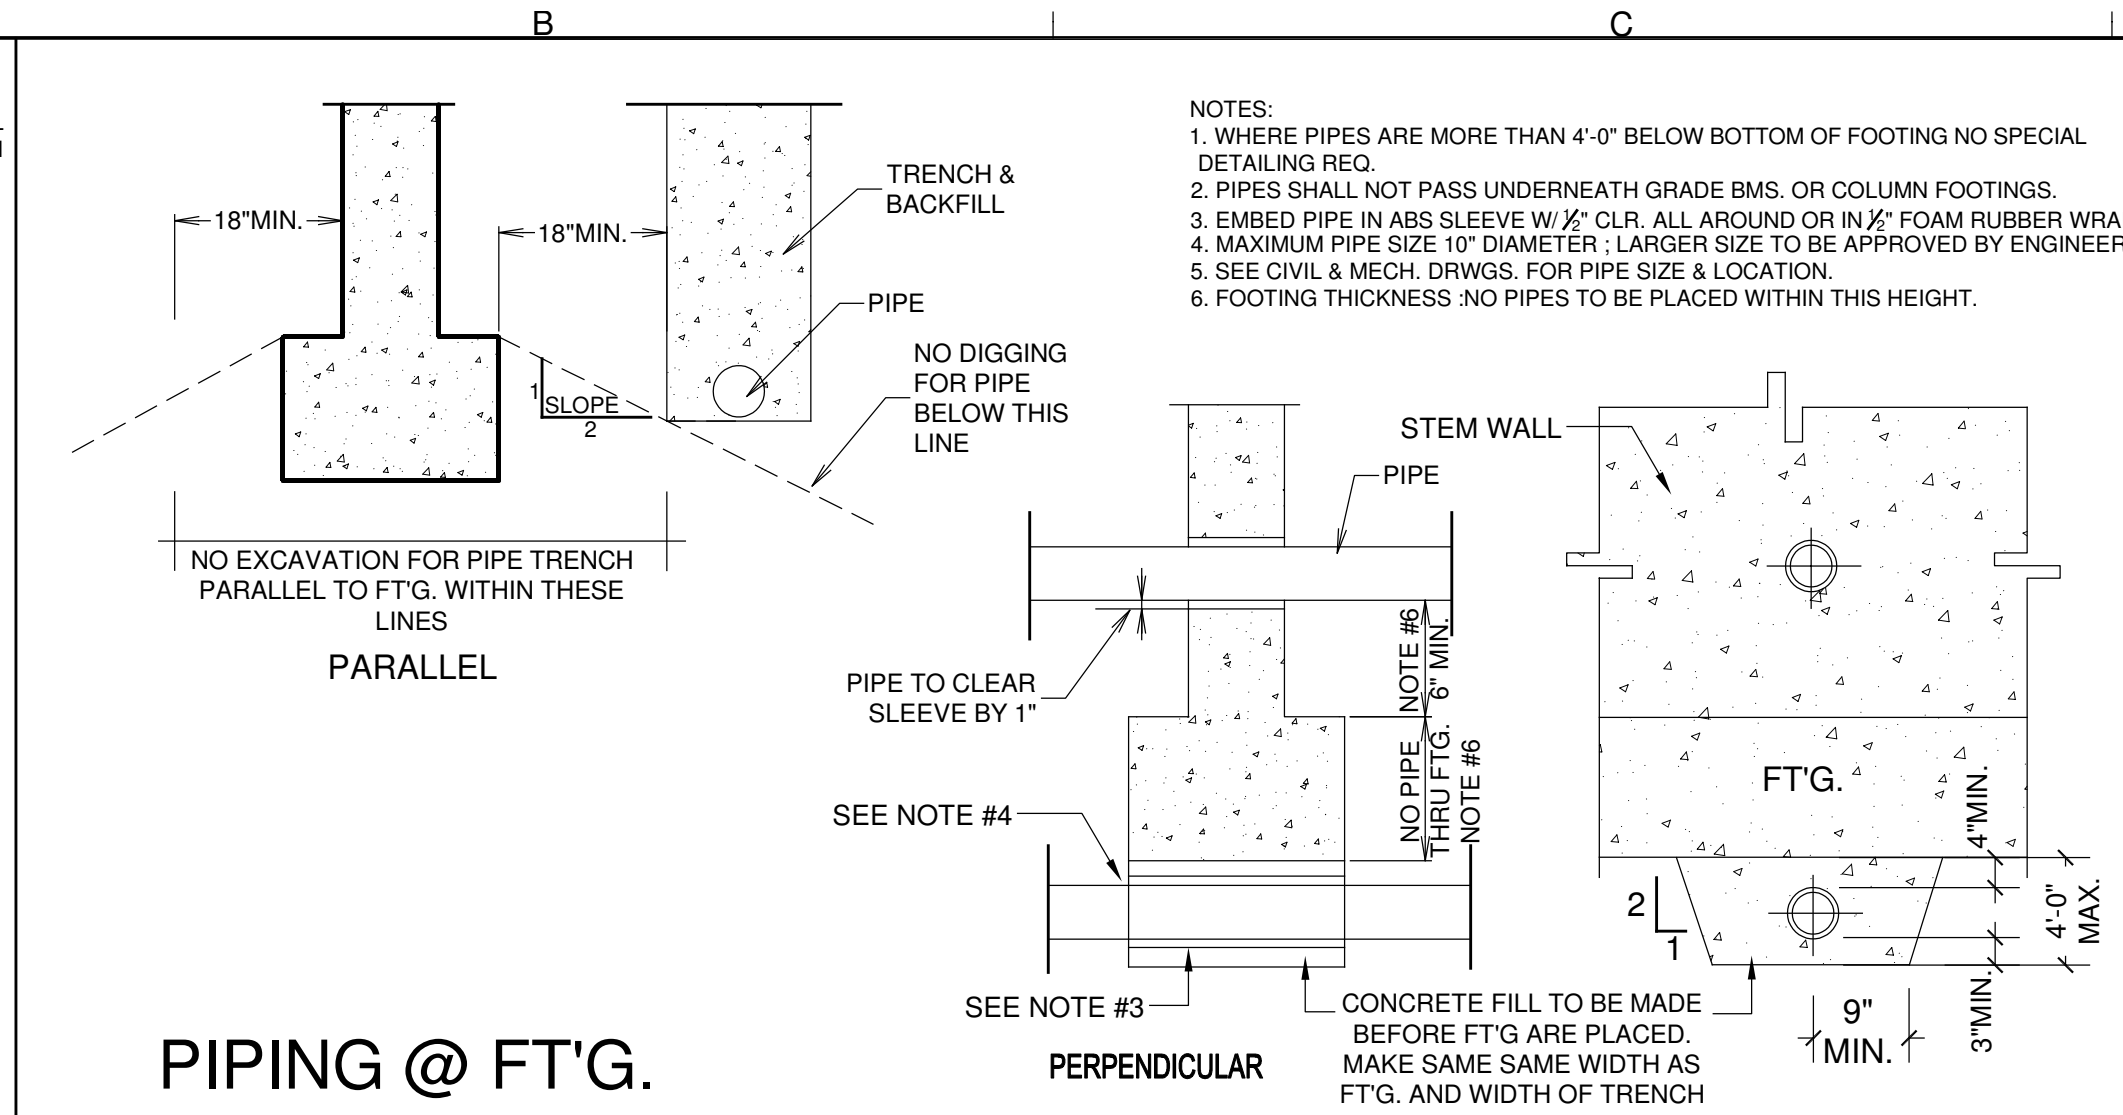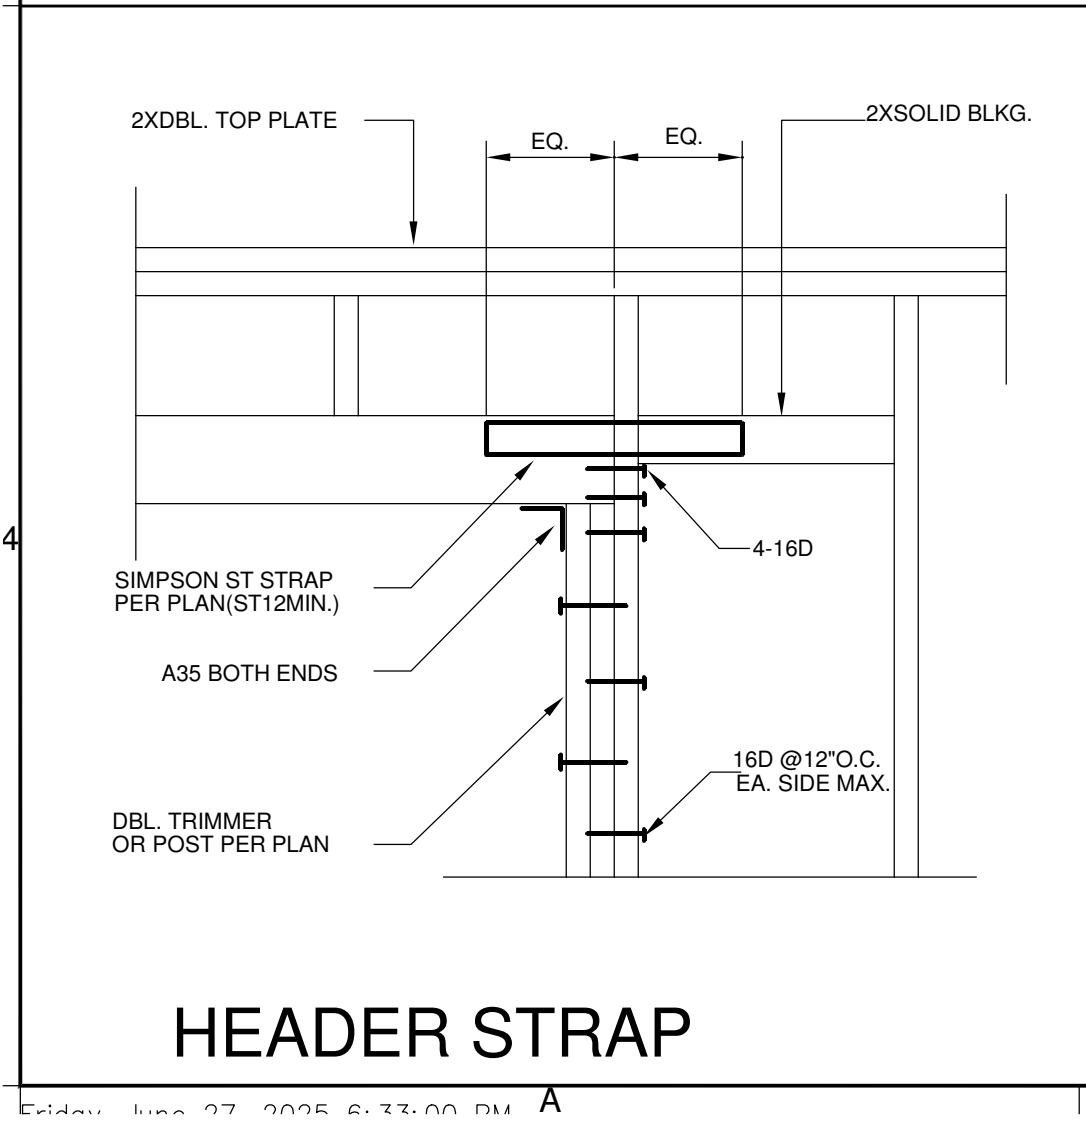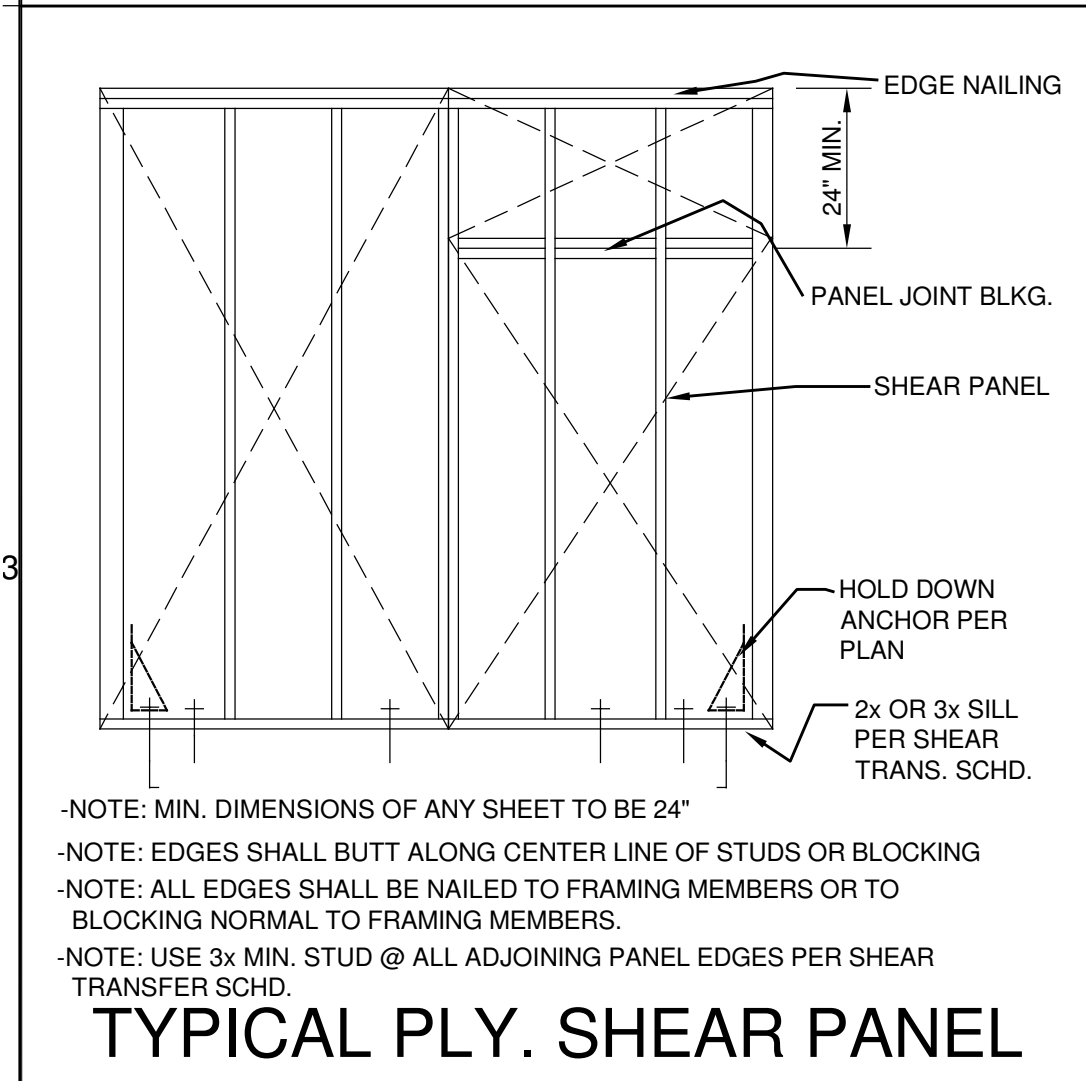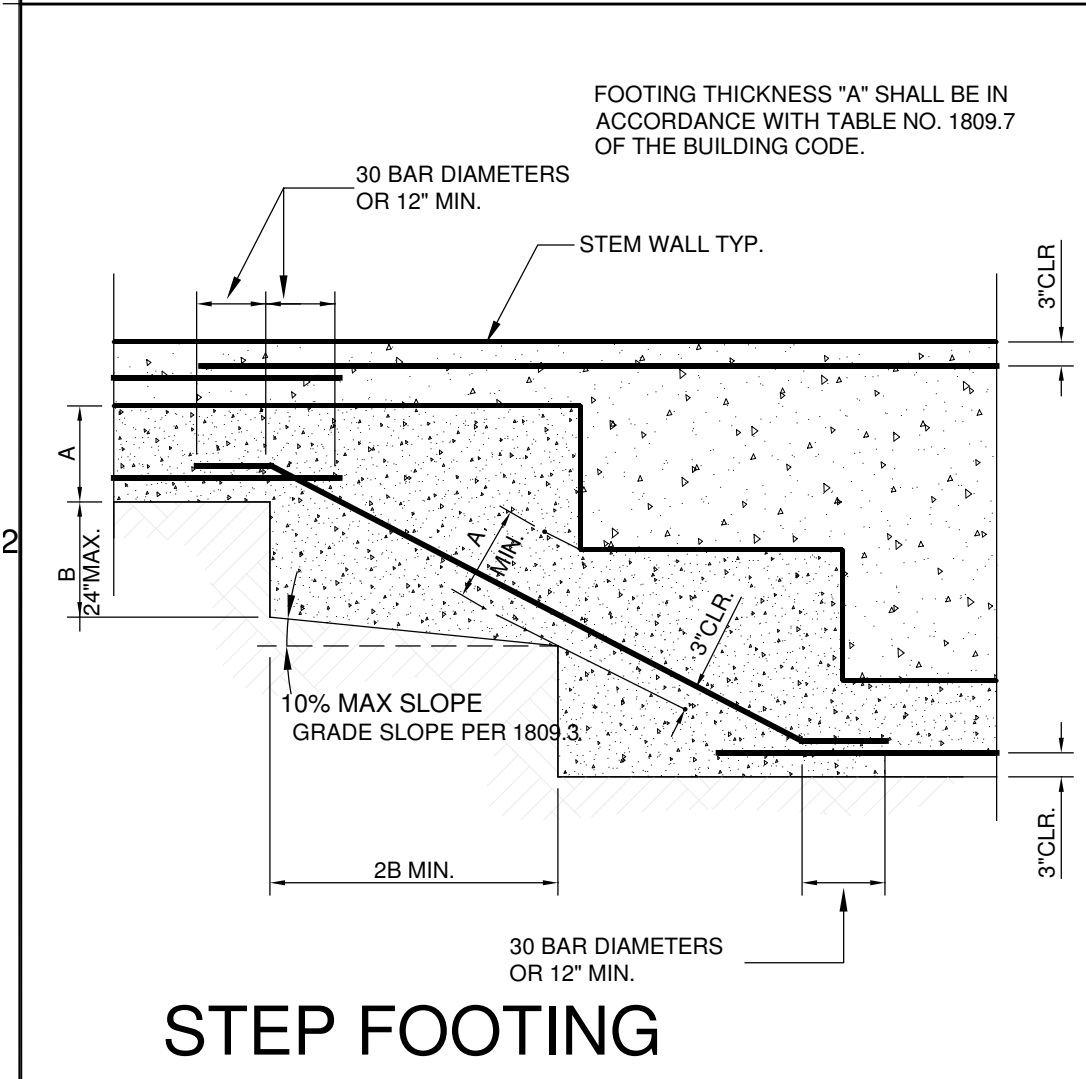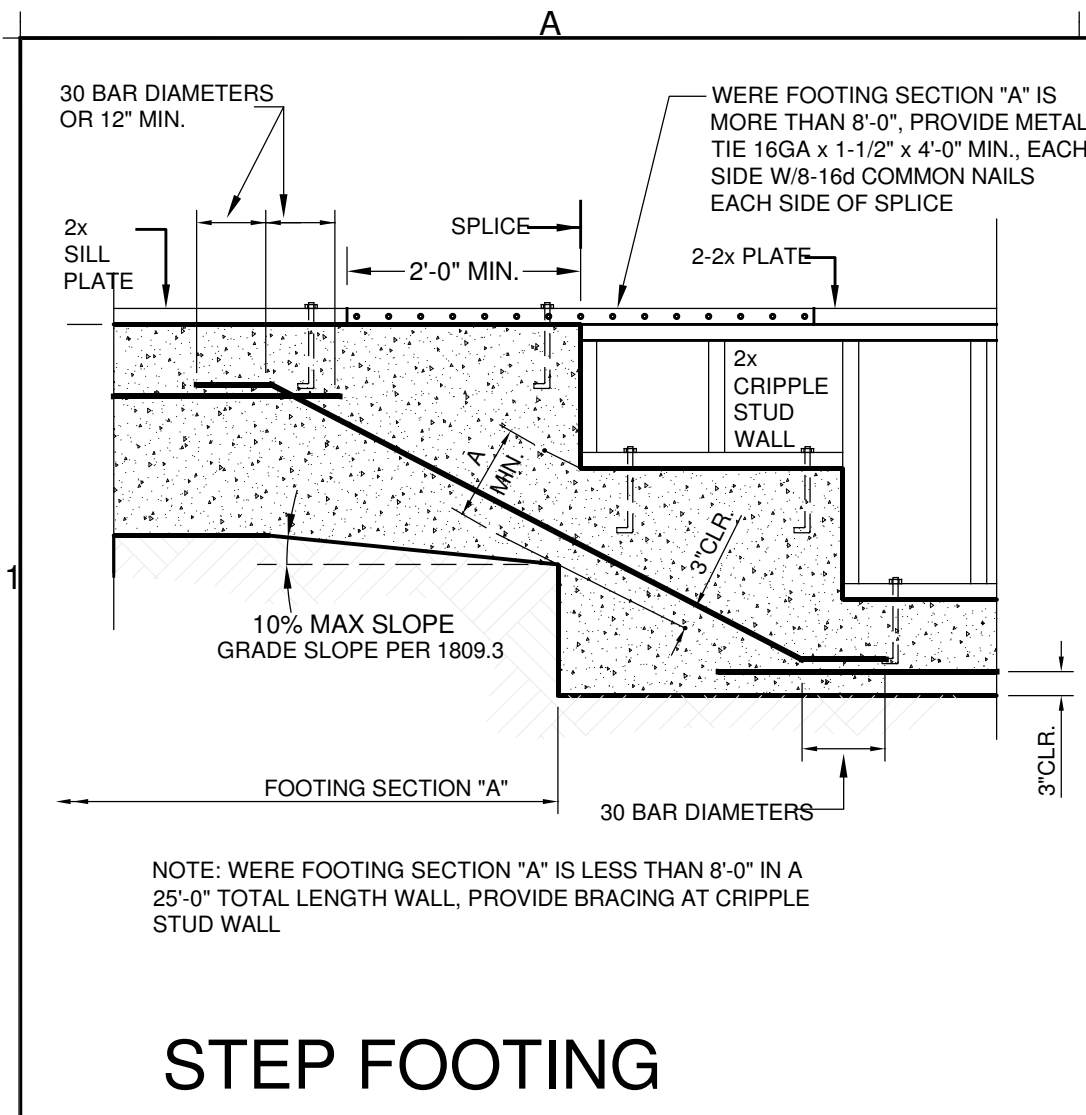

REVISIONS

DATE

NDC

NADER'S DESIGN CONSULTING, INC.

Phone: (619) 241-1848 Fax: (619) 241-1847 email: design_eng@nadar.com

PROJECT TYPE

2 STORY DWELLING W/ ATTACHED GARAGE

OWNER

JESSICA BRANDT

ADDRESS

SHOSHONE ST., OCEANSIDE, CA. 92083

SHEET TITLE

STANDARD STRUCTURAL DETAILS

CONTRACT DATE

4/5/2023

DATE

6/27/2025


DRAWN

MARIA G.





SHEET

SSD

June 27, 2025

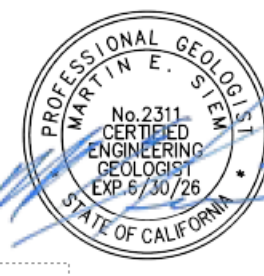

7-1-2025
Geotechnical information only

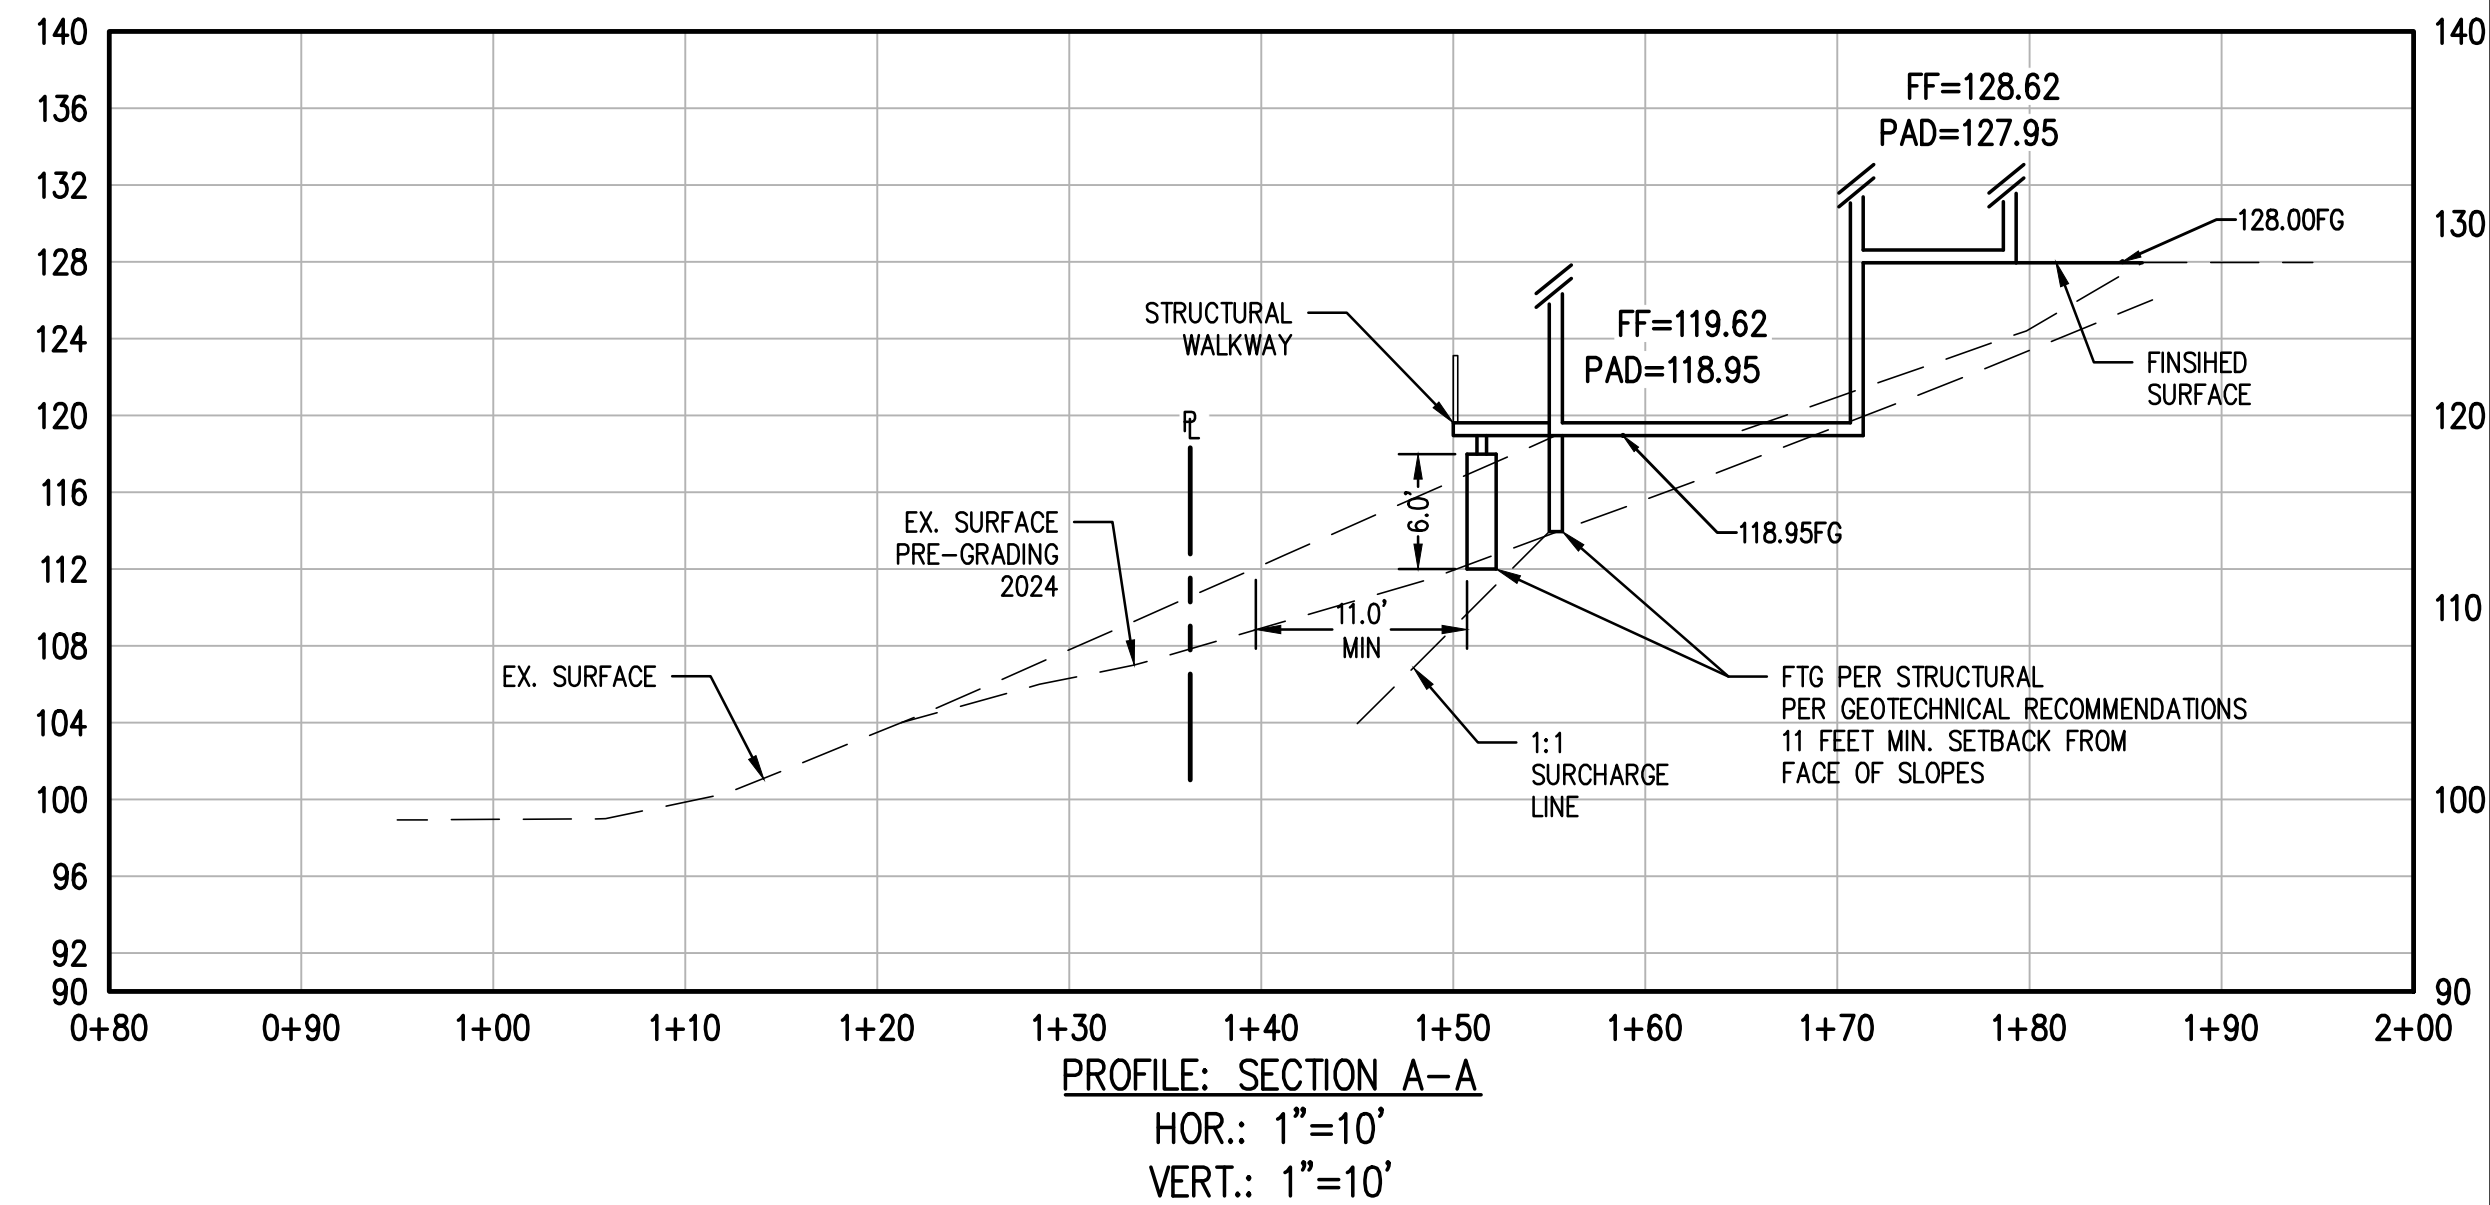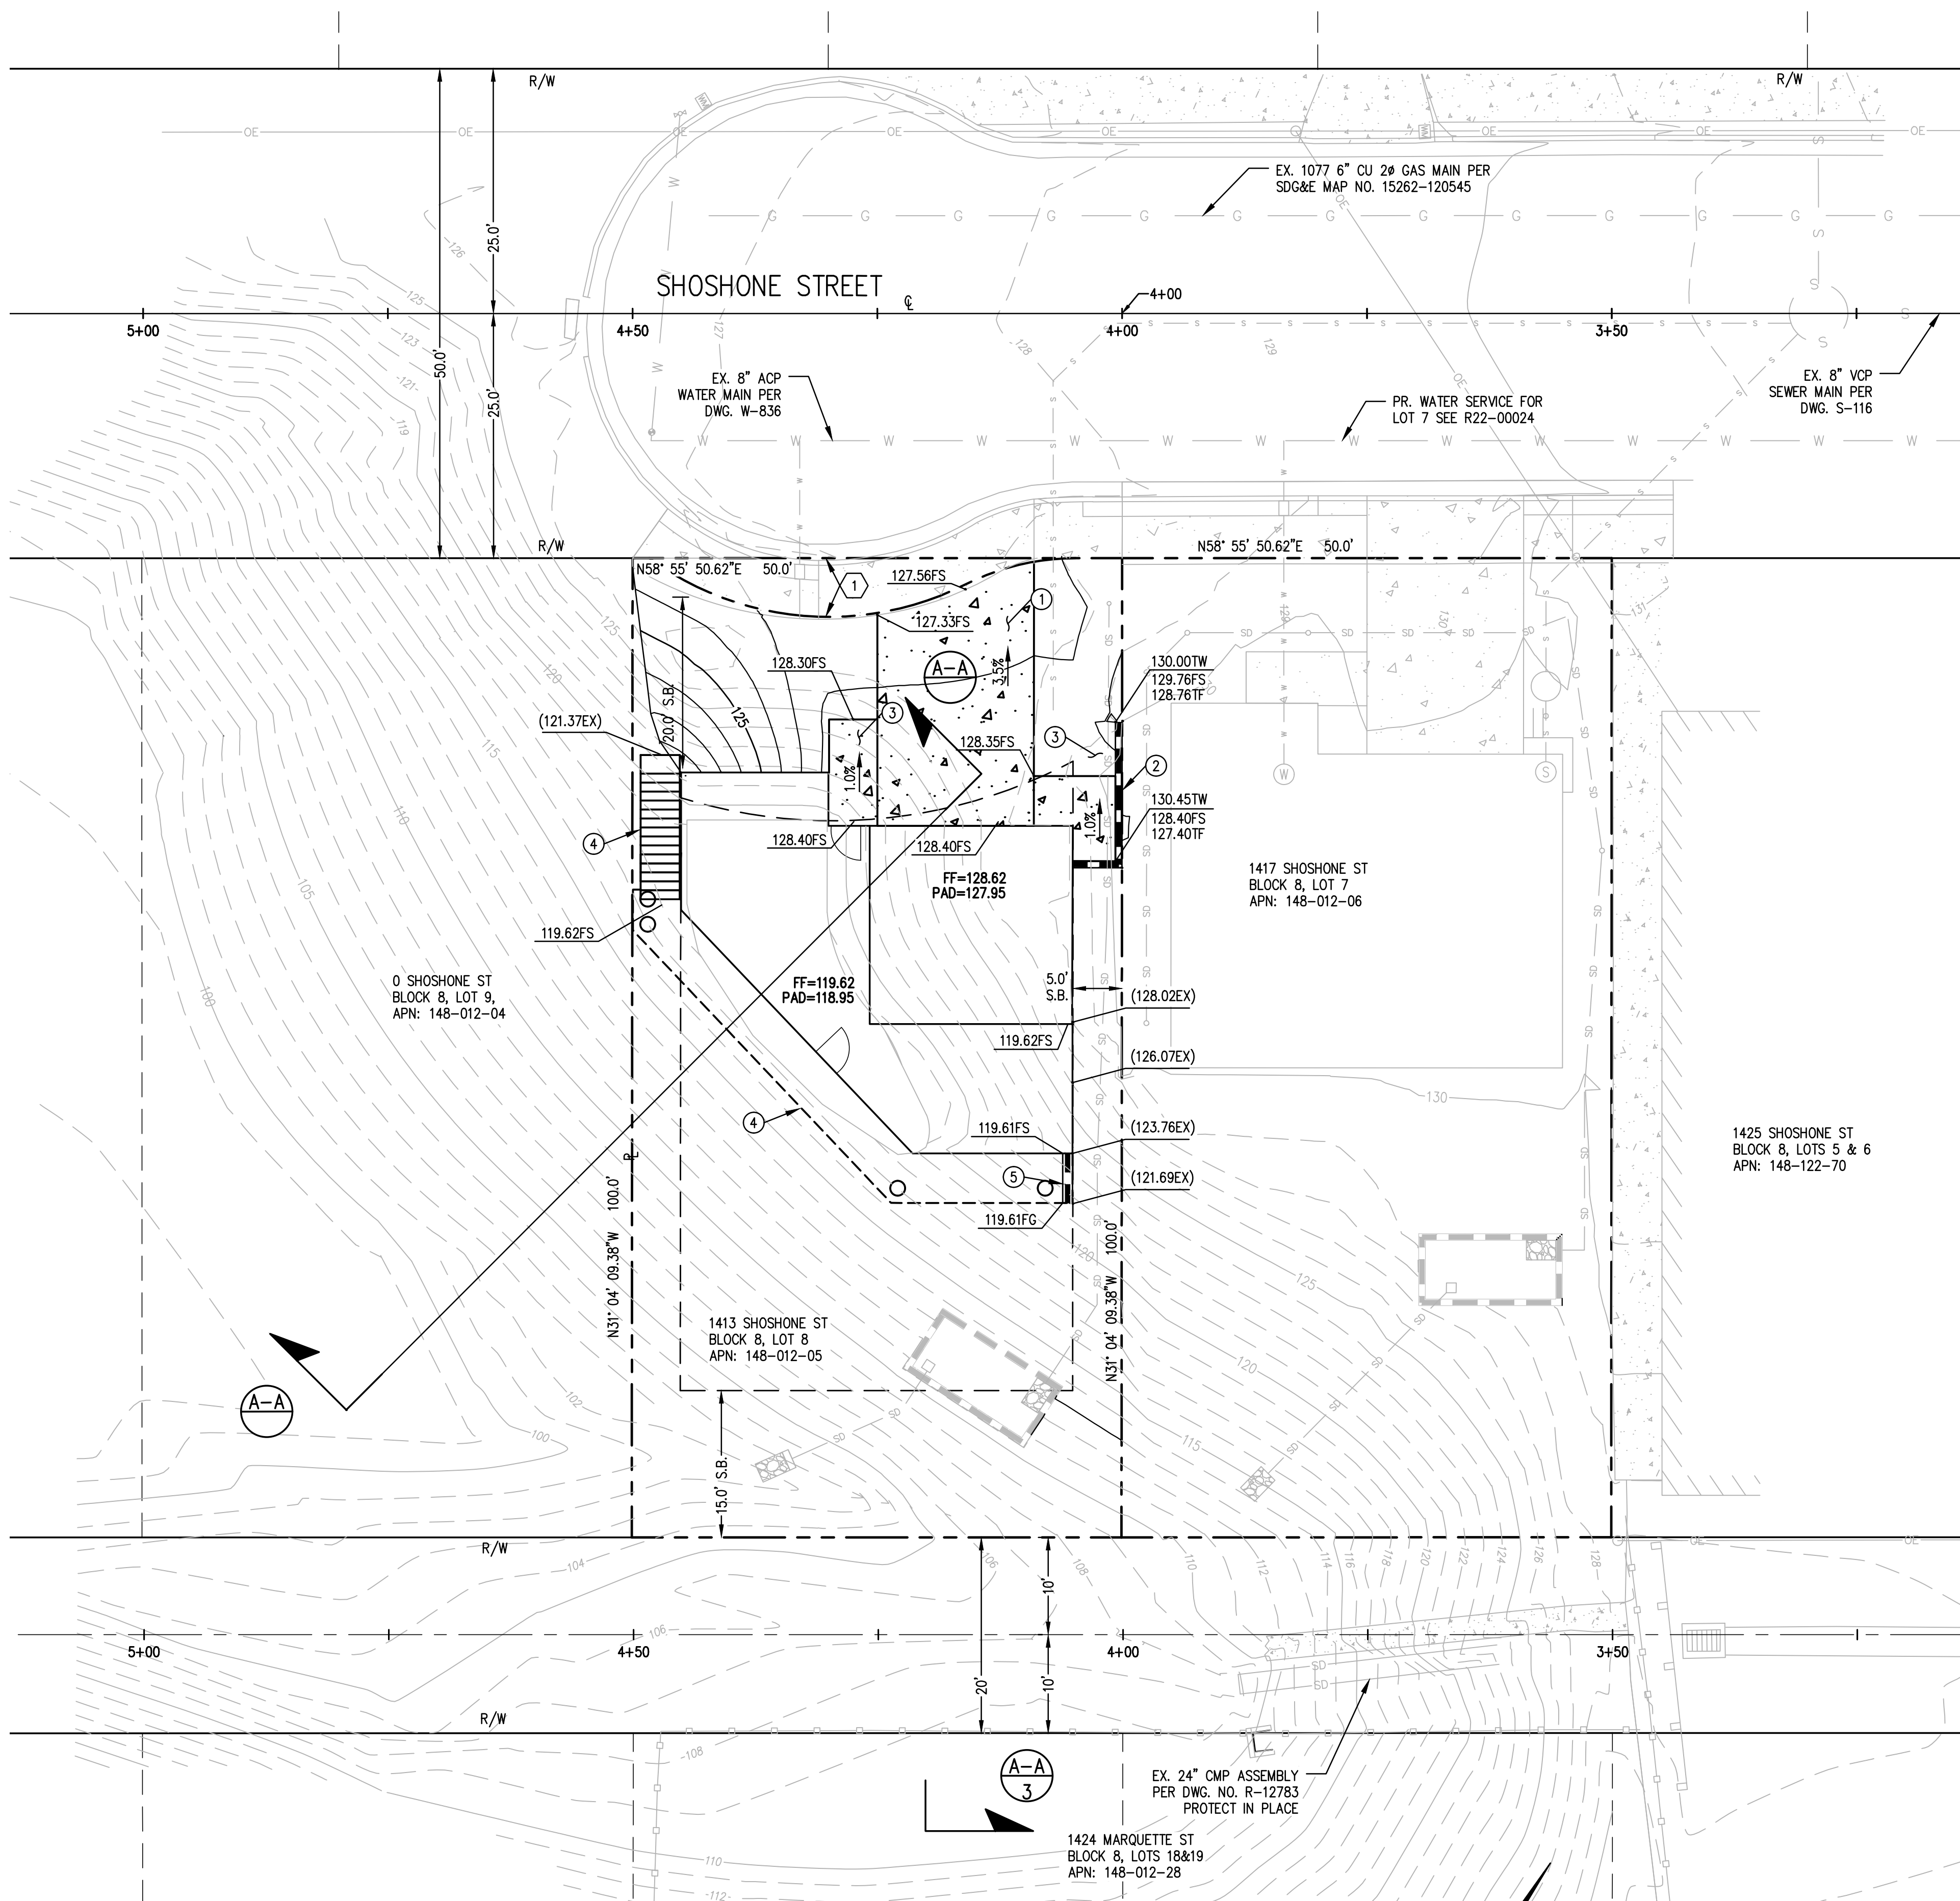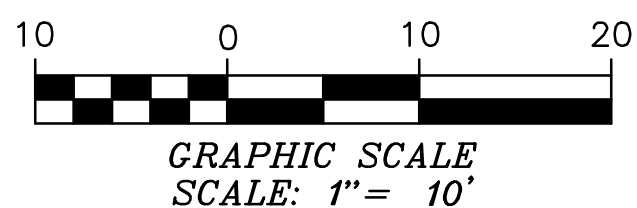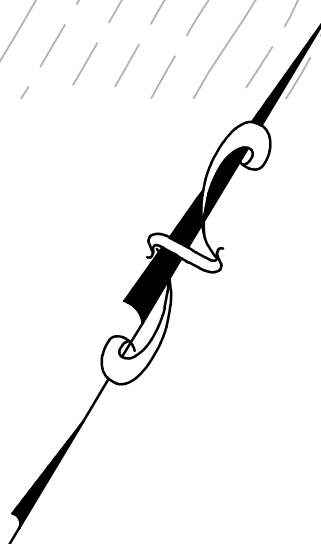

CONSTRUCTION NOTES:

1. CONSTRUCT CONCRETE DRIVEWAY (FOR CONFINED RIGHT-OF-WAY) PER SDRSD G-14D
2. CONSTRUCT MASONRY RETAINING WALL PER SDRSD C-06
3. CONSTRUCT 4" THICK CONCRETE SIDEWALK PER GEOTECHNICAL RECOMMENDATIONS
4. STRUCTURAL WALKWAY PER OTHERS
5. STRUCTURAL RETAINING WALL PER OTHERS

EASEMENT NOTES:

1. PROPOSED 6' R.O.W. DEDICATION

CAUTION!!

EXISTING UNDERGROUND UTILITIES AND FACILITIES SHOWN ON THESE PLANS HAVE BEEN OBTAINED FROM AVAILABLE RECORDS WHICH IN MOST CASES ARE SCHEMATIC PLANS. THESE PLANS MAY NOT REFLECT ALL EXISTING UTILITIES. EXACT LOCATION AND DEPTH OF EXISTING UTILITIES ARE UNKNOWN. SUBCONTRACTOR TO CONFIRM THE LOCATIONS OF ALL EXISTING UTILITIES PRIOR TO START OF WORK, AND NOTIFY ENGINEER OF WORK OF ANY DISCREPANCIES.